


SEE 18-00-020-A

SEE 18-B

20

ANNEXATION
Ord. # 1973-51
10-1-73

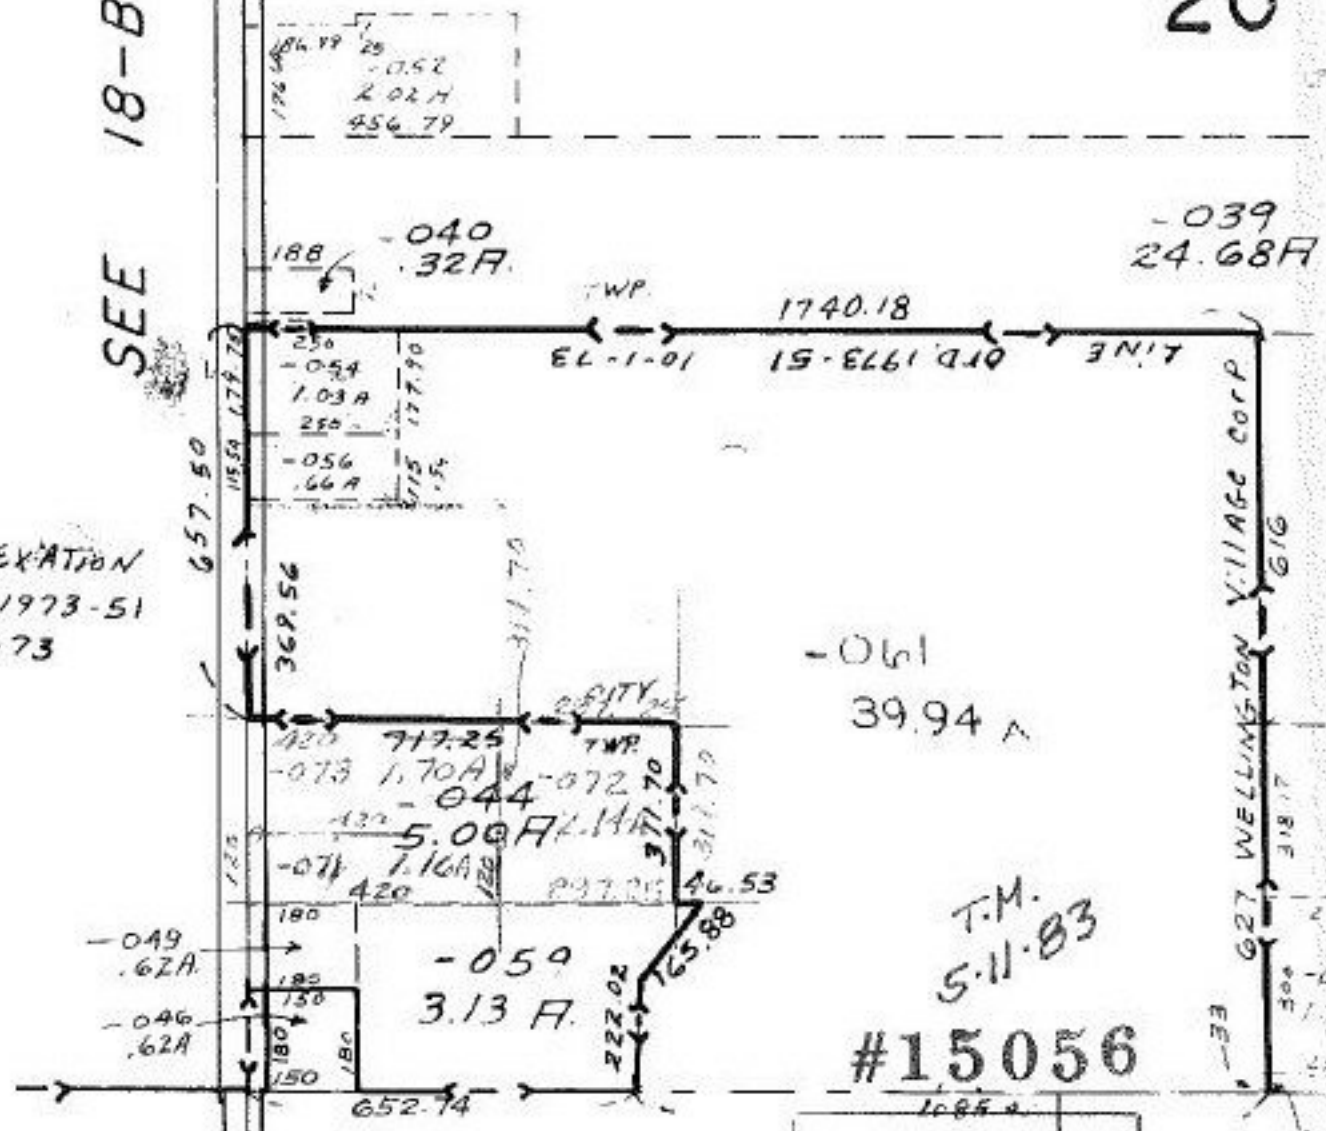

T.M.
5-11-83
#15056

APPROVED
LORAIN CO.
MAP DEPT.
DATE 4-21-83
PAGE 13-C
BY C. F. ...
VOID AFTER

221