

17  
77A

18  
77A


19  
77A

20  
77A

21  
77A

00

51  
33  
87A

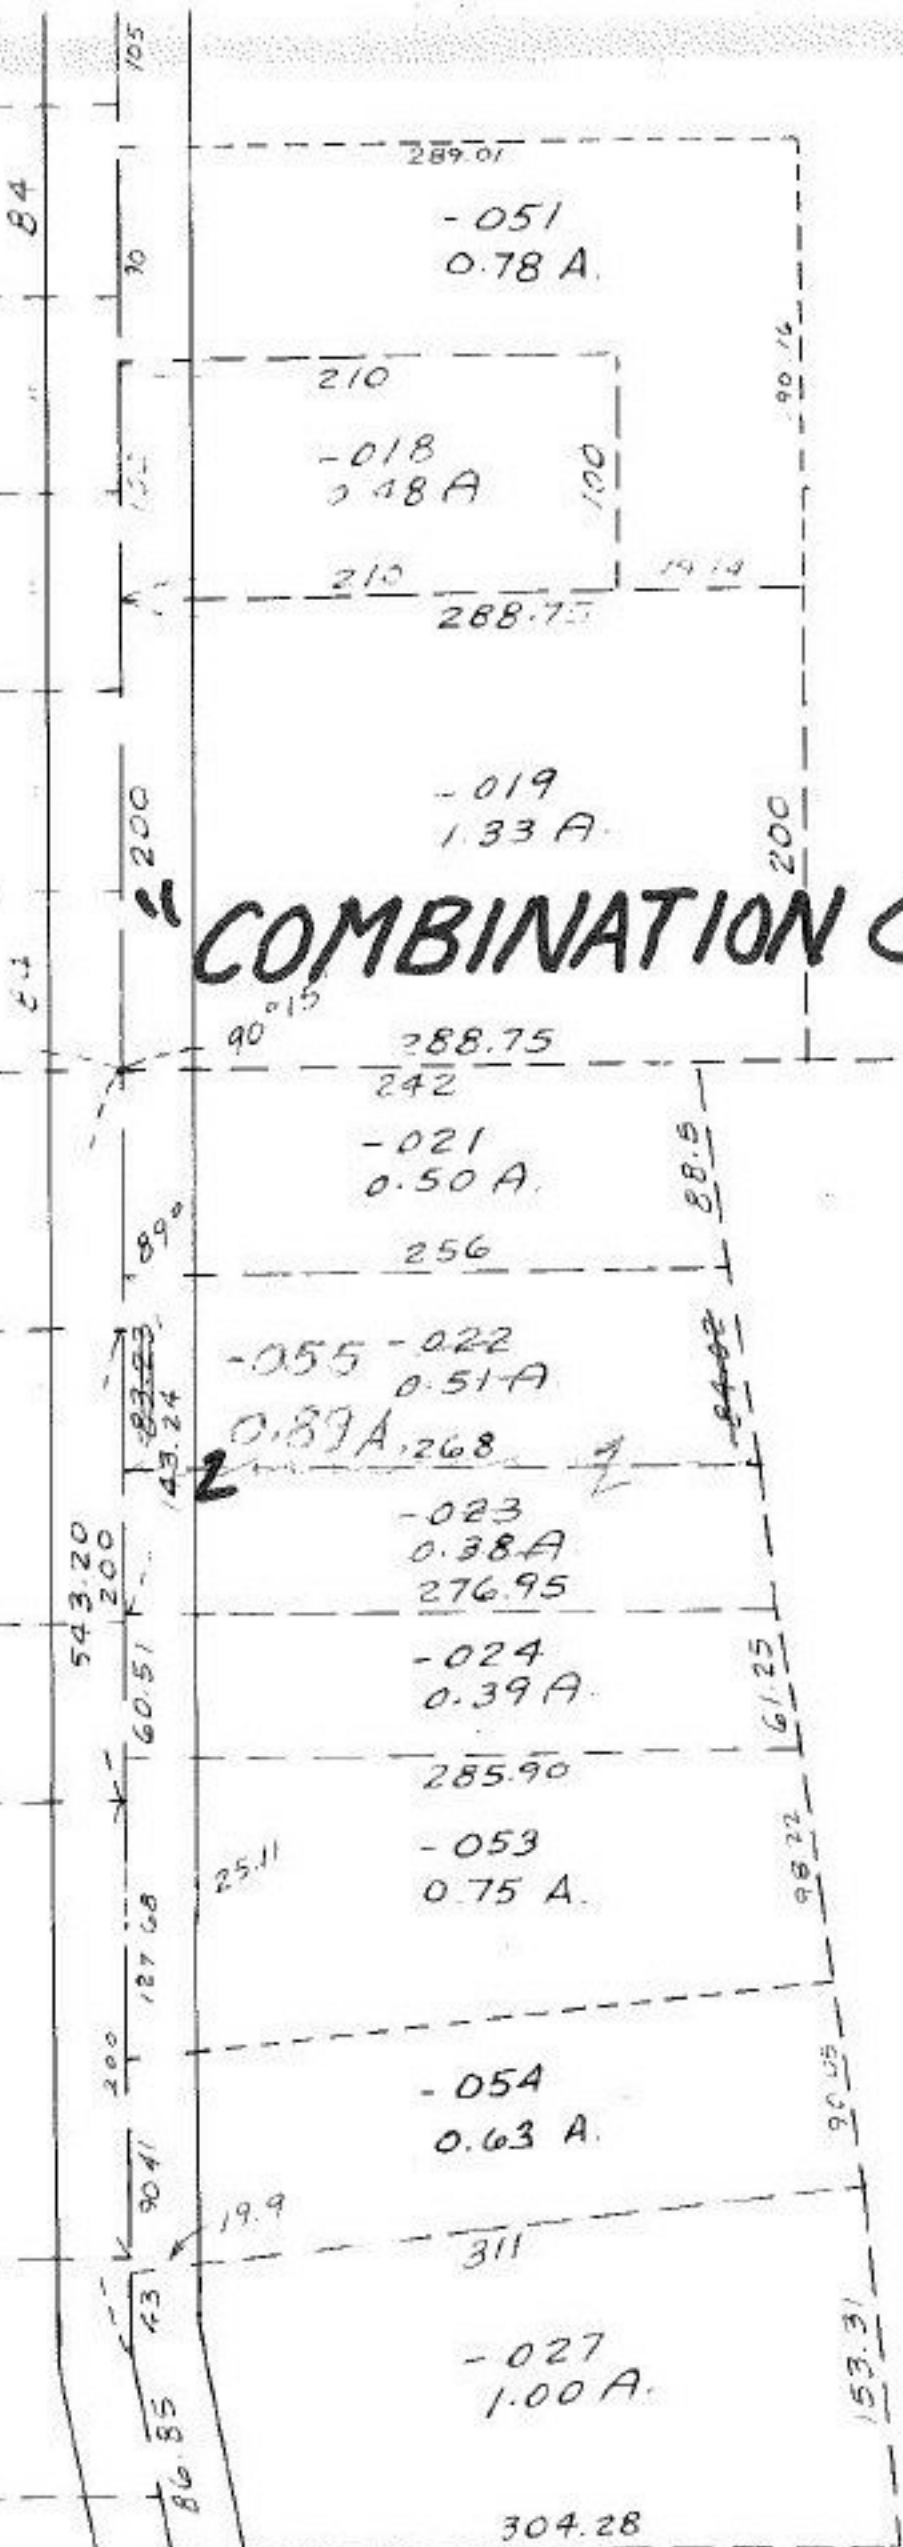

**"COMBINATION ONLY"**

#15058

6-3-83  
*[Signature]*

APPROVED LORAIN CO. MAP DEPT.	
DATE 4-18-83	
PAGE 7-11-0451	
BY C. Francis	
VOID AFTER	

