


4/E
Come to 68th St

520-5

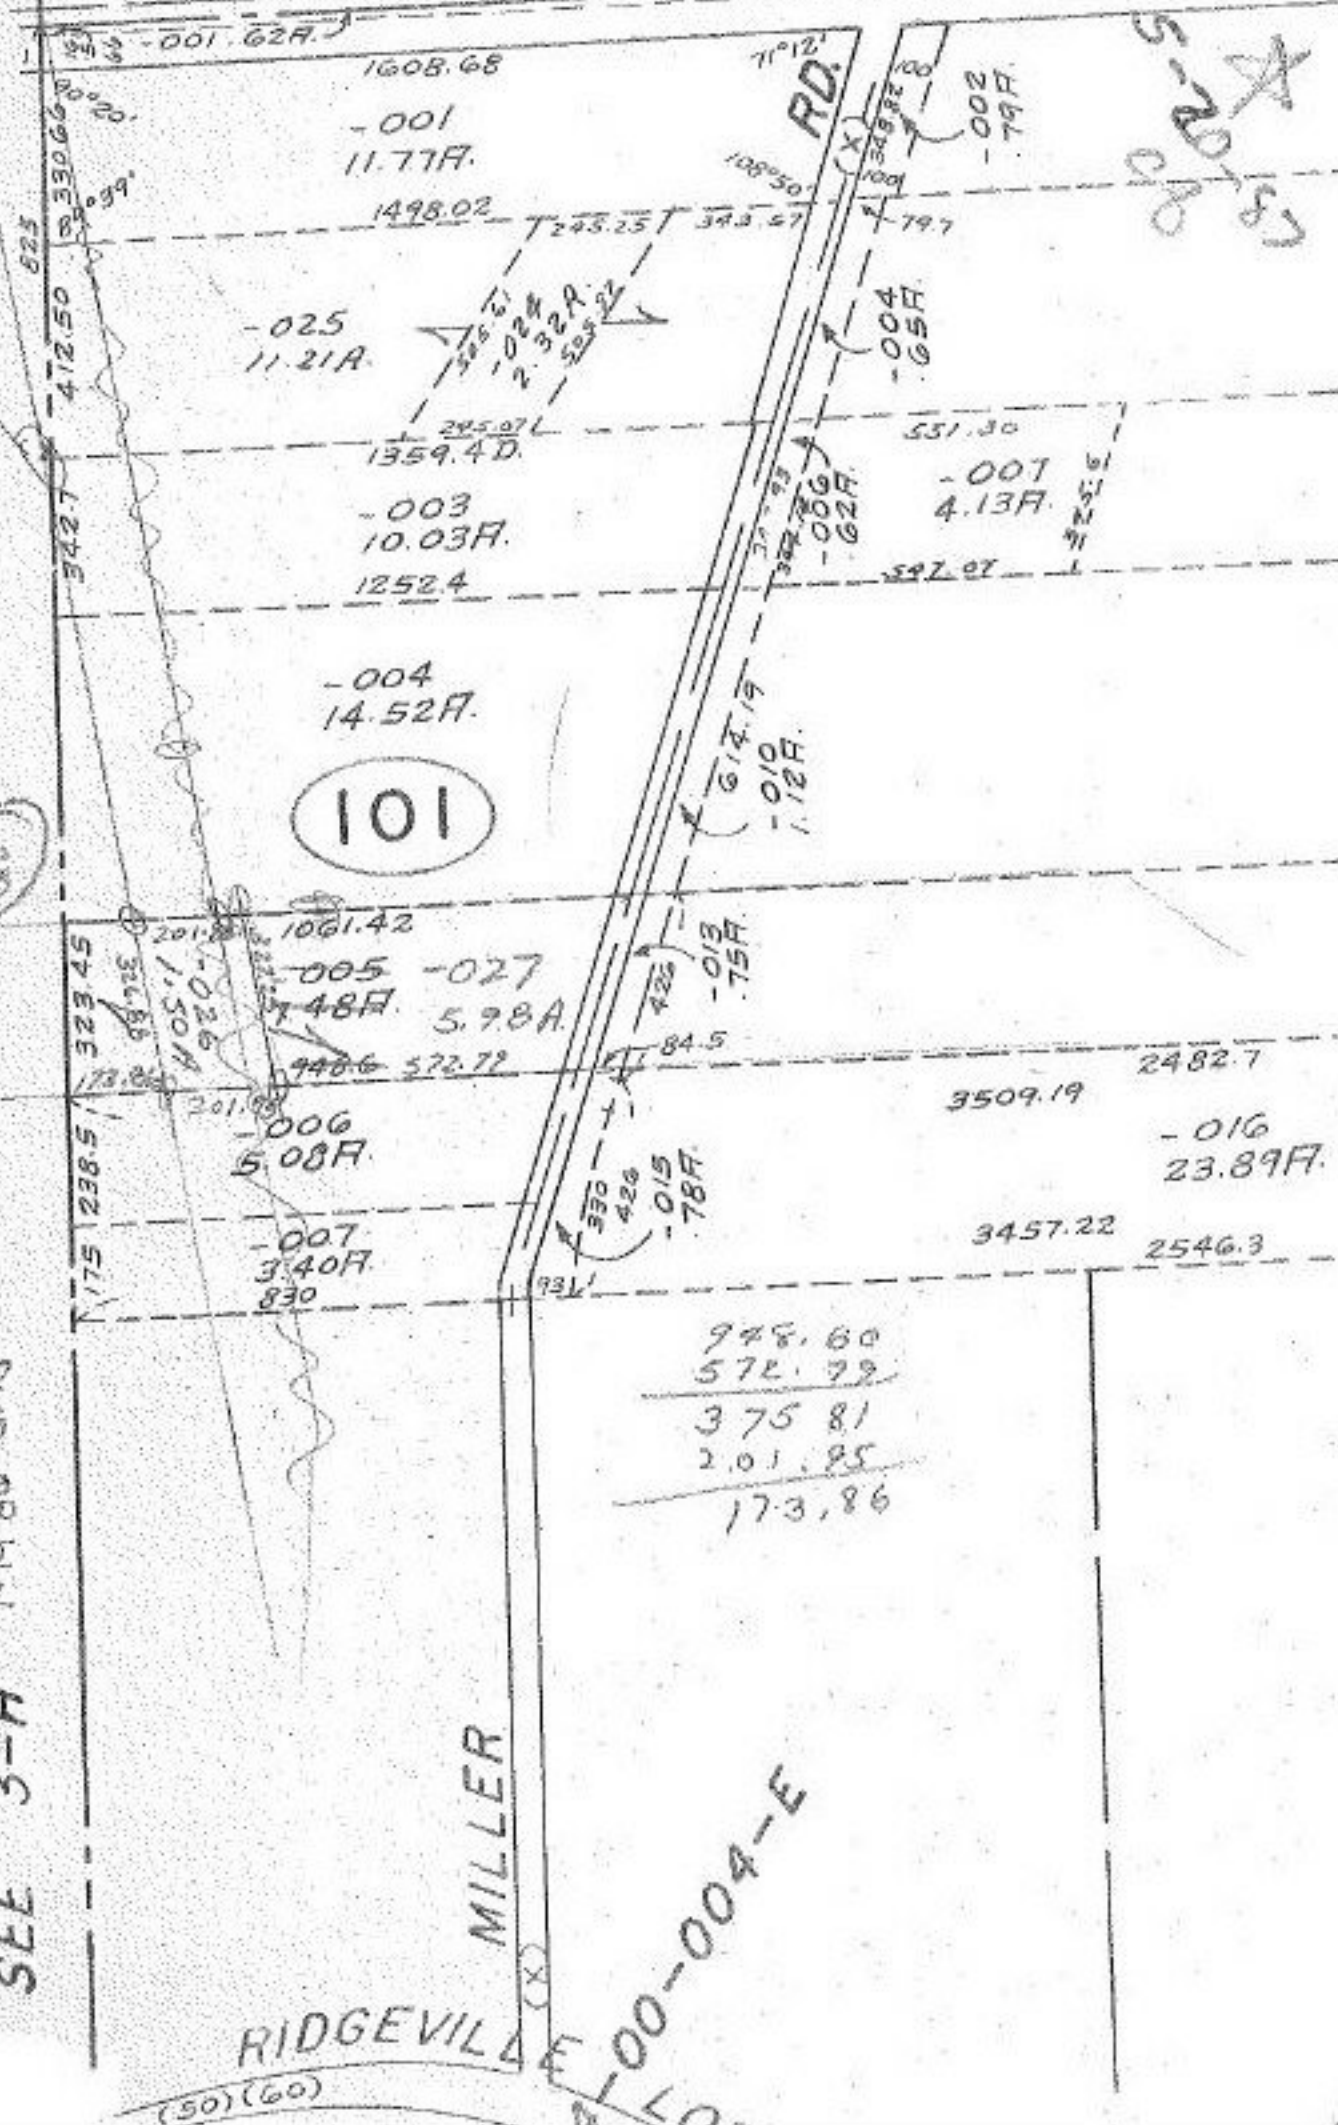

101

APPROVED
 LORAIN CO.
 MAP DEPT.
 DATE 7-22-68
 # 1507
 BY *[Signature]*

SEE 3-H 7-14-86

948.60
572.79
375.81
201.85
173.86

MILLER RD.
RIDGEVILLE ST.
A-00-004-E
LORAIN CO.