
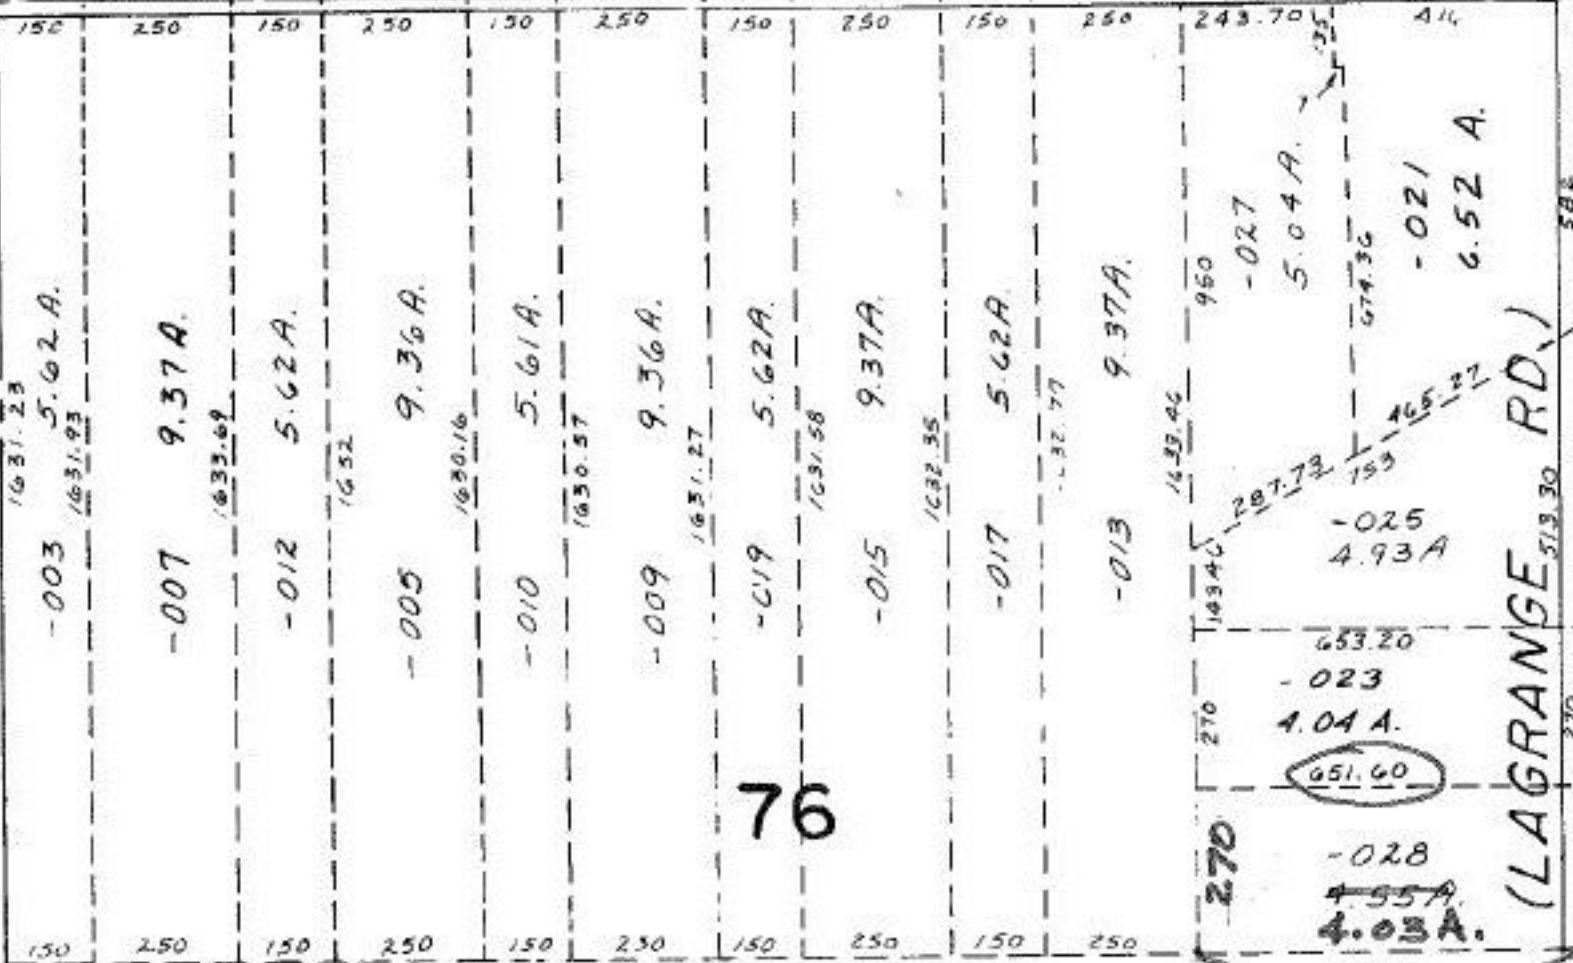


SEE

SEE

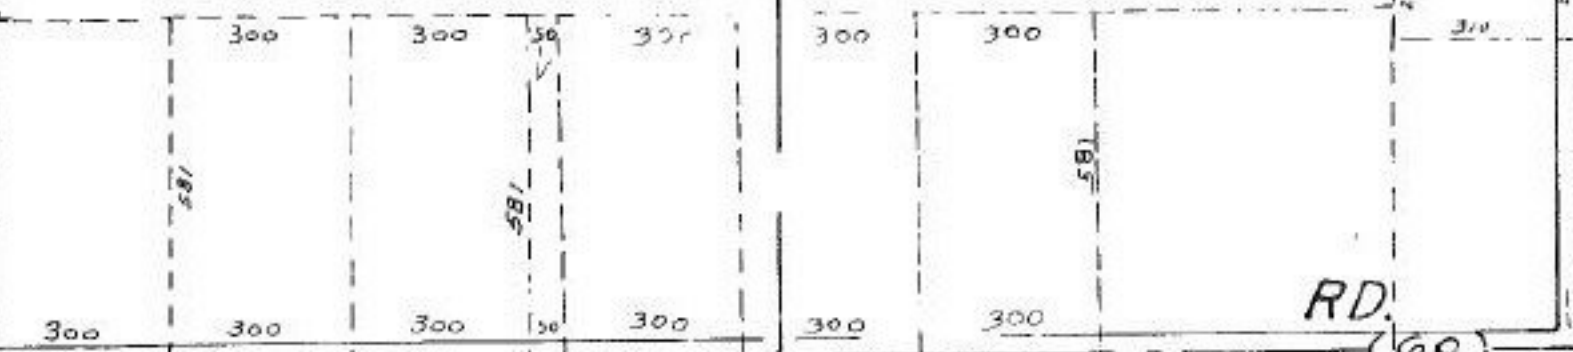

Average Correction
Per Deed Being Recorded.

-002
66.66 A.

5-23-83
[Signature]

-001
50.00 A.

#15072

APPROVED LORAIN CO. MAP DEPT.	
DATE 4-27-83	
PAGE 15-F	
BY	<i>[Signature]</i>
VOID AFTER	15072

2
A

270