

500 Pt-001 01755A

1128.55

87°41'

813
597
606

1362

475

Pt. -09Z
~~Pt. -013~~
~~Pt. 21.63A~~
Pt. 19.77A.

Change Line →



012

1.62A

295.42

101


2051.28

1441.20

Pt. -014
Pt. 10.75A

APPROVED
LORAIN CO.
MAP DEPT.
DATE 1-23-68
1509
BY <i>Holler</i>

7-14-86 smg

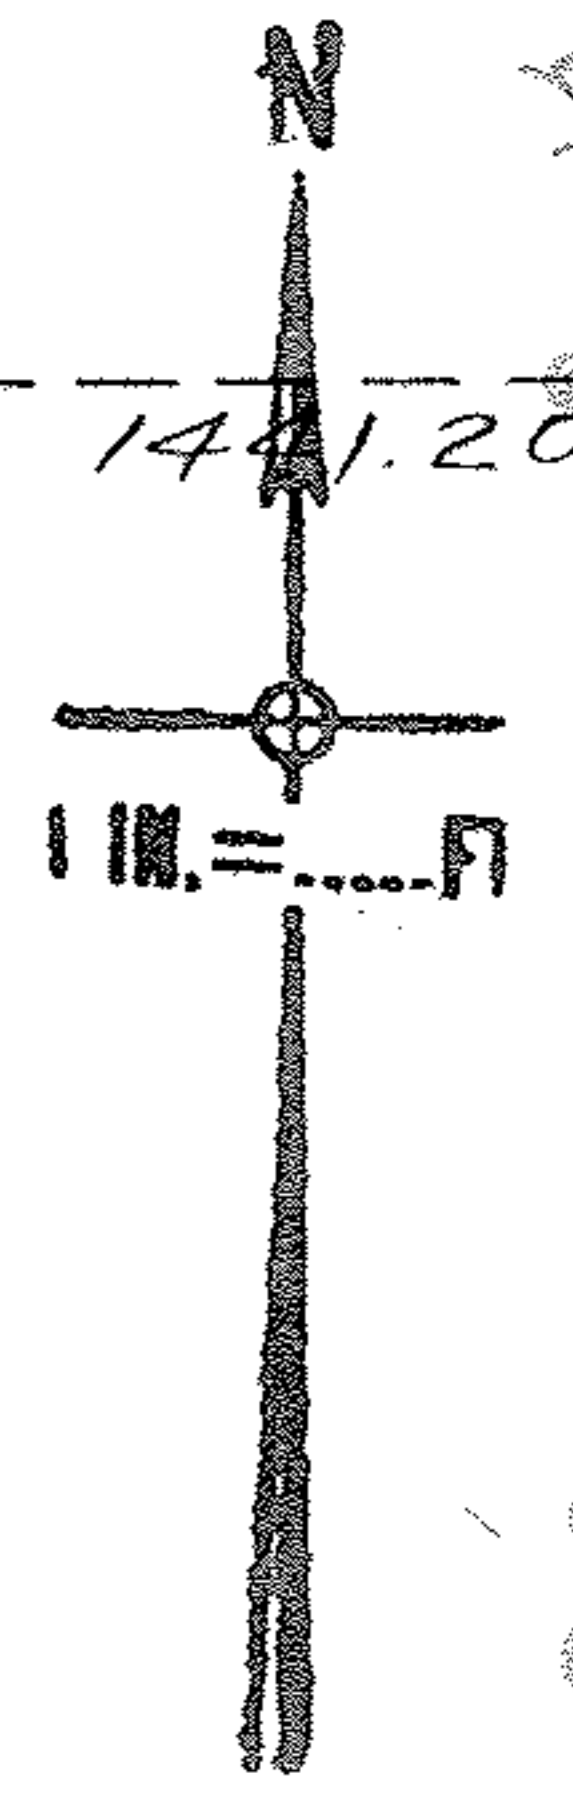

PG 4-00-00277-B

1635.16

59.19
6