


SEE 5-00-016-B

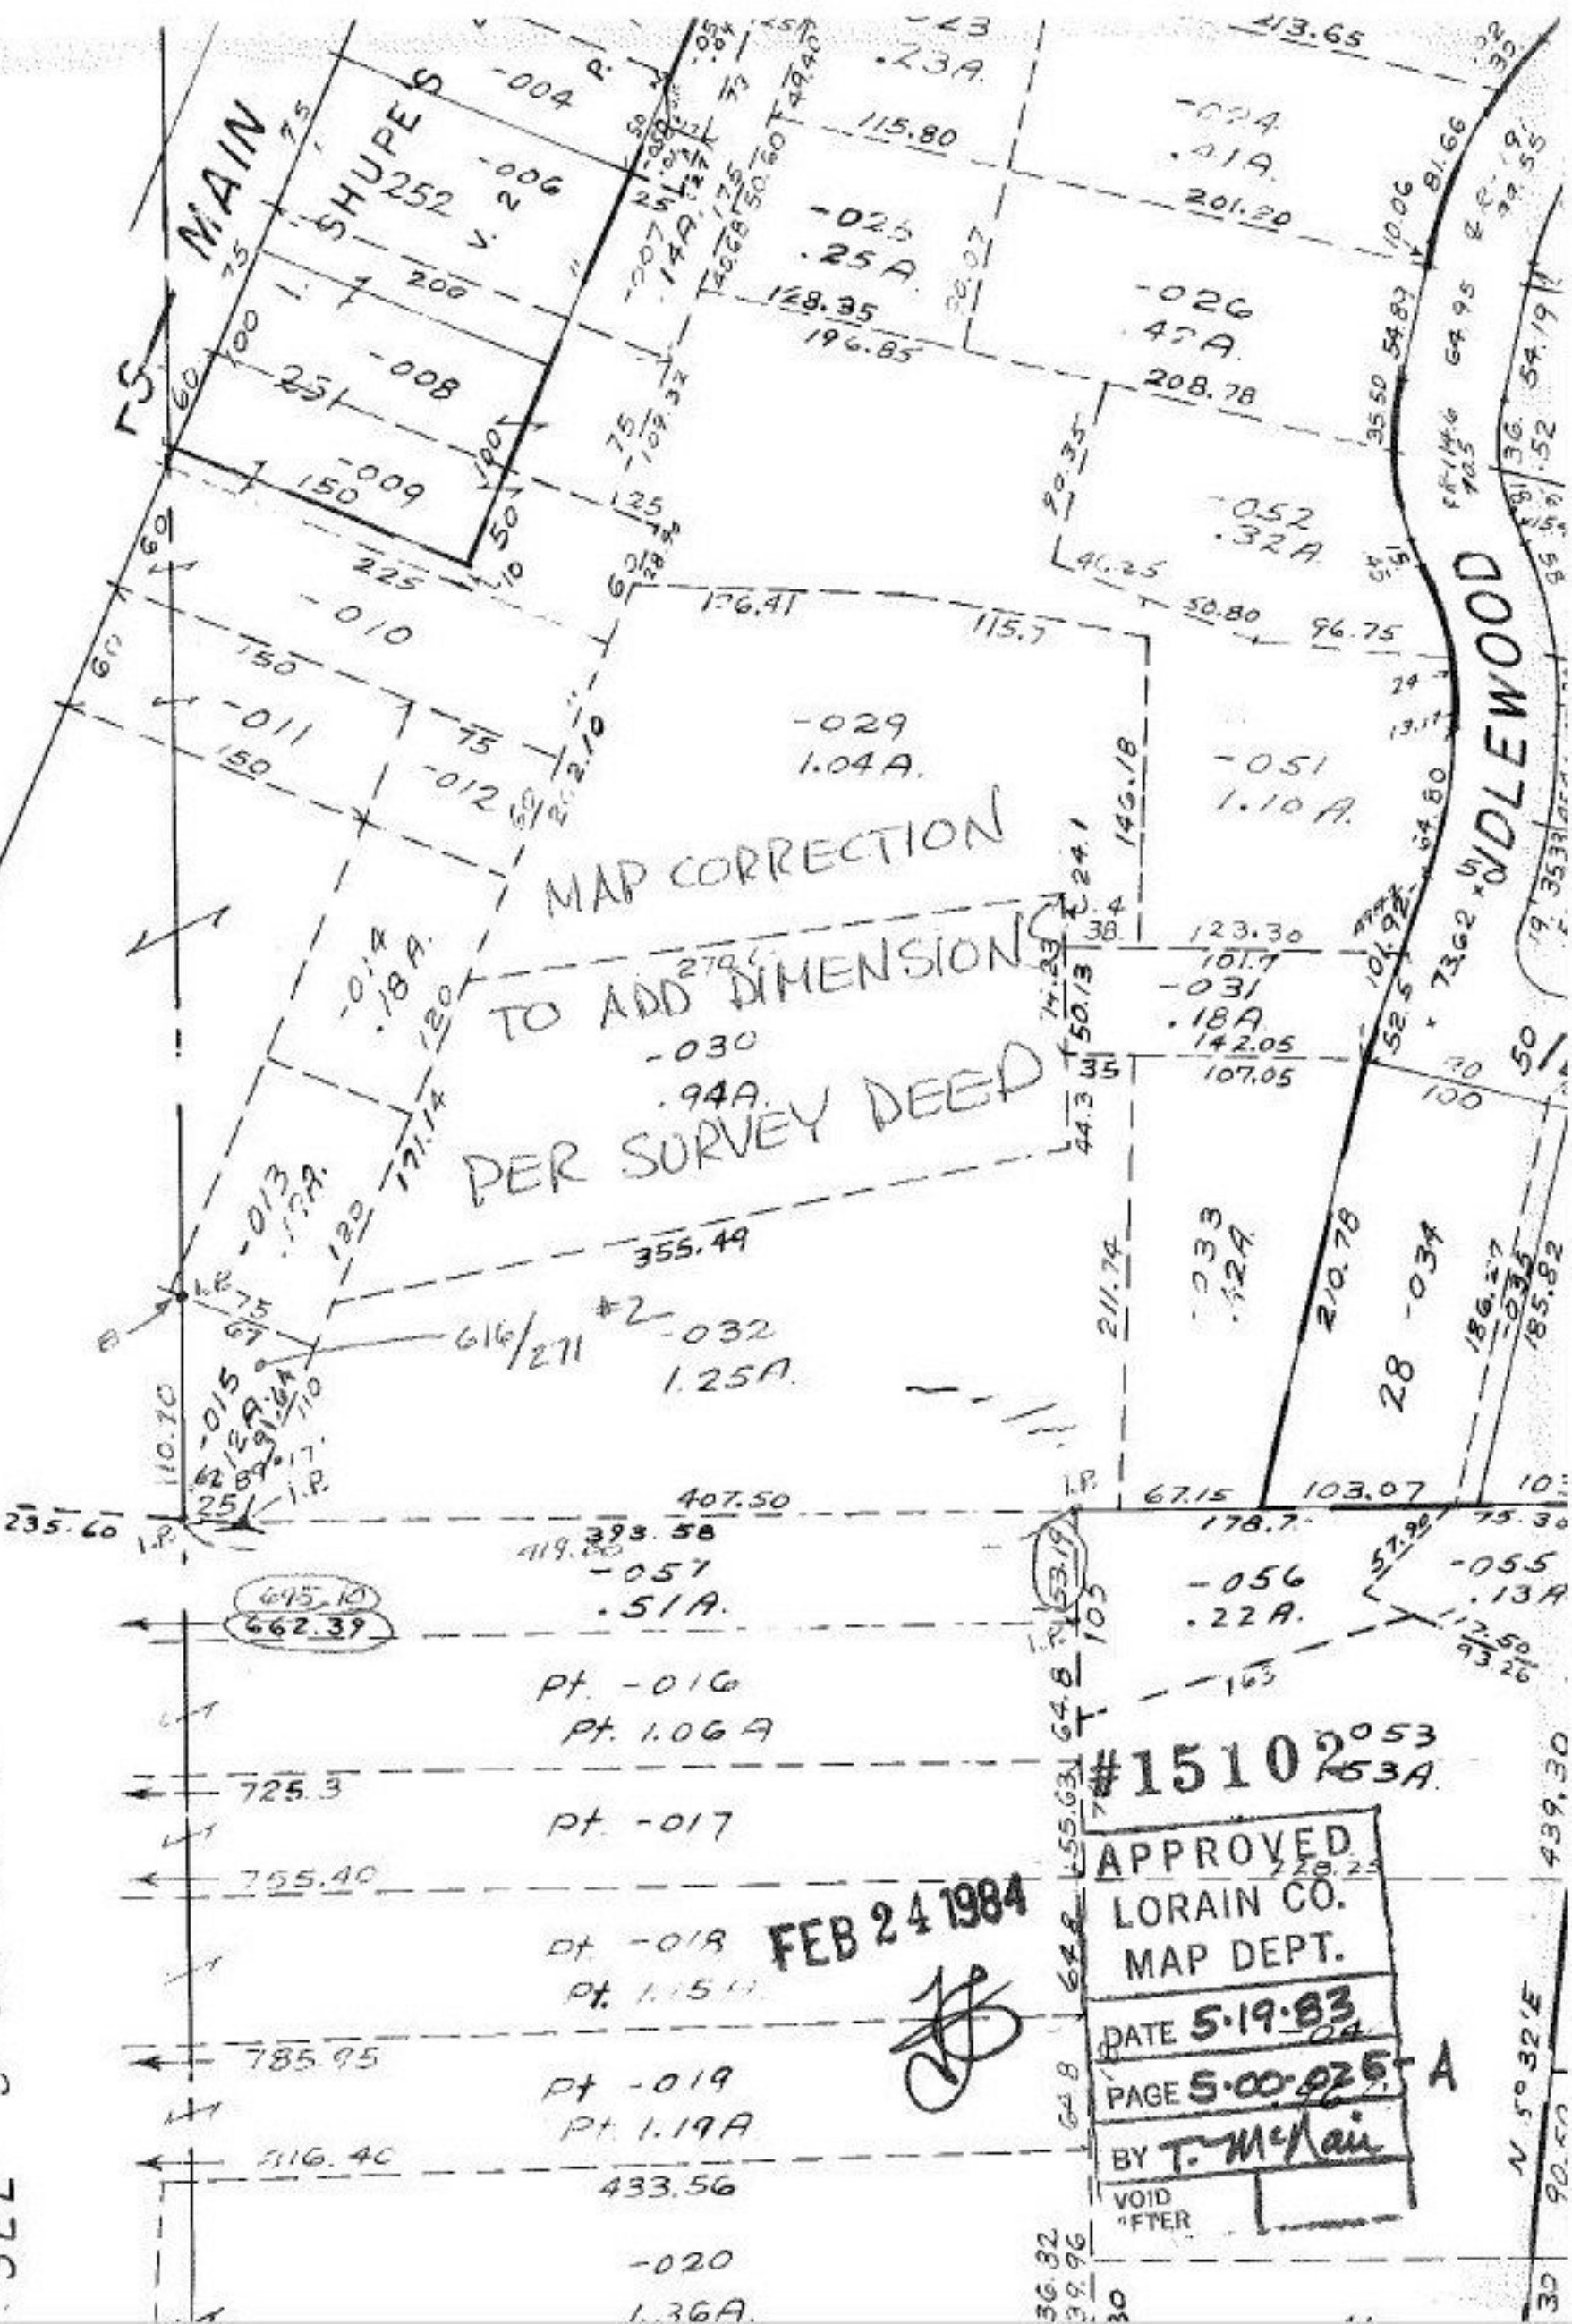

FEB 24 1984

[Handwritten Signature]

#15102053
 53A

APPROVED
 LORAIN CO.
 MAP DEPT.

DATE 5-19-83

PAGE 5-00-025 A

BY T. McNeil

VOID
 AFTER

N 50° 32' E