


SEE 4-00

SEE 4-00-0

"Acreages Correction ONLY"

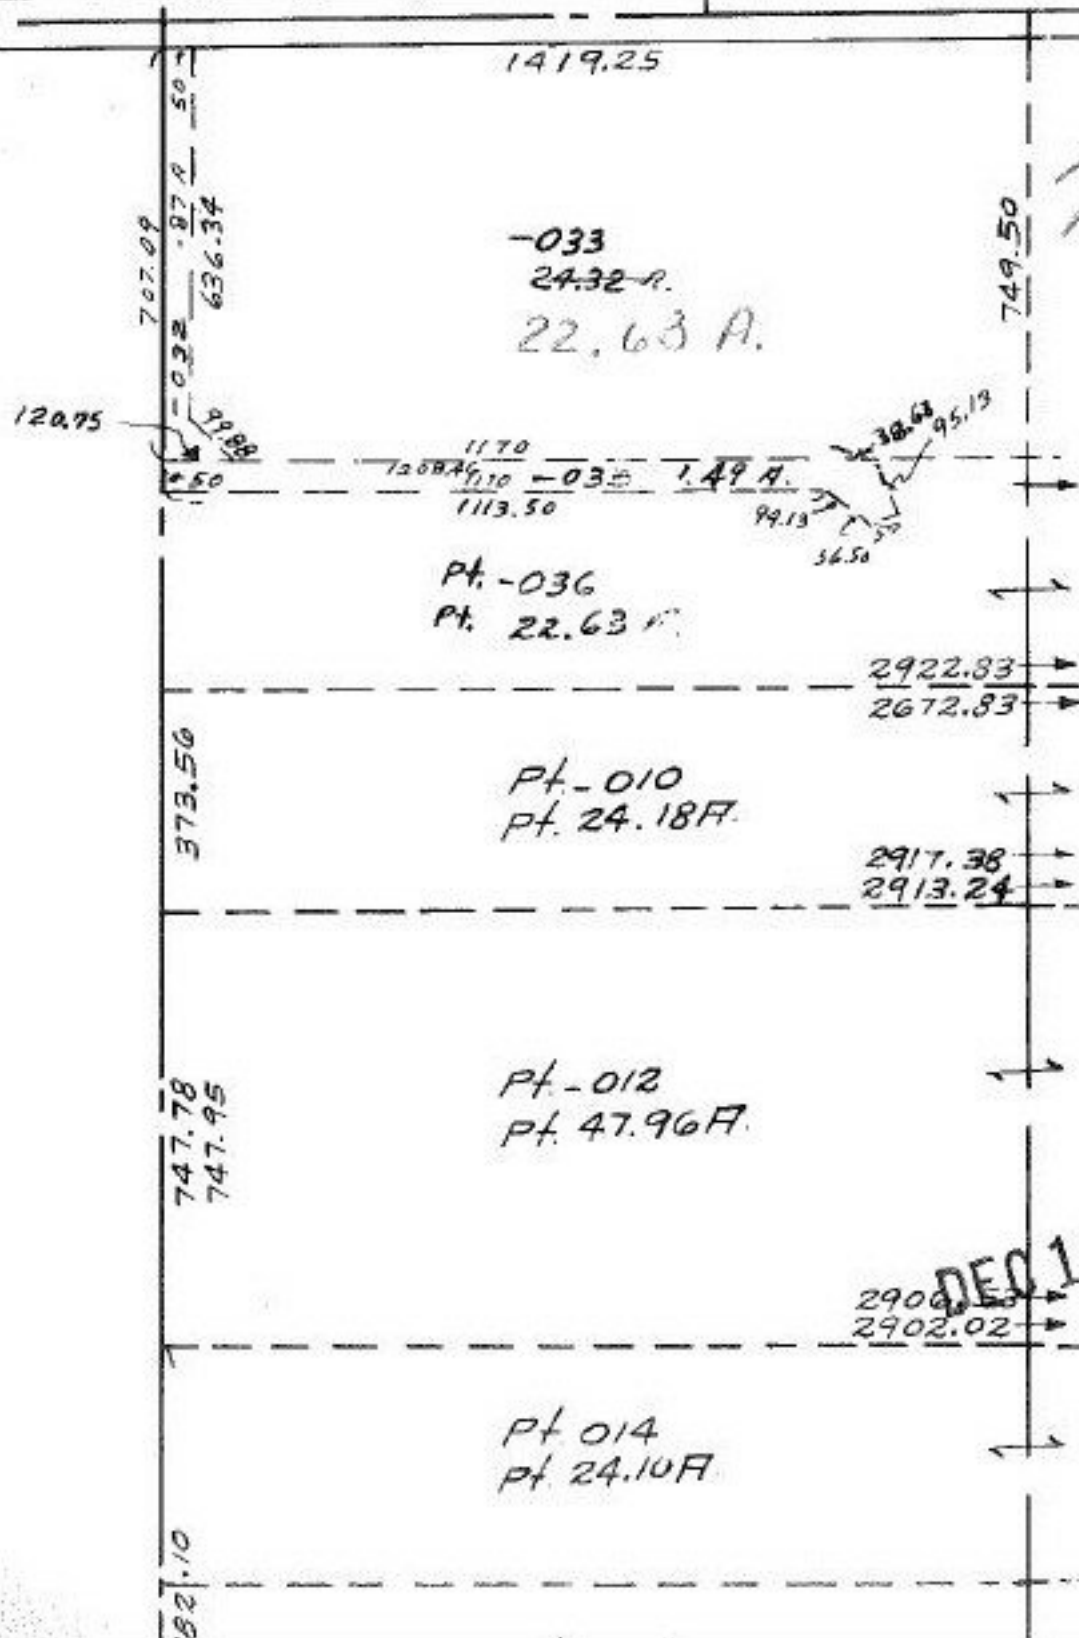

Acreages Correction
Per Deed VOL 350/506

4-00-020-B

SEE #15103

DEC 15 1983

APPROVED LORAIN CO. MAP DEPT.
DATE 5-24-83
PAGE 4-c
BY C. FRANCIS
VOID