


RD. NO. 6

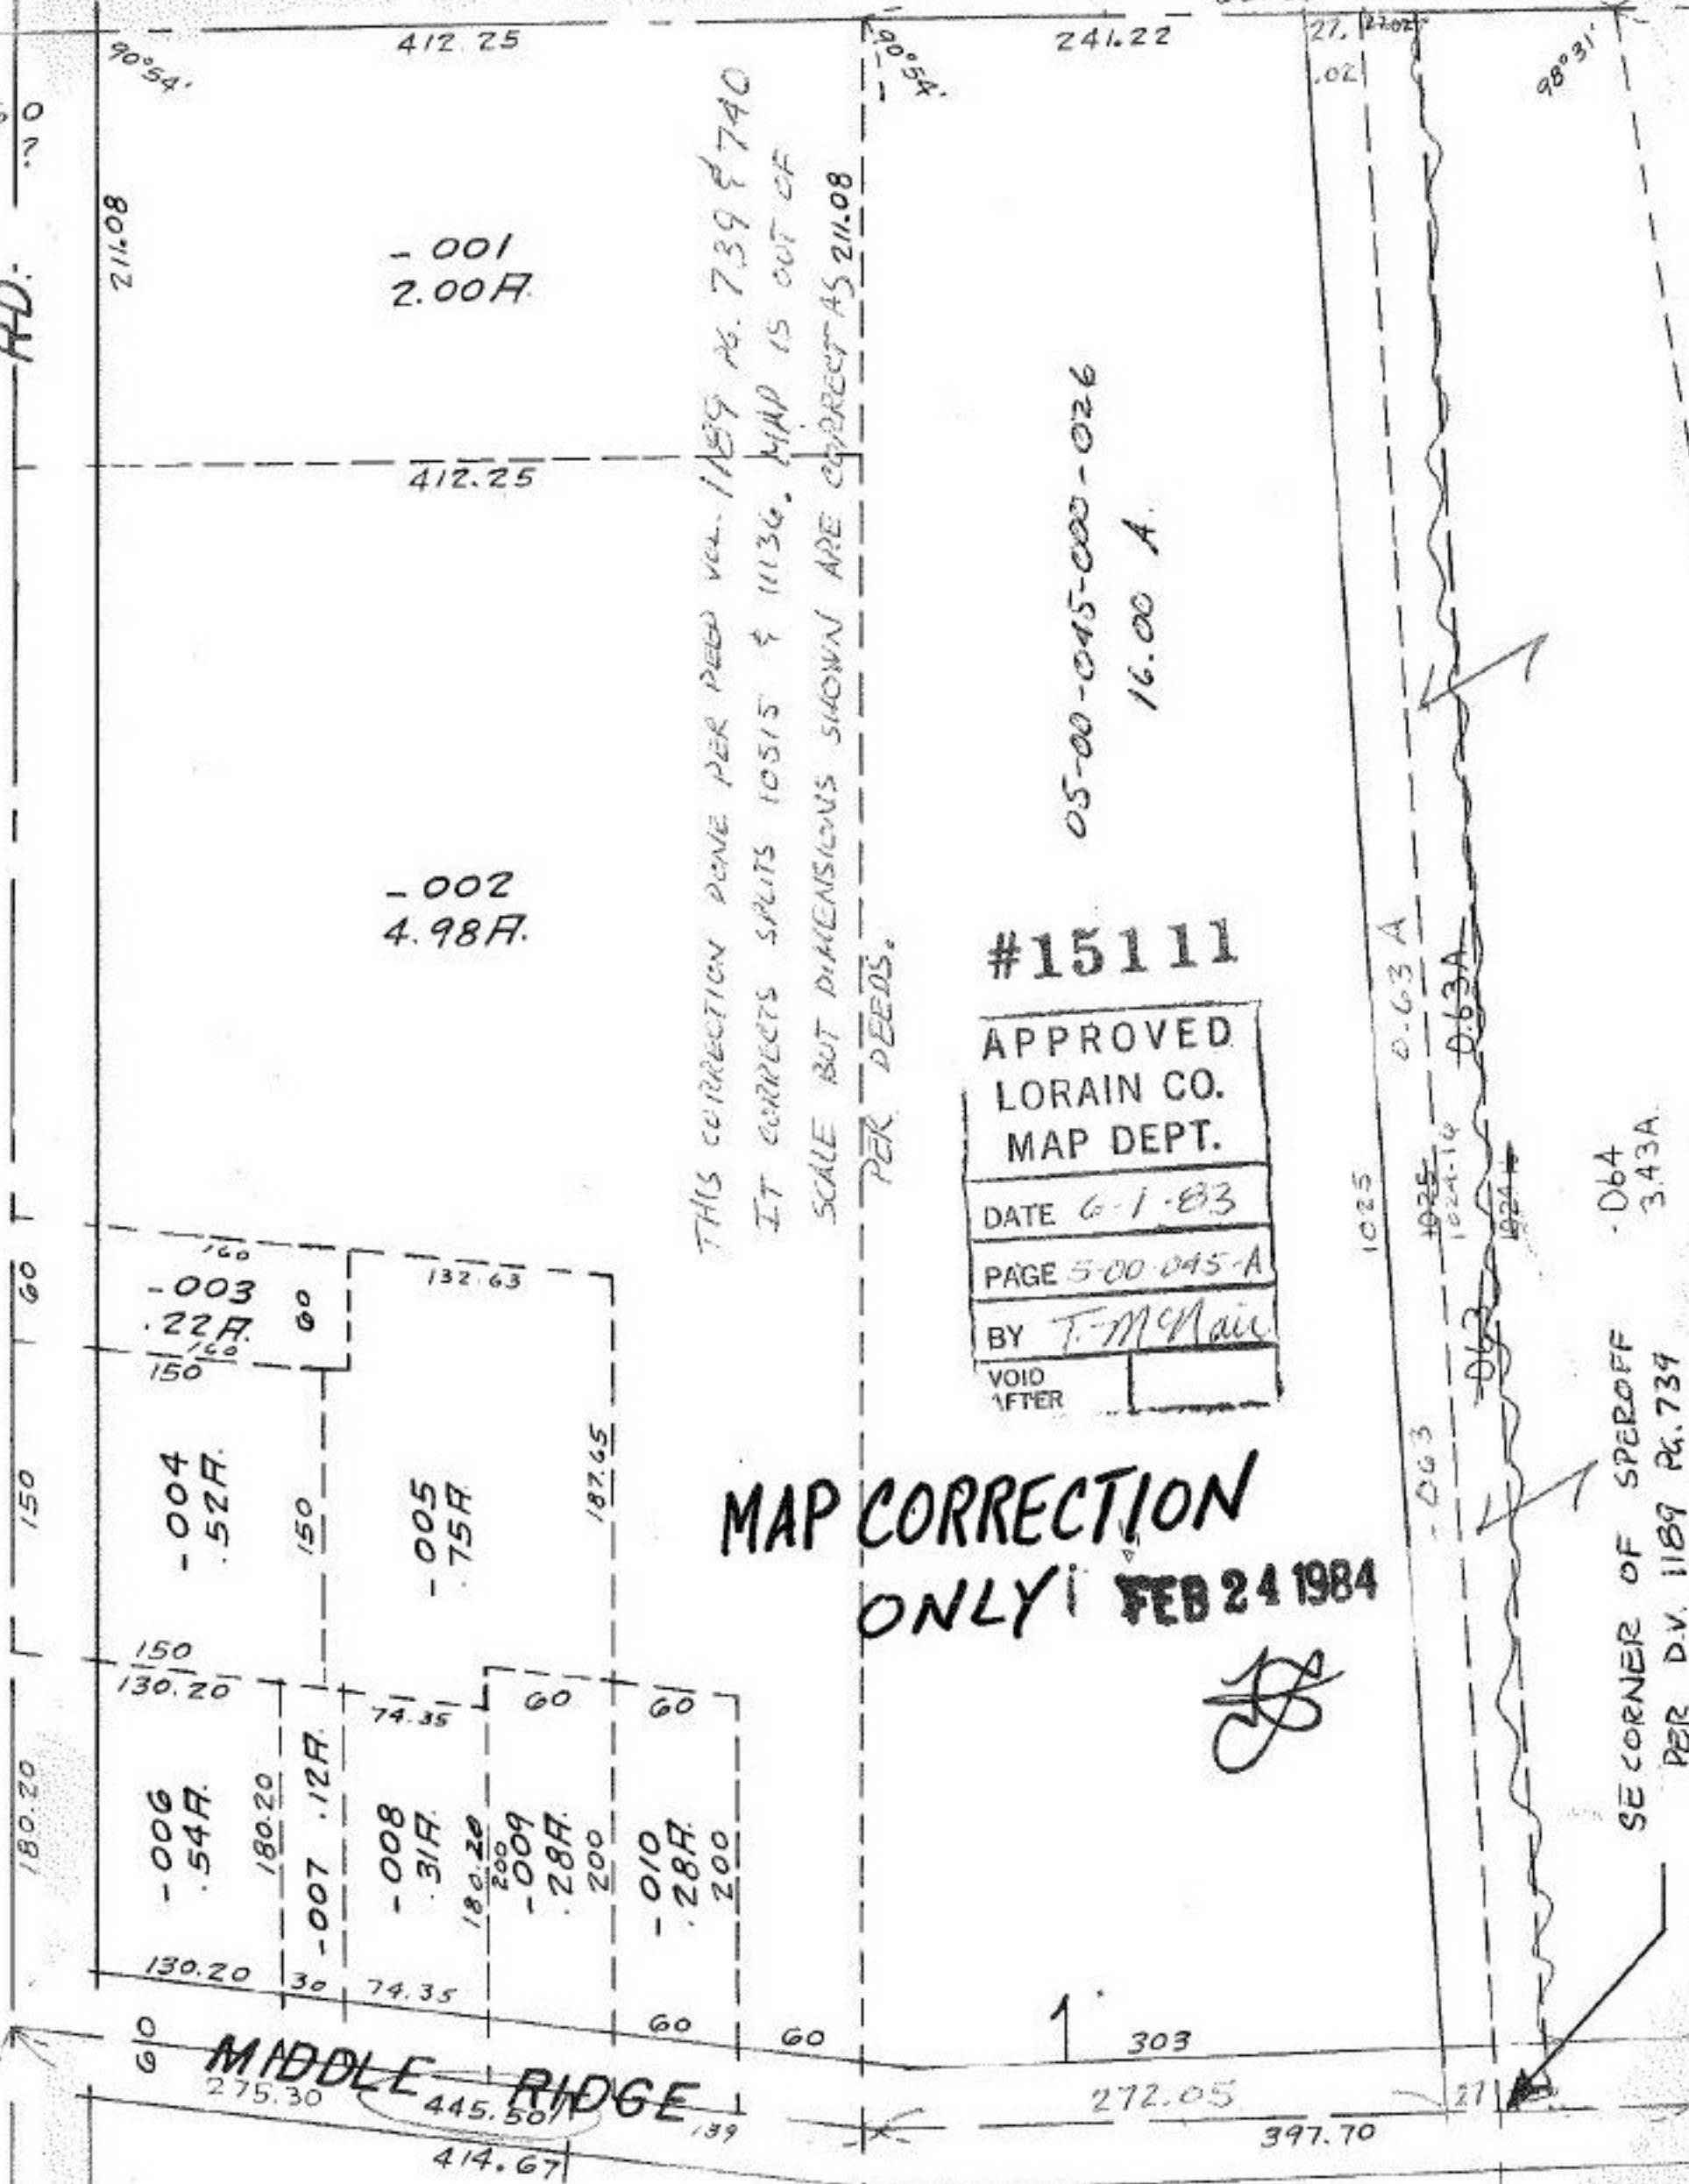

- 001
2.00 F.

- 002
4.98 F.

- 003
.22 F.

- 004
.52 F.

- 005
.75 F.

- 006
.54 F.

- 007
.12 F.

- 008
.31 F.

- 009
.28 F.

- 010
.28 F.

200
200

MIDDLE RIDGE

THIS CORRECTION DONE PER P.E.D. VOL. 1189 PG. 739 & 740
IT CORRECTS SPLITS 10515 & 11136. MAP IS OUT OF
SCALE BUT DIMENSIONS SHOWN ARE CORRECT AS 211.08
PER DEEDS.

#15111

APPROVED
LORAIN CO.
MAP DEPT.

DATE 6-1-83

PAGE 5-00-045-A

BY T. McMain

VOID
AFTER

MAP CORRECTION
ONLY! FEB 24 1984

05-00-045-000-026
16.00 A.

064
3.43A

SE CORNER OF SPEROFF
PER D.V. 1189 PG. 739