
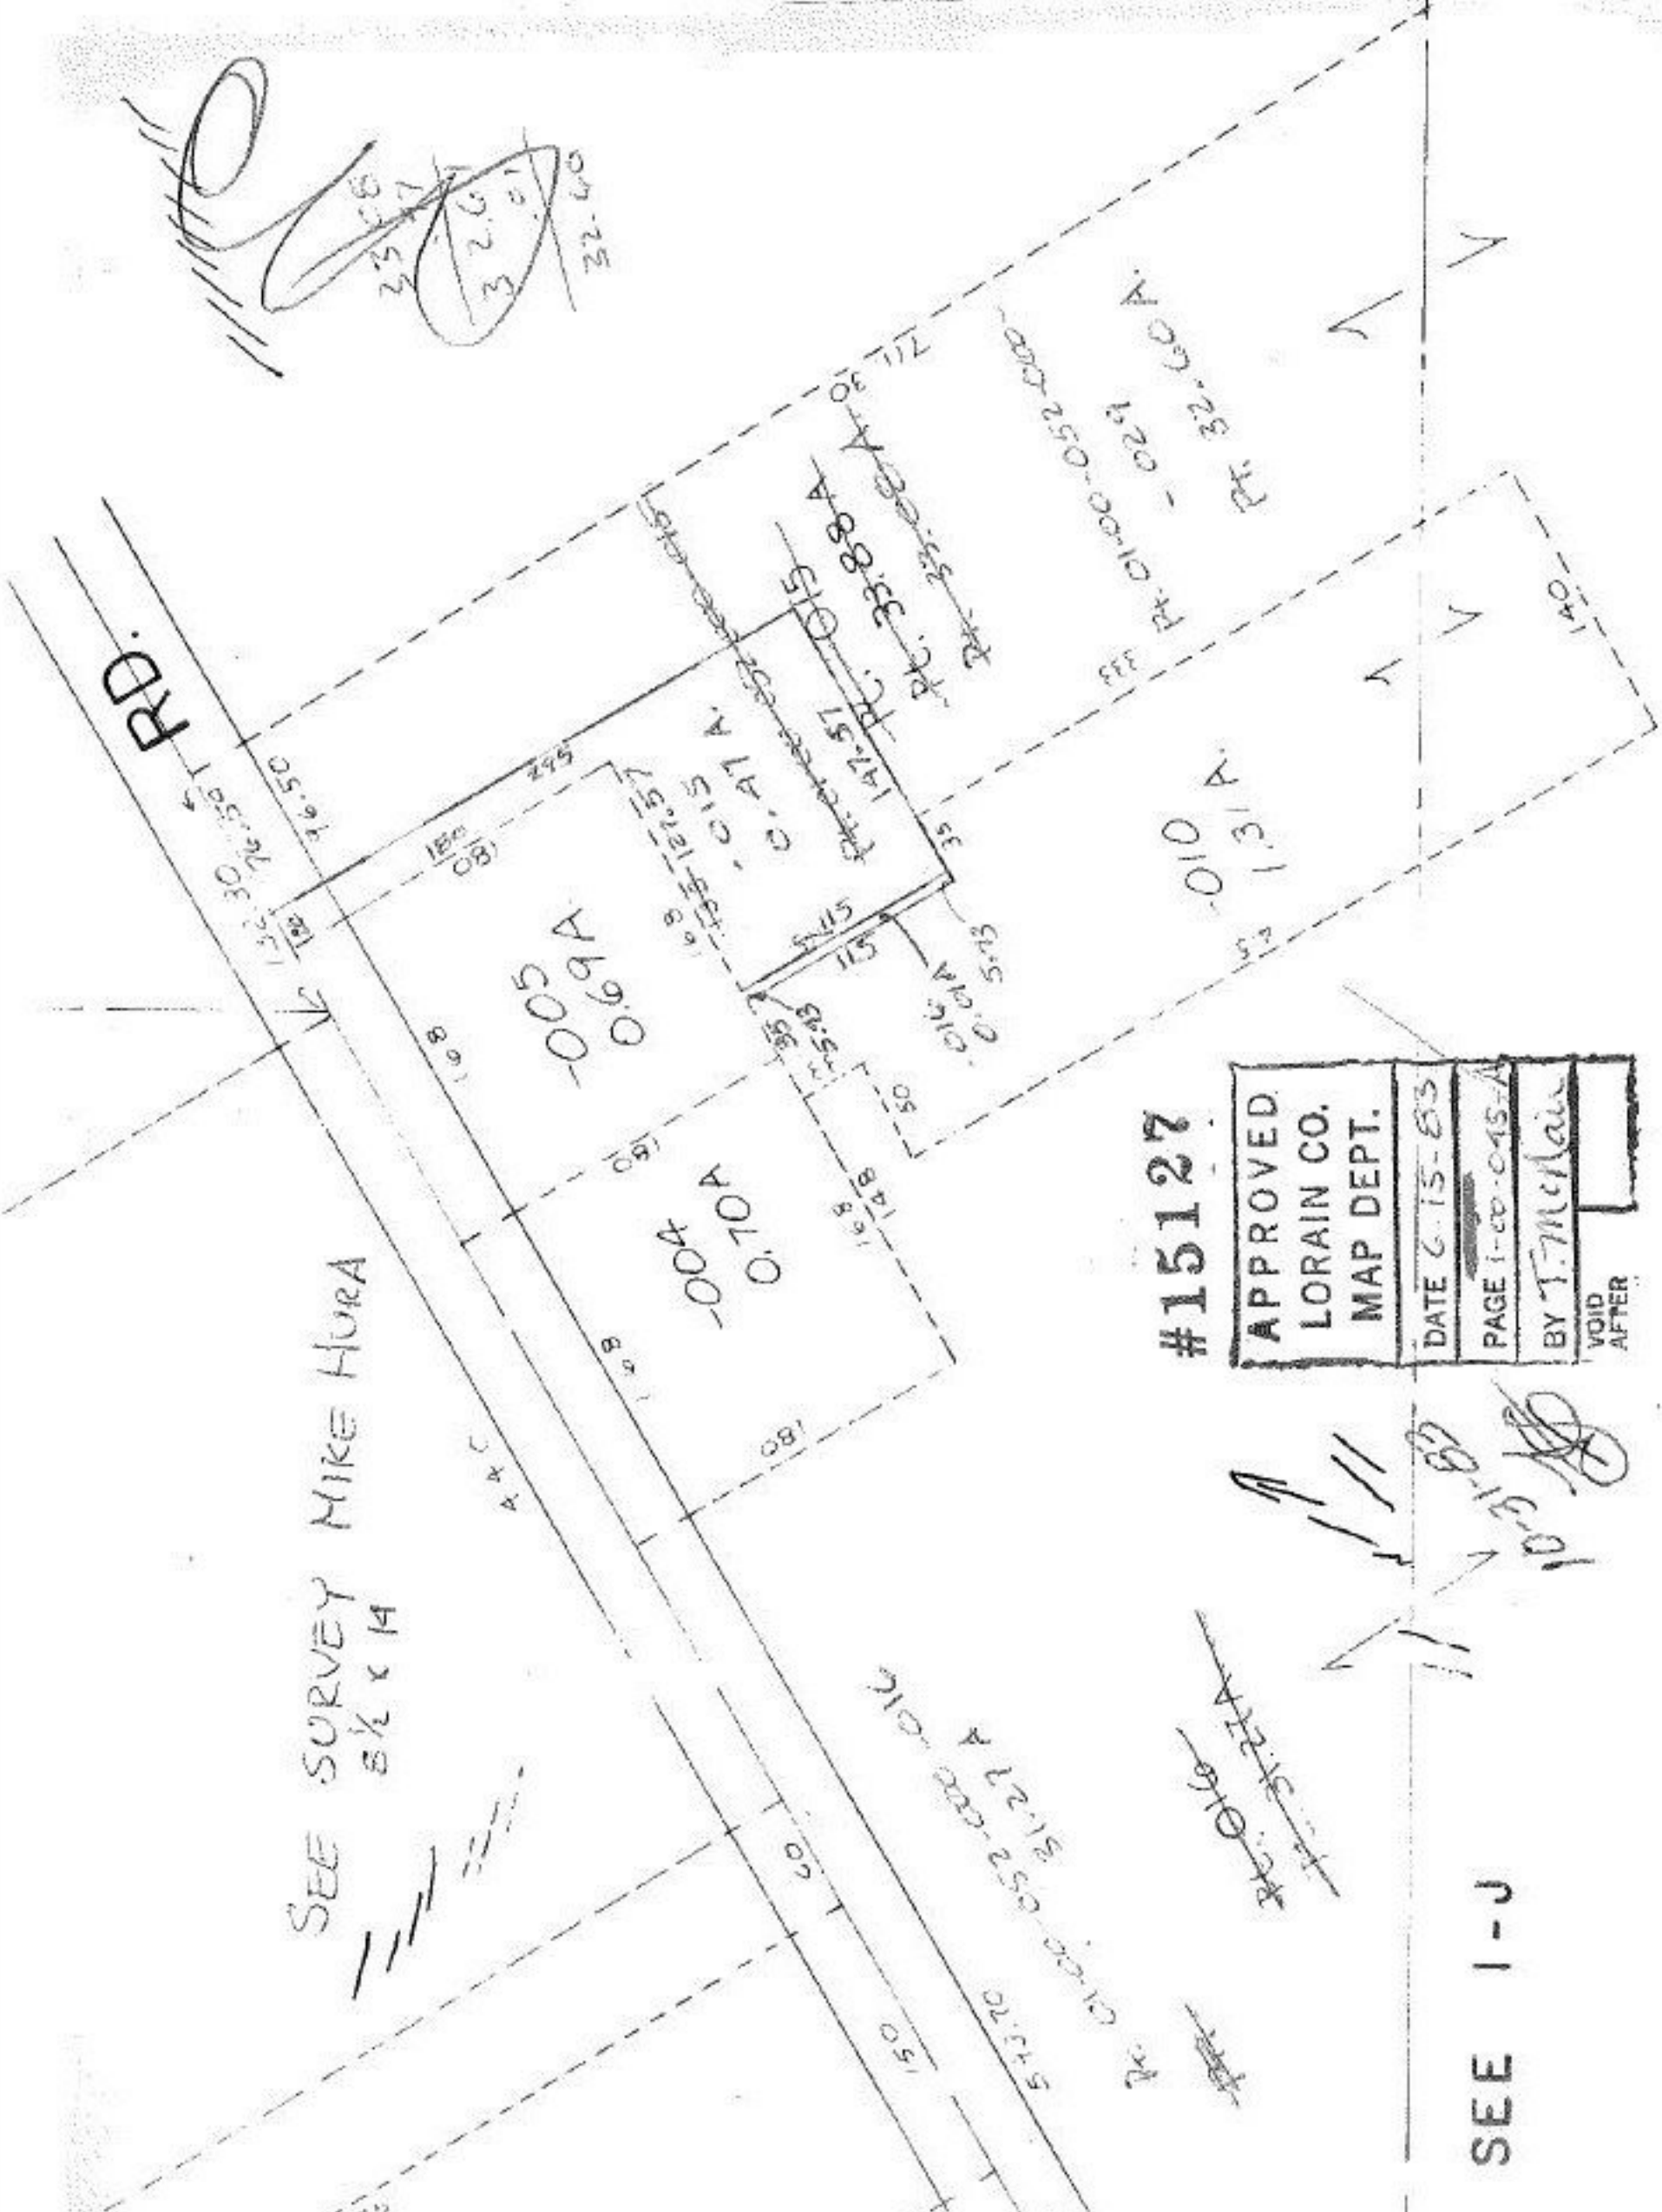


RD.

SEE SURVEY MIKE HURA  
8 1/2 x 14

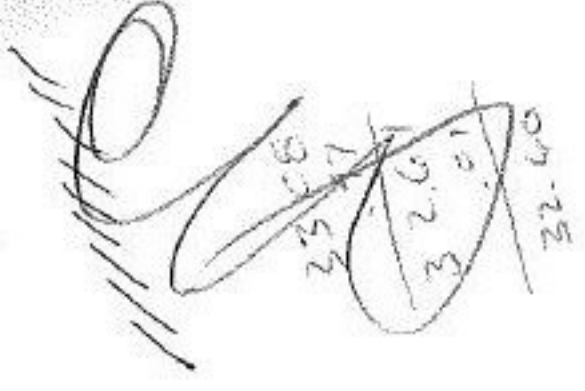

#15127

APPROVED. LORAIN CO. MAP DEPT.	DATE 6-15-83
	PAGE 1-00-045-A
	BY T. McLean
VOID AFTER	

SEE 1-J



~~RD. 0.10-00-052-000-010~~

RD. 0.10-00-052-000-010

RD. 0.10-00-052-000-010

