
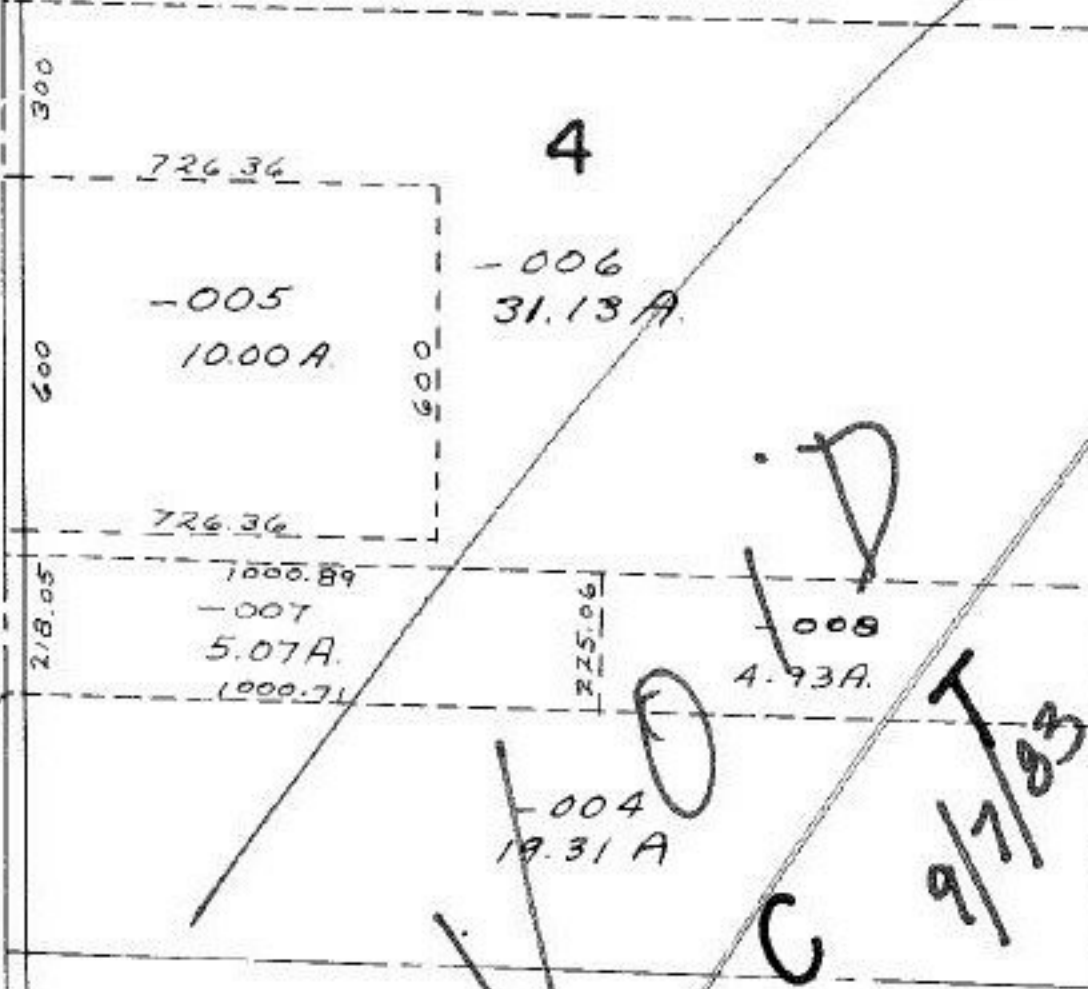


-008  
16.04

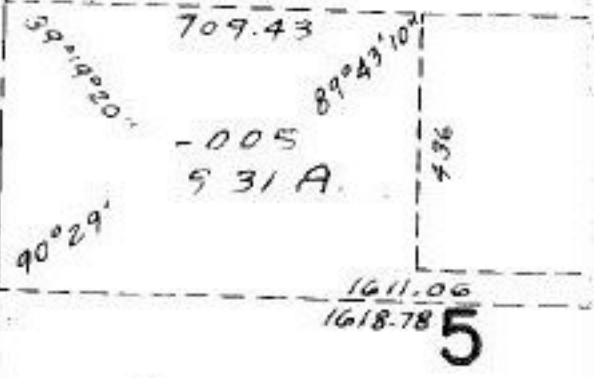

-007  
53.00 A.

Handwritten notes: 'D', 'C', '9/7/83', and a signature.

Garfield Rd.

#15144

APPROVED LORAIN CO. MAP DEPT.	
DATE	1-22-83
PAGE	8-B
BY	
VOID AFTER	15144

-009  
43.06 A.


6

BAIRD



GARFIELD

#15144

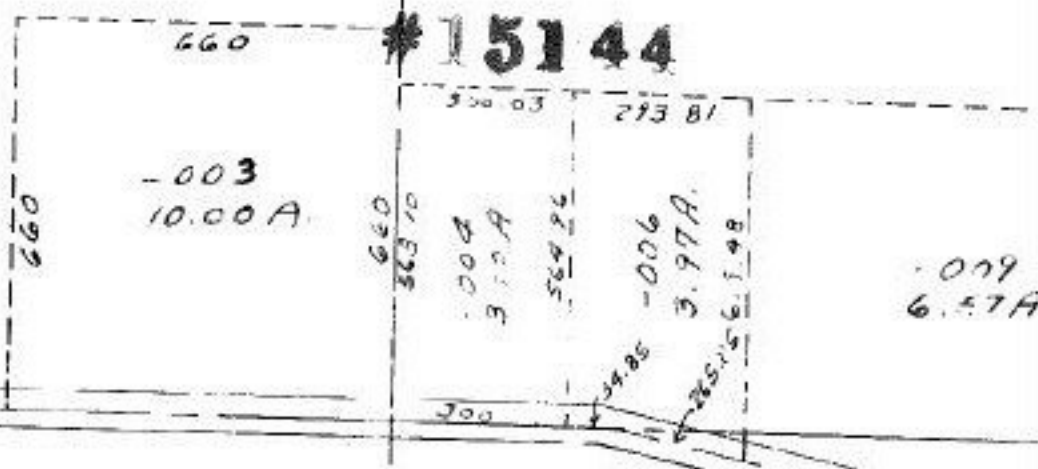

-009  
6.57 A.

SEE 8-F