


11-000

SEE 11-~~B~~

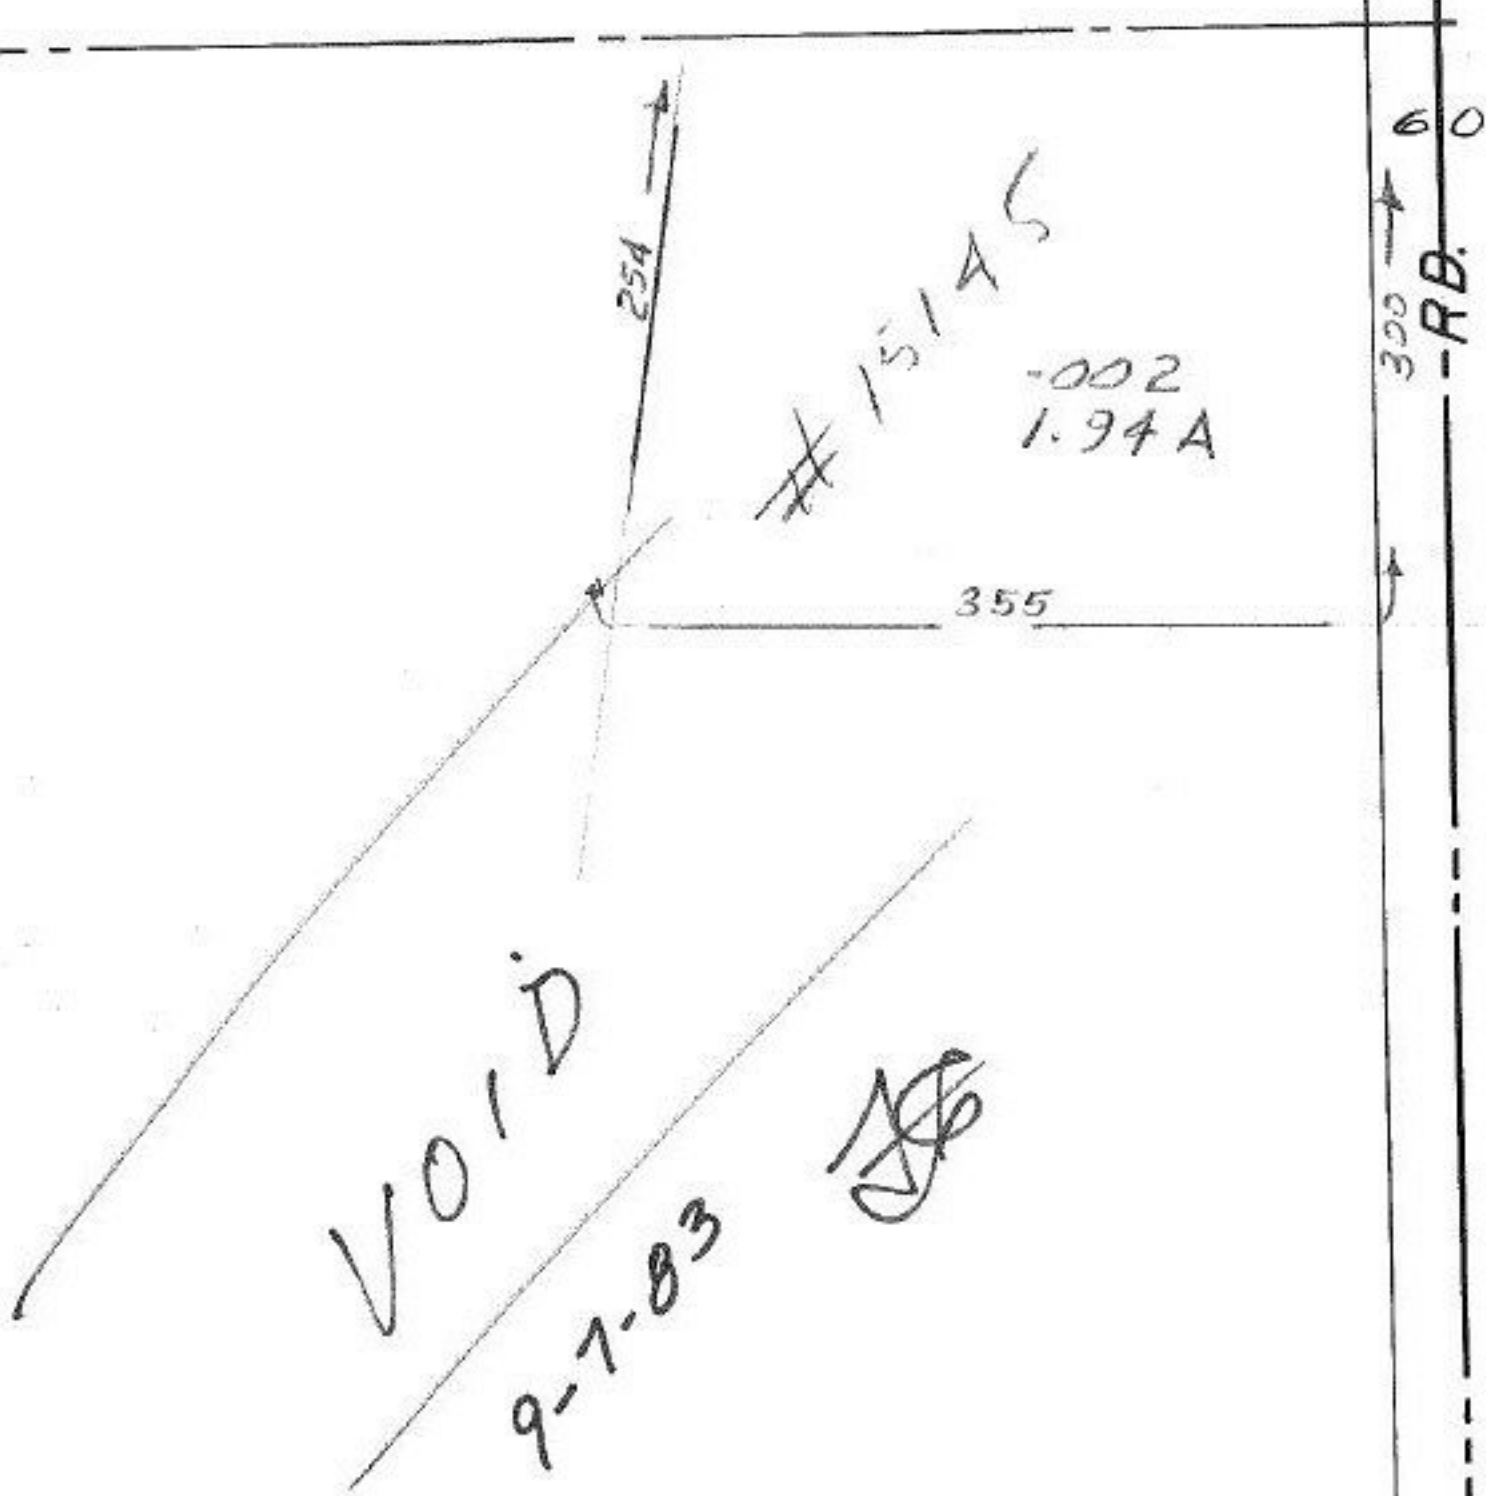

101

VOID

9-7-83

[Signature]

PL. -001 -003
PL. 70-00A. 68.06A

#15145

APPROVED LORAIN CO. MAP DEPT.	
DATE 6-24-83	
PAGE 11-00-000-B	
BY C. Francis	
VOID AFTER	