


355.65	22.5	22.5	50	028	50
-027				.17A.	
.73A.					
355.65			50	-029	50
				.17A.	
13.08 -077	355.65	0.11A.	13.08	150	

ROBSON

SEE SURVEY BY
D. MOSLEY

#15172

APPROVED
LORAIN CO.
MAP DEPT.
DATE 7.14.83
PAGE 10.00.016.B
BY T. McHain
VOID
AFTER

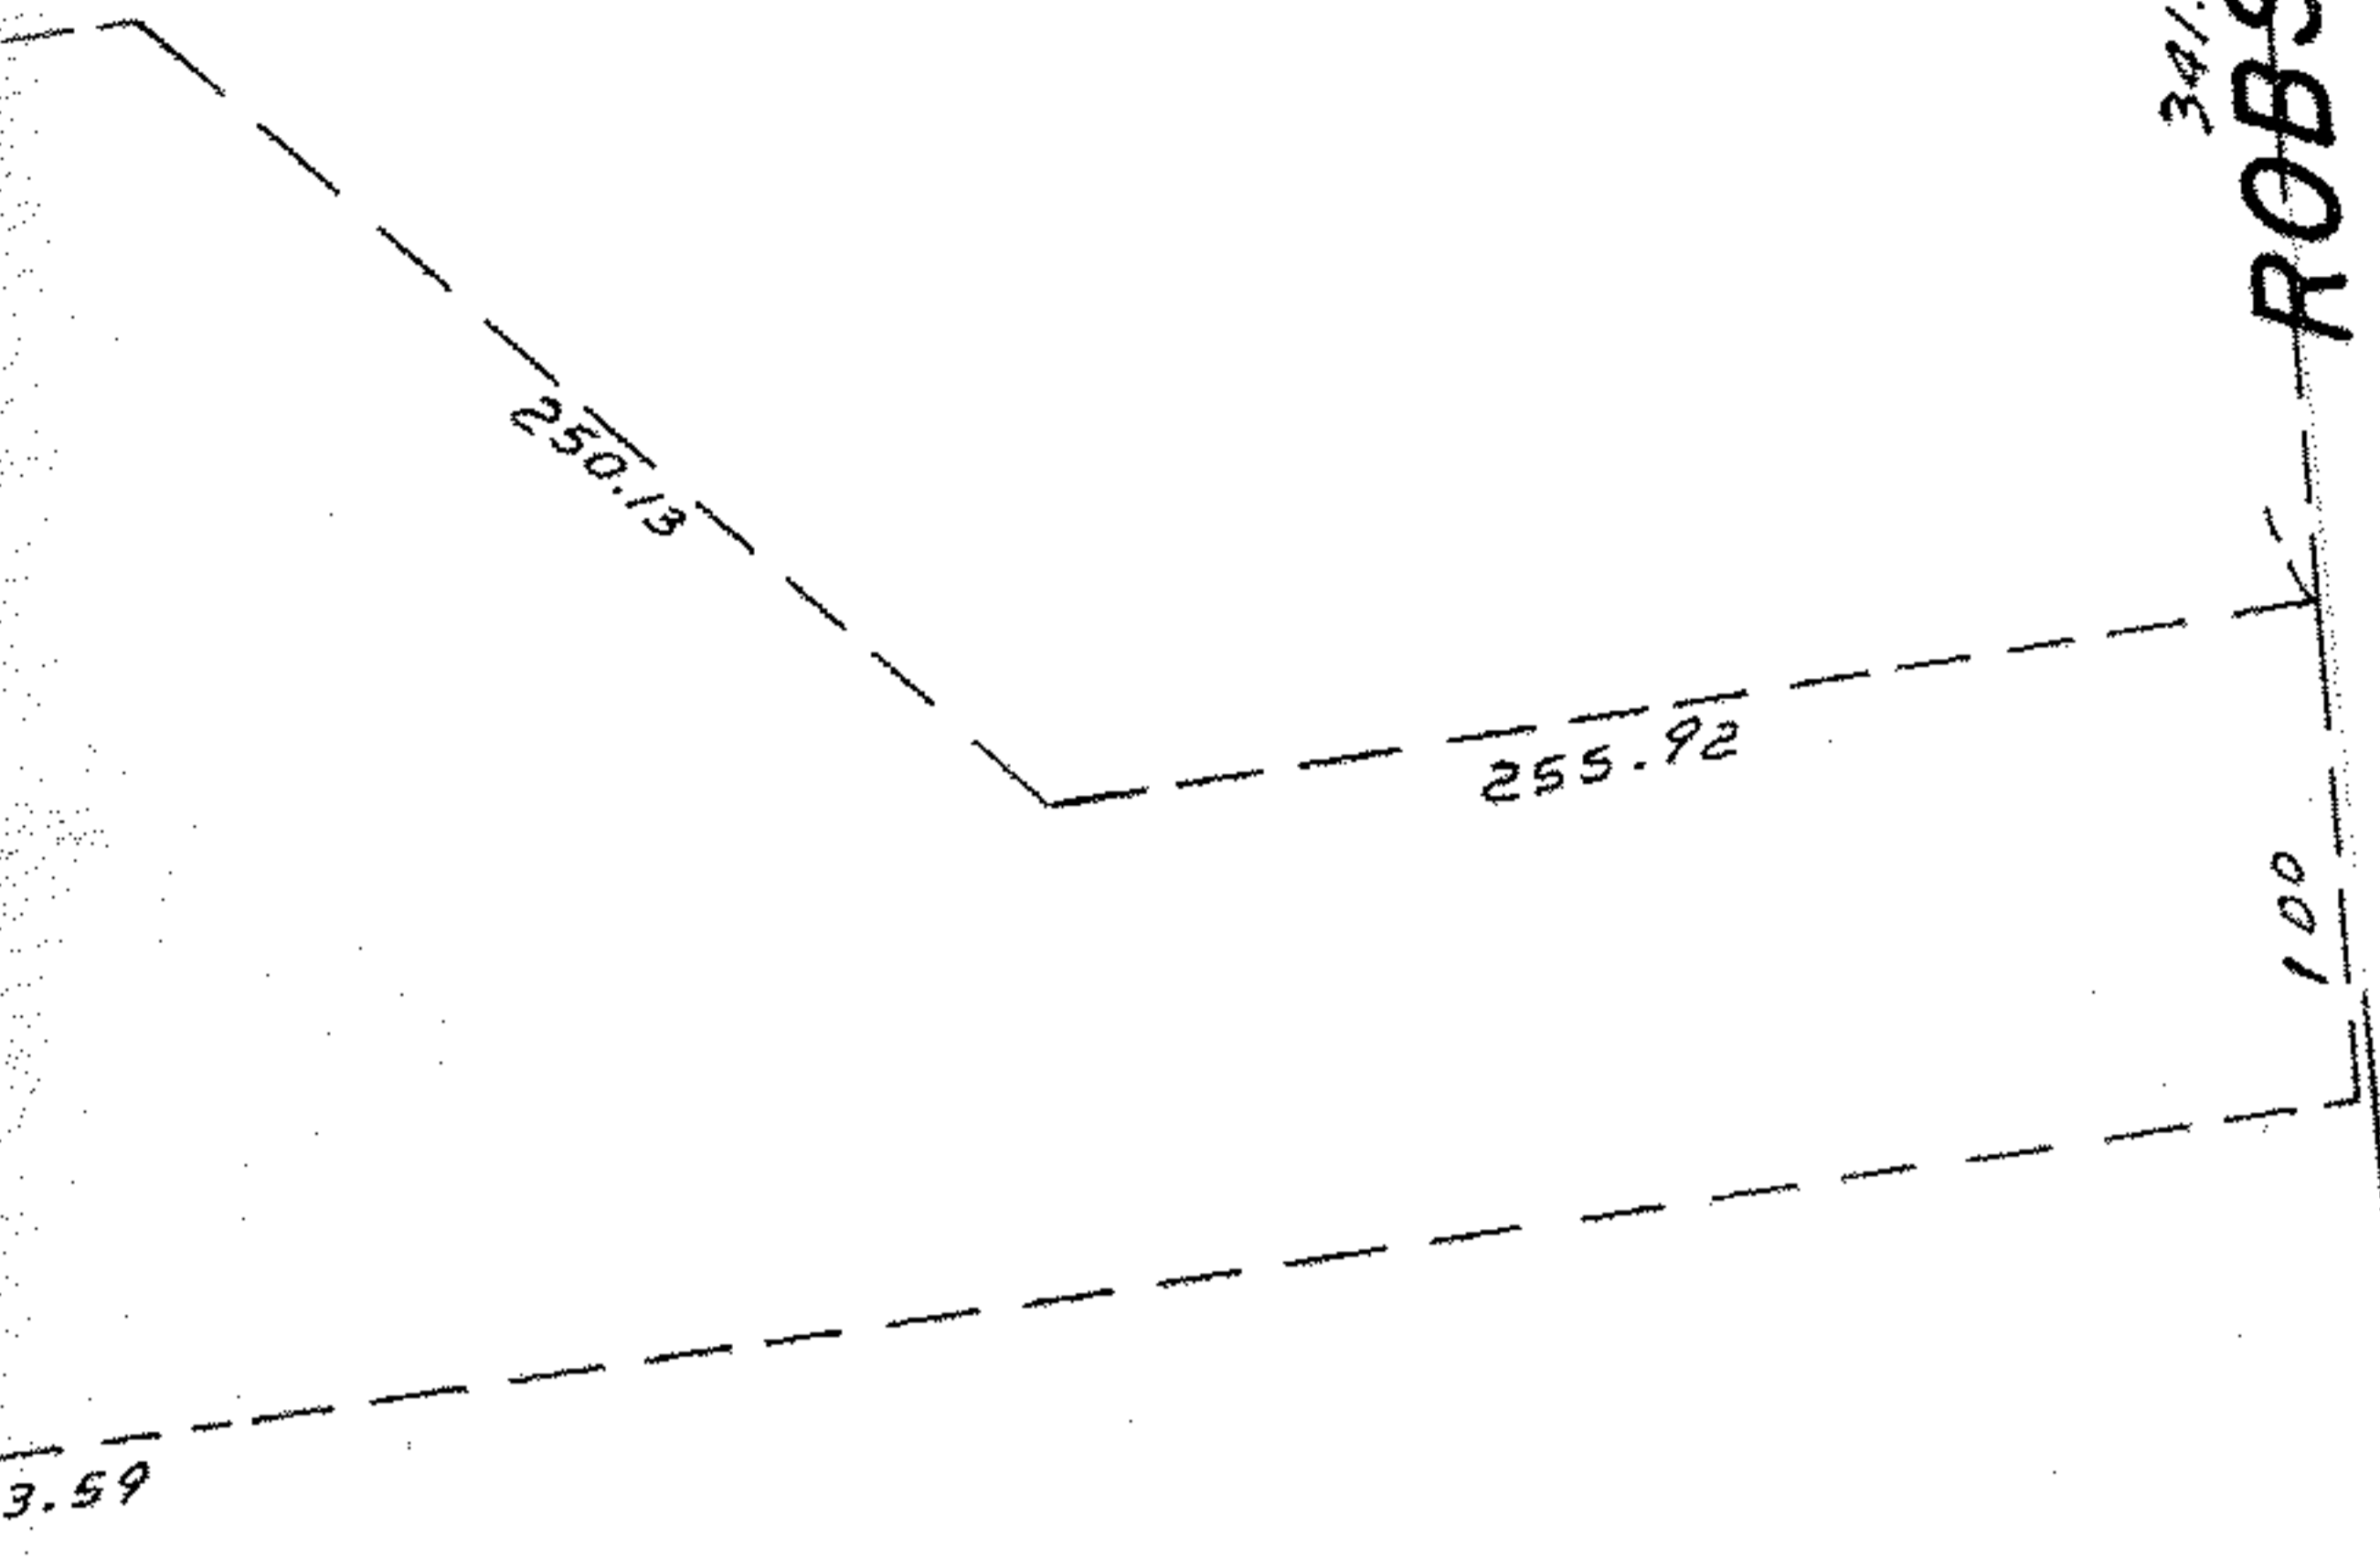

#15172

-084
19.53 A

#15172


APPROVED
LORAIN CO.
MAP DEPT.
DATE 7.14.83
PAGE 10.00.016.B
BY T. McHain
VOID
AFTER

~~-078~~
~~47.53A.~~

-085
33.20 A.

1964.25

~~-031~~
~~5.20A.~~

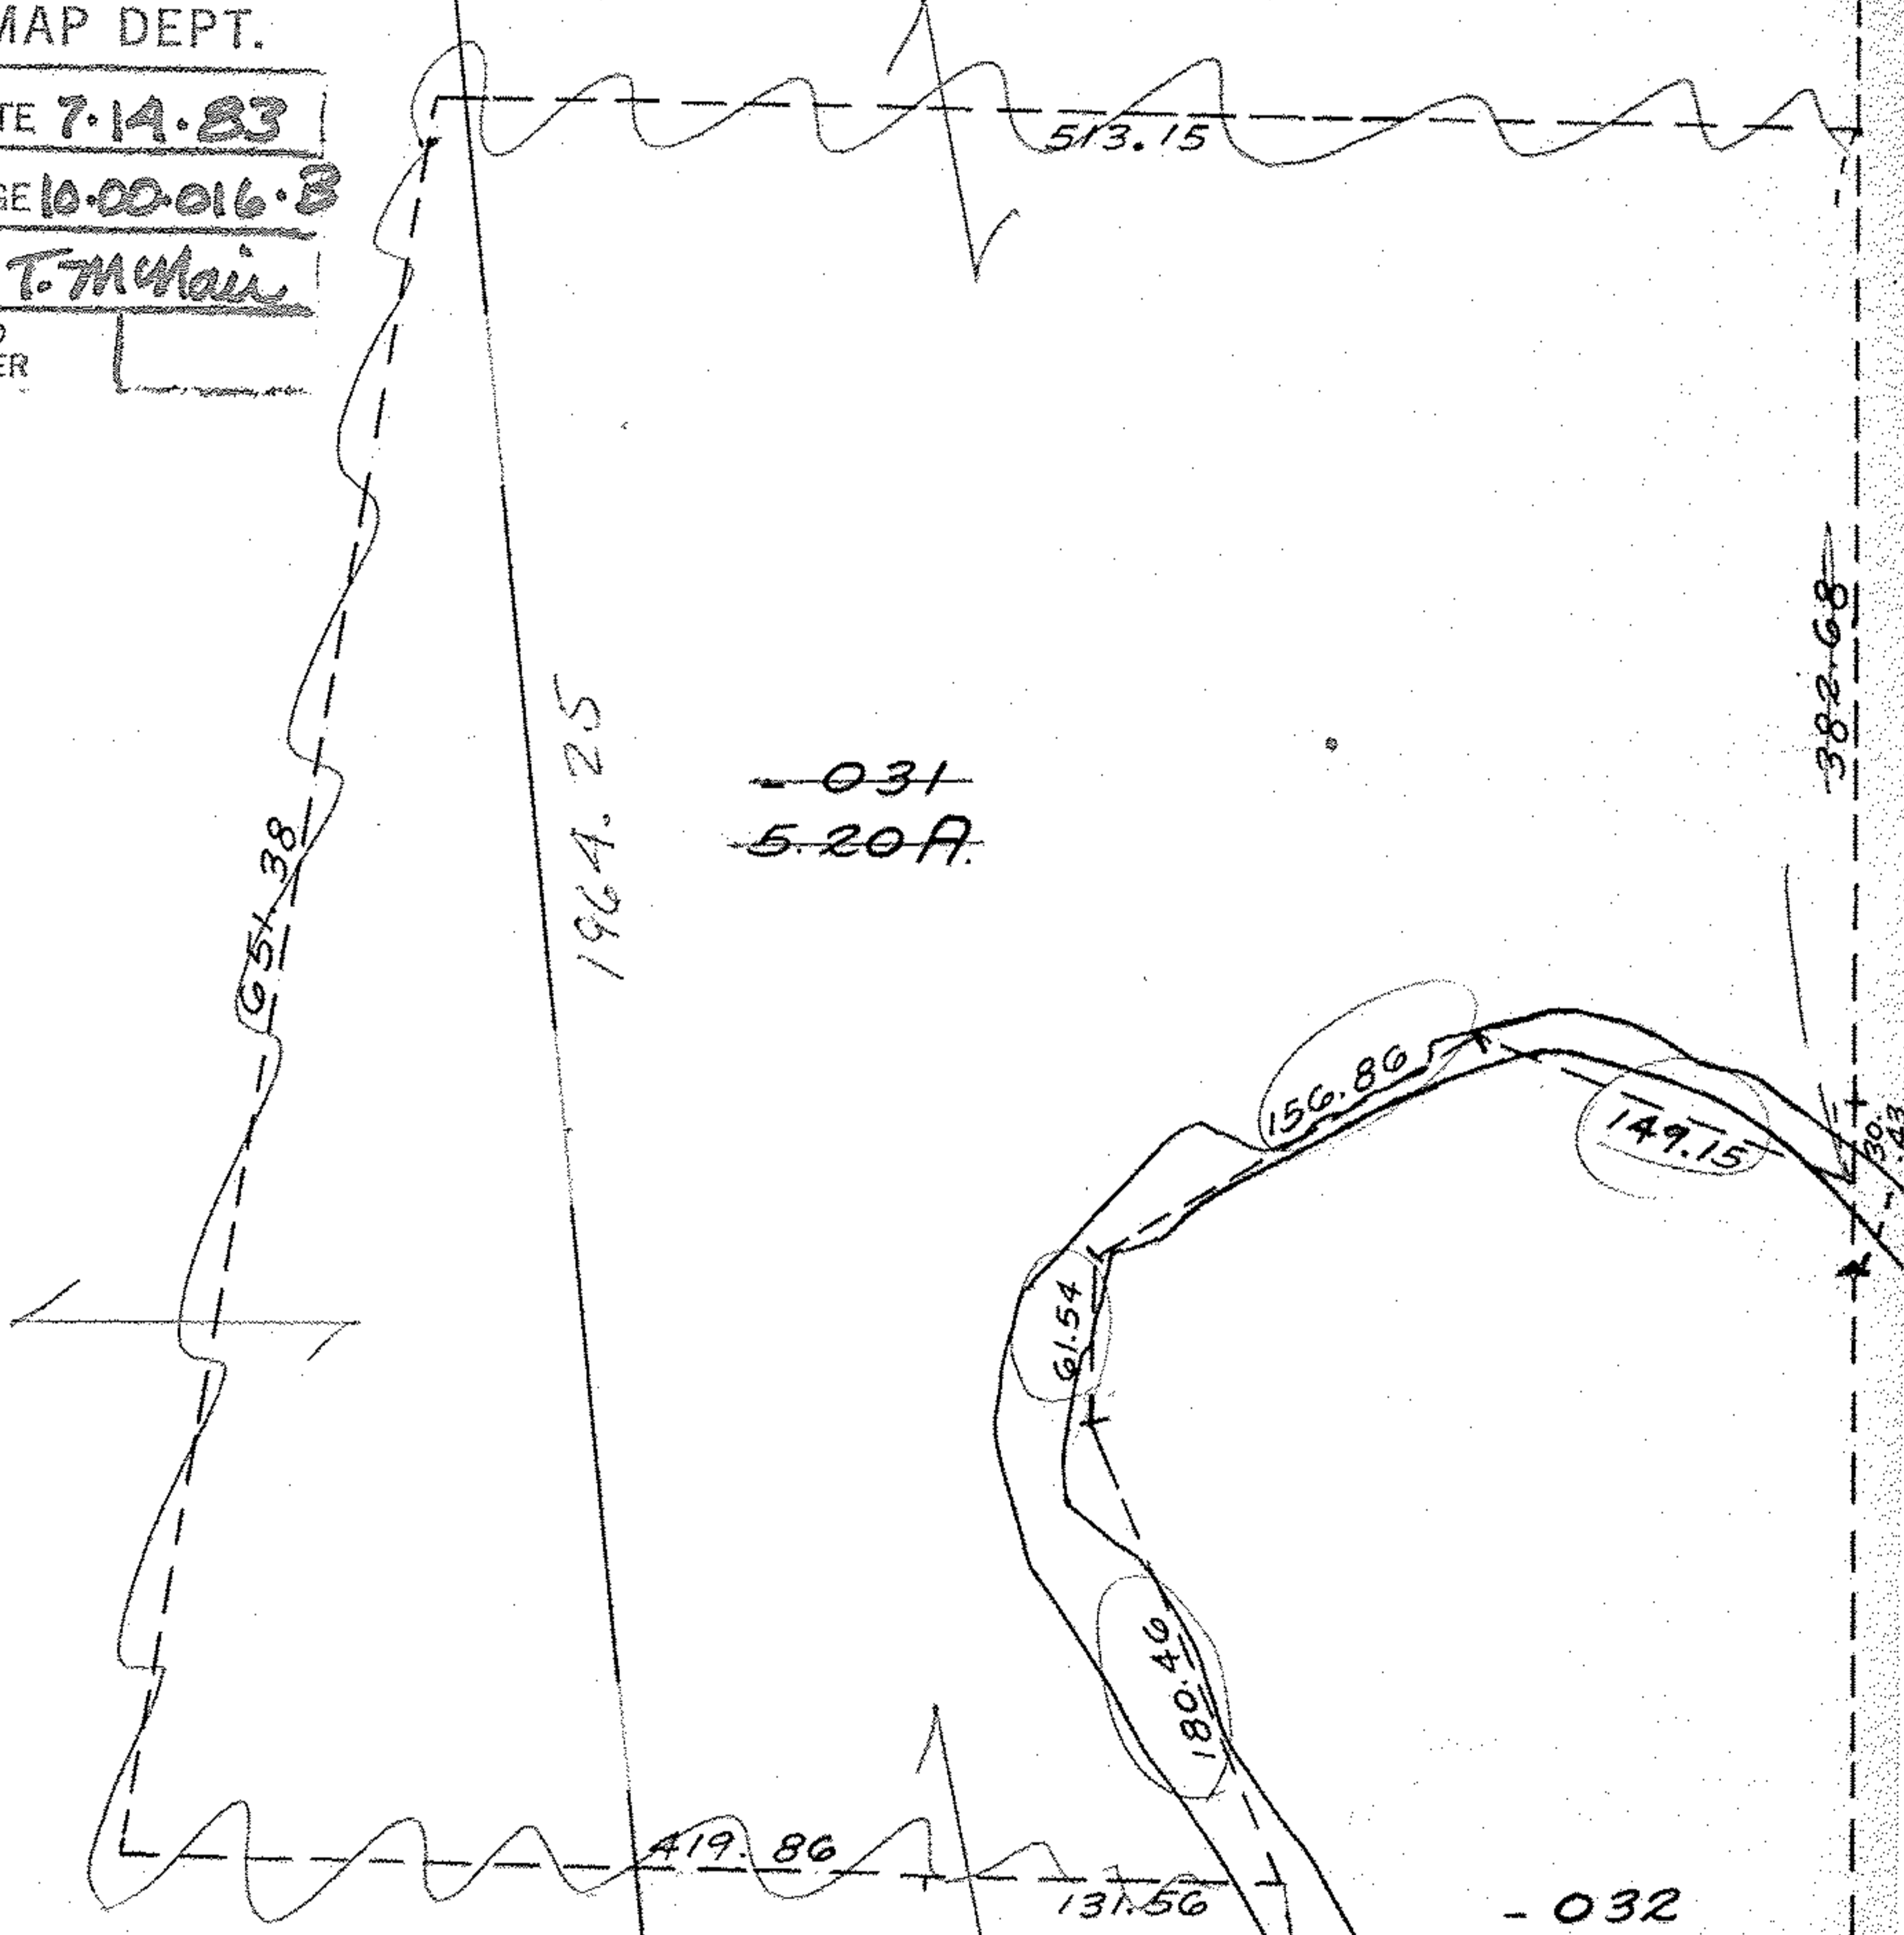

-032
3.00A.

#15172

APPROVED
LORAIN CO.
MAP DEPT.
DATE 7.14.83
PAGE 10.00.016.B
BY T. McHain
VOID
AFTER

T.M.
10.3.85

2220

RIVER

128

205

90°03'