


SE

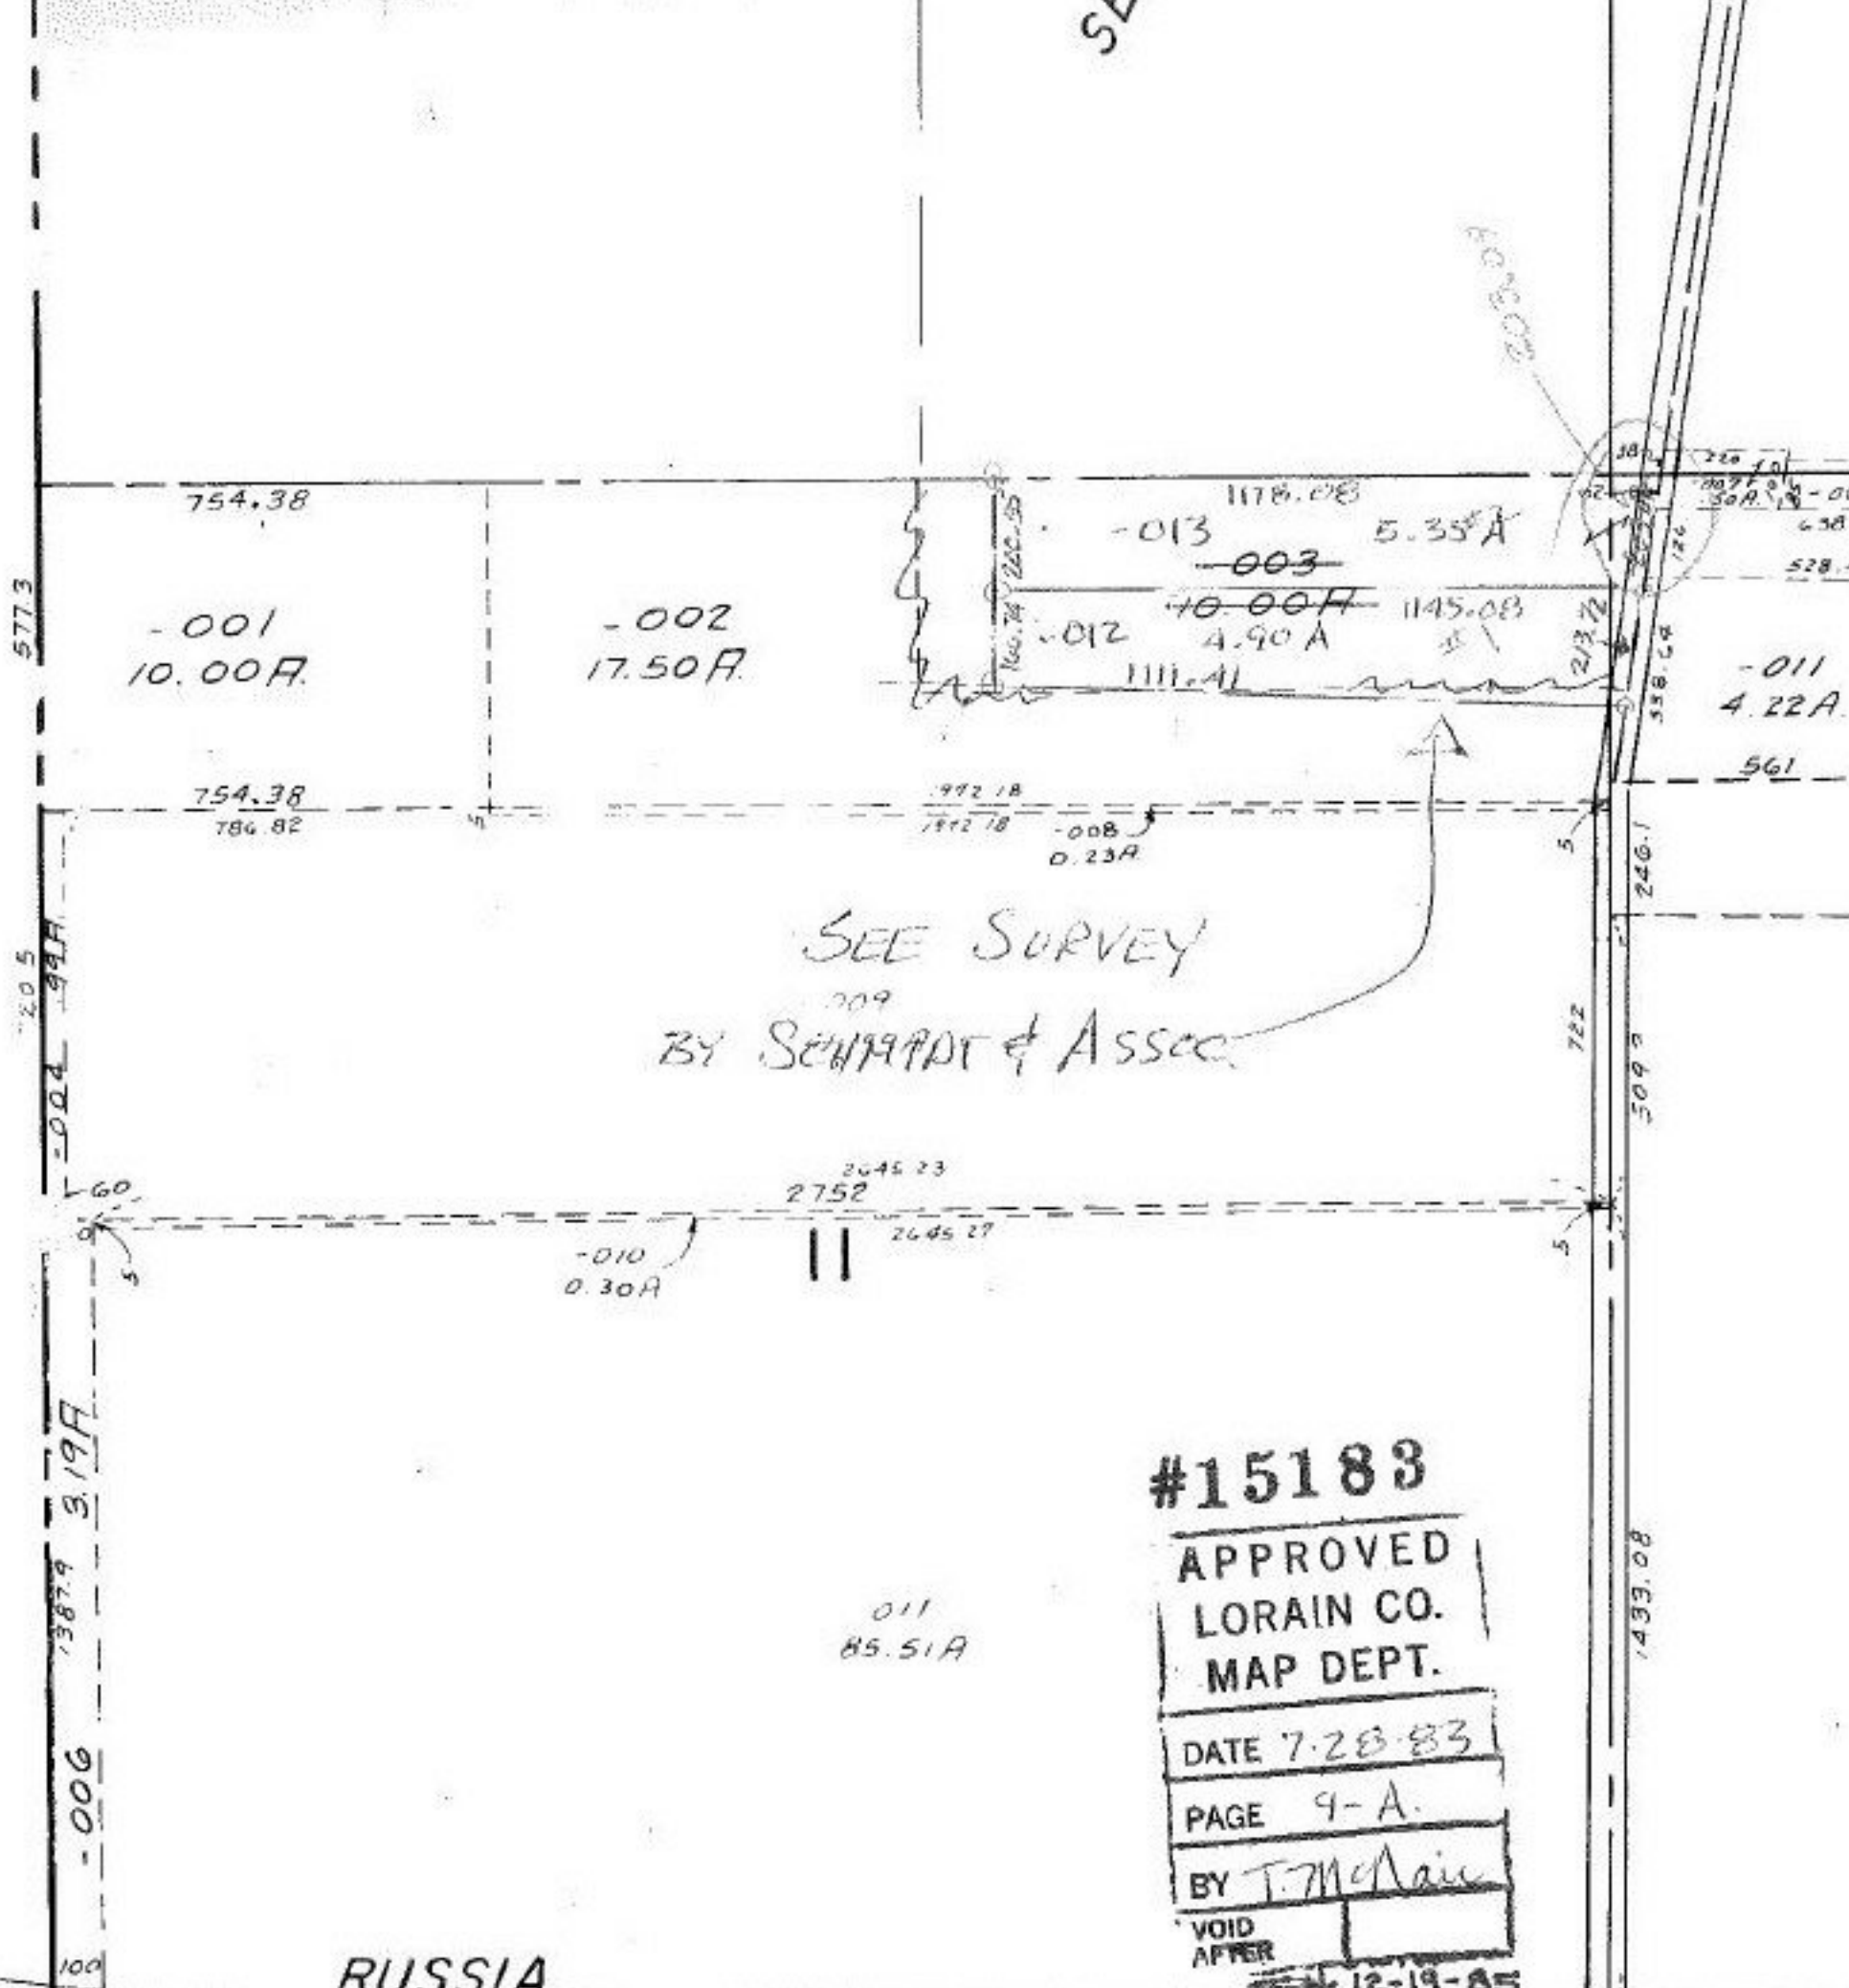

SEE SURVEY
 BY SCHMADT & ASSOC

#15183
 APPROVED
 LORAIN CO.
 MAP DEPT.
 DATE 7-28-83
 PAGE 9-A.
 BY T. McNamee
 VOID AFTER
 12-19-85

RUSSIA

