

- 040
1.31 A.

- 030
1.25 A.

- 028
.60 A.

- 029
.64 A.

- 039
3.85 ± A.

- 032
1.66 A.

- 033
1.65 A

1067/826 #3

1062/840 #3

#10


SEE COPY SCIMIT SURVEY
FOR PROPERTY LINE CHANGES

SEE 9-A

ACREAGE

CORRECTION

4-9-86

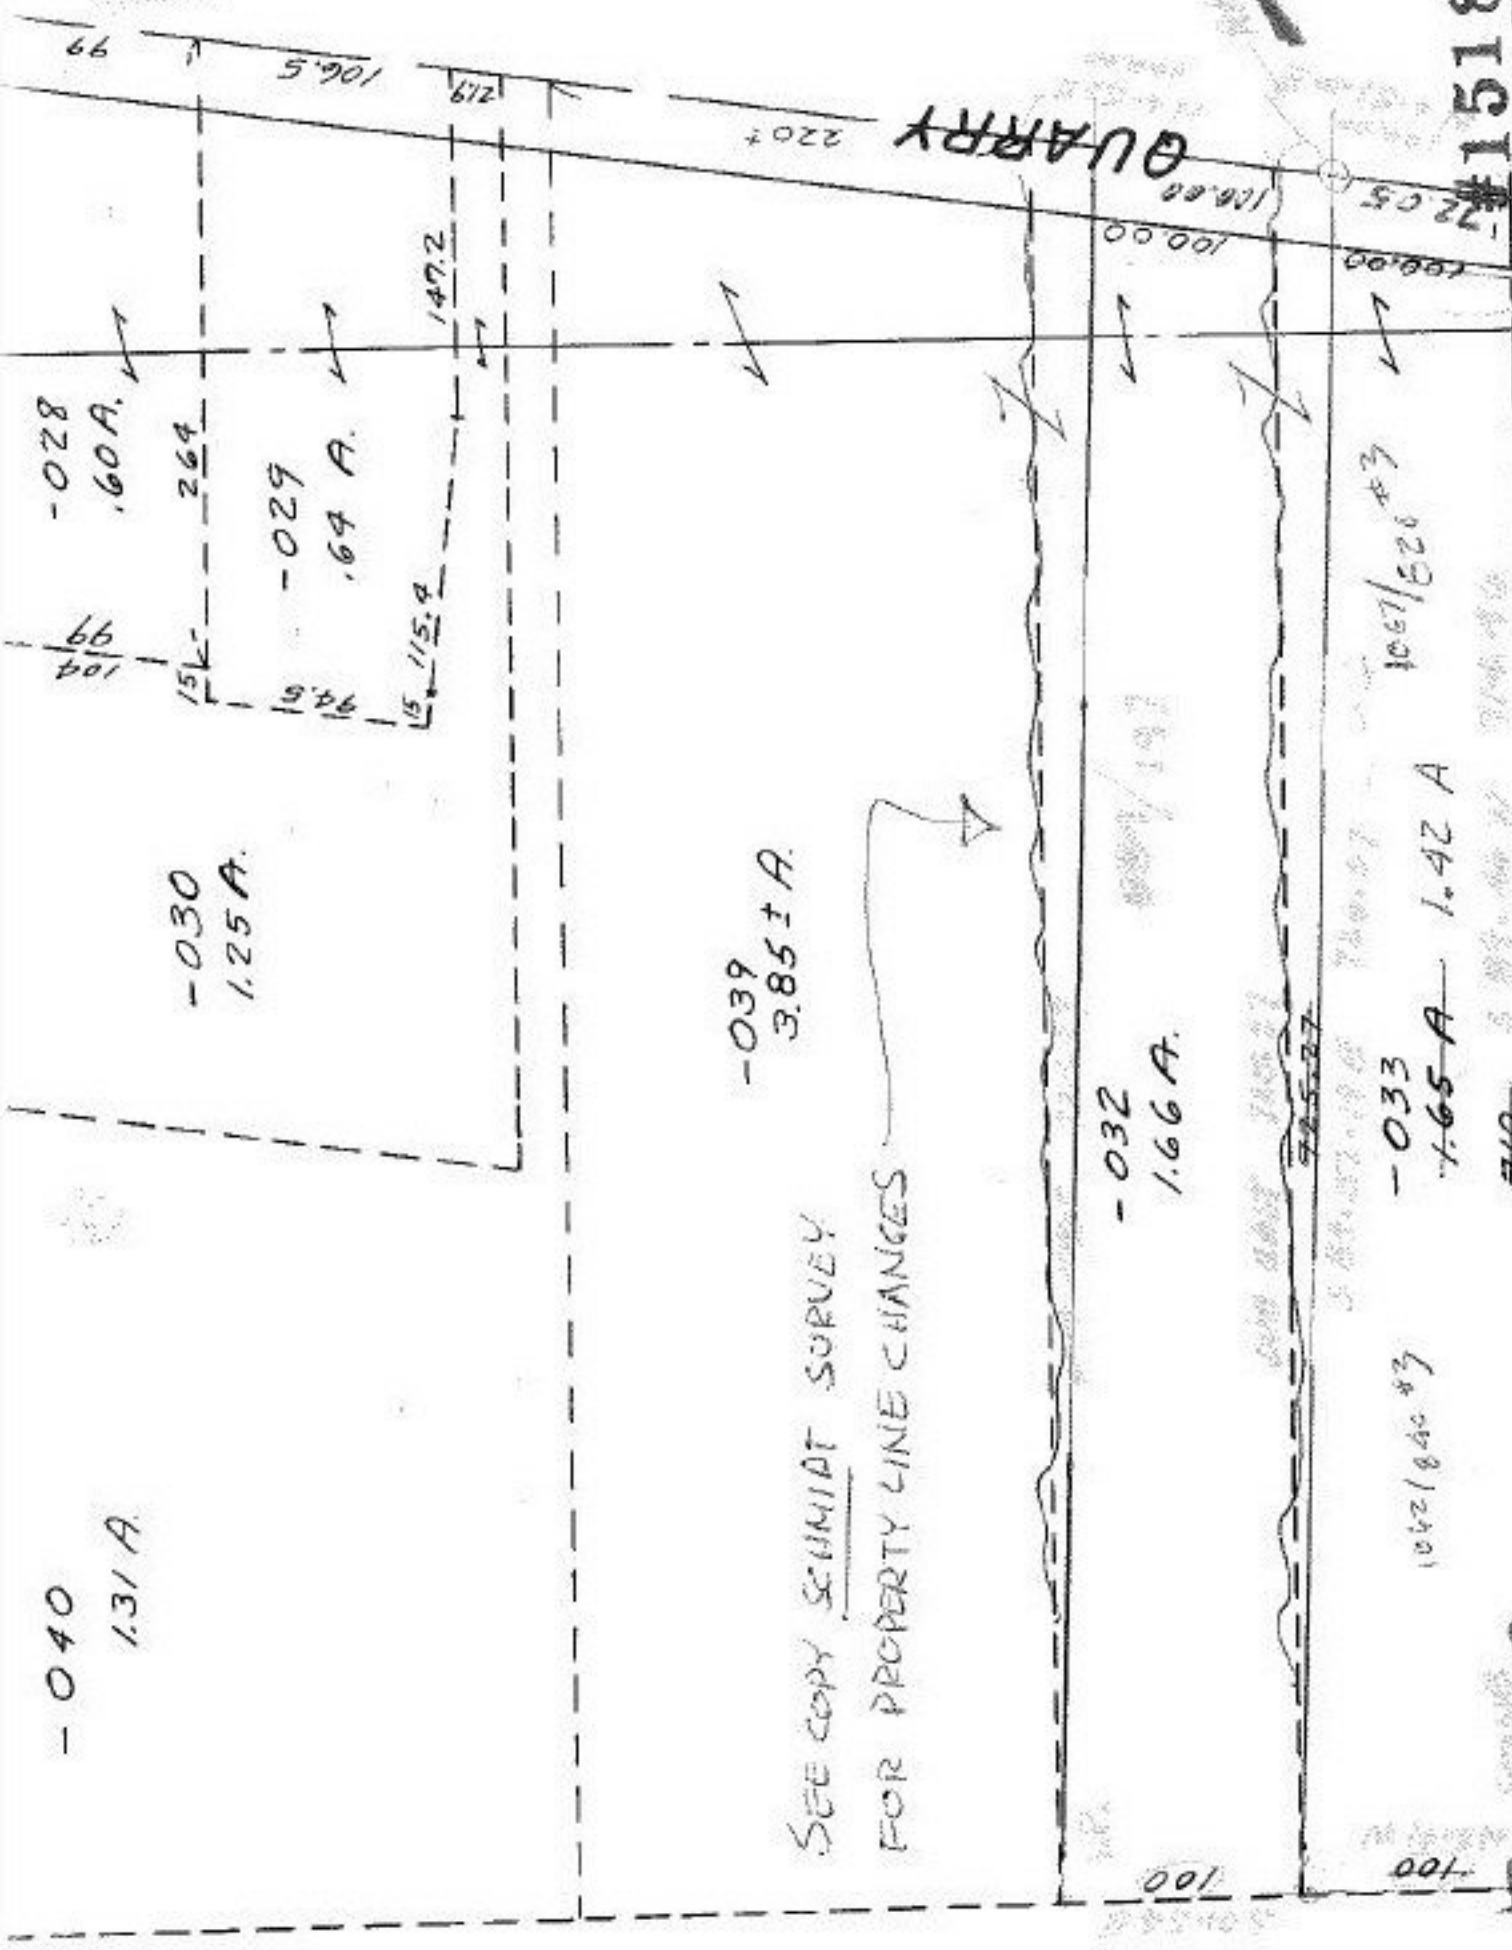

#15184

APPROVED
LORAIN CO.
MAP DEPT.
DATE 7.28.83
PAGE 9.00.001-13
BY T. McCall
VOID AFTER

...IA TWIN