


38.22

85.69

665.71

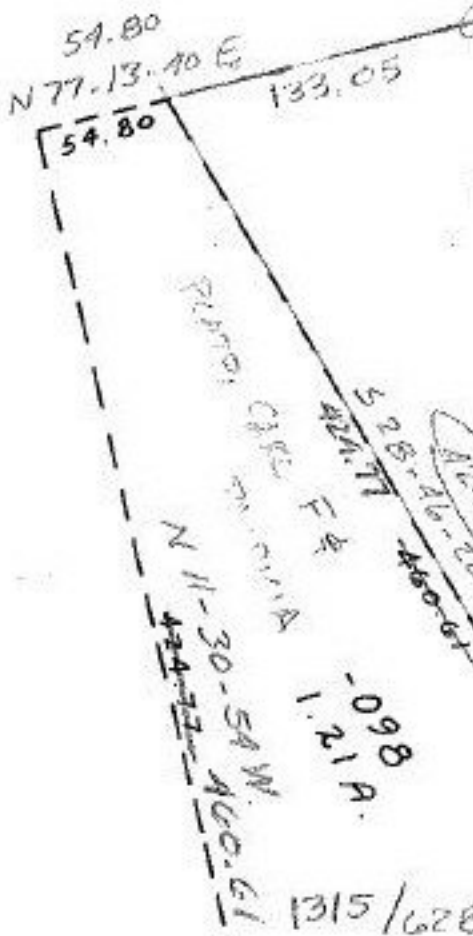

660  
12-38 A

-101  
11.89 A

105	115	105
-050		-049
29 A.		24 A.
125		95

348.06  
PT. 077  
PT. 88 AC

SEE 11-B

11-00-072-000



THIS DIMENSION IS NOT AVAILABLE FROM SURVEY.

RD. #15186

APPROVED  
LORAIN CO.  
MAP DEPT.

DATE 7-22-83

PAGE 11-00 OF 11-B

BY T. McNeil

VOID AFTER

-028  
2.12 A  
8-20-84

SEE COPY OF SURVEY  
BY KLEINODER, SCHMIDT  
& ASSOC.

46.24 CLEVELAND

11-00-029-000

567.66

154.22

174.36

30

0

0

