


Pt. 1  
Pt. 2

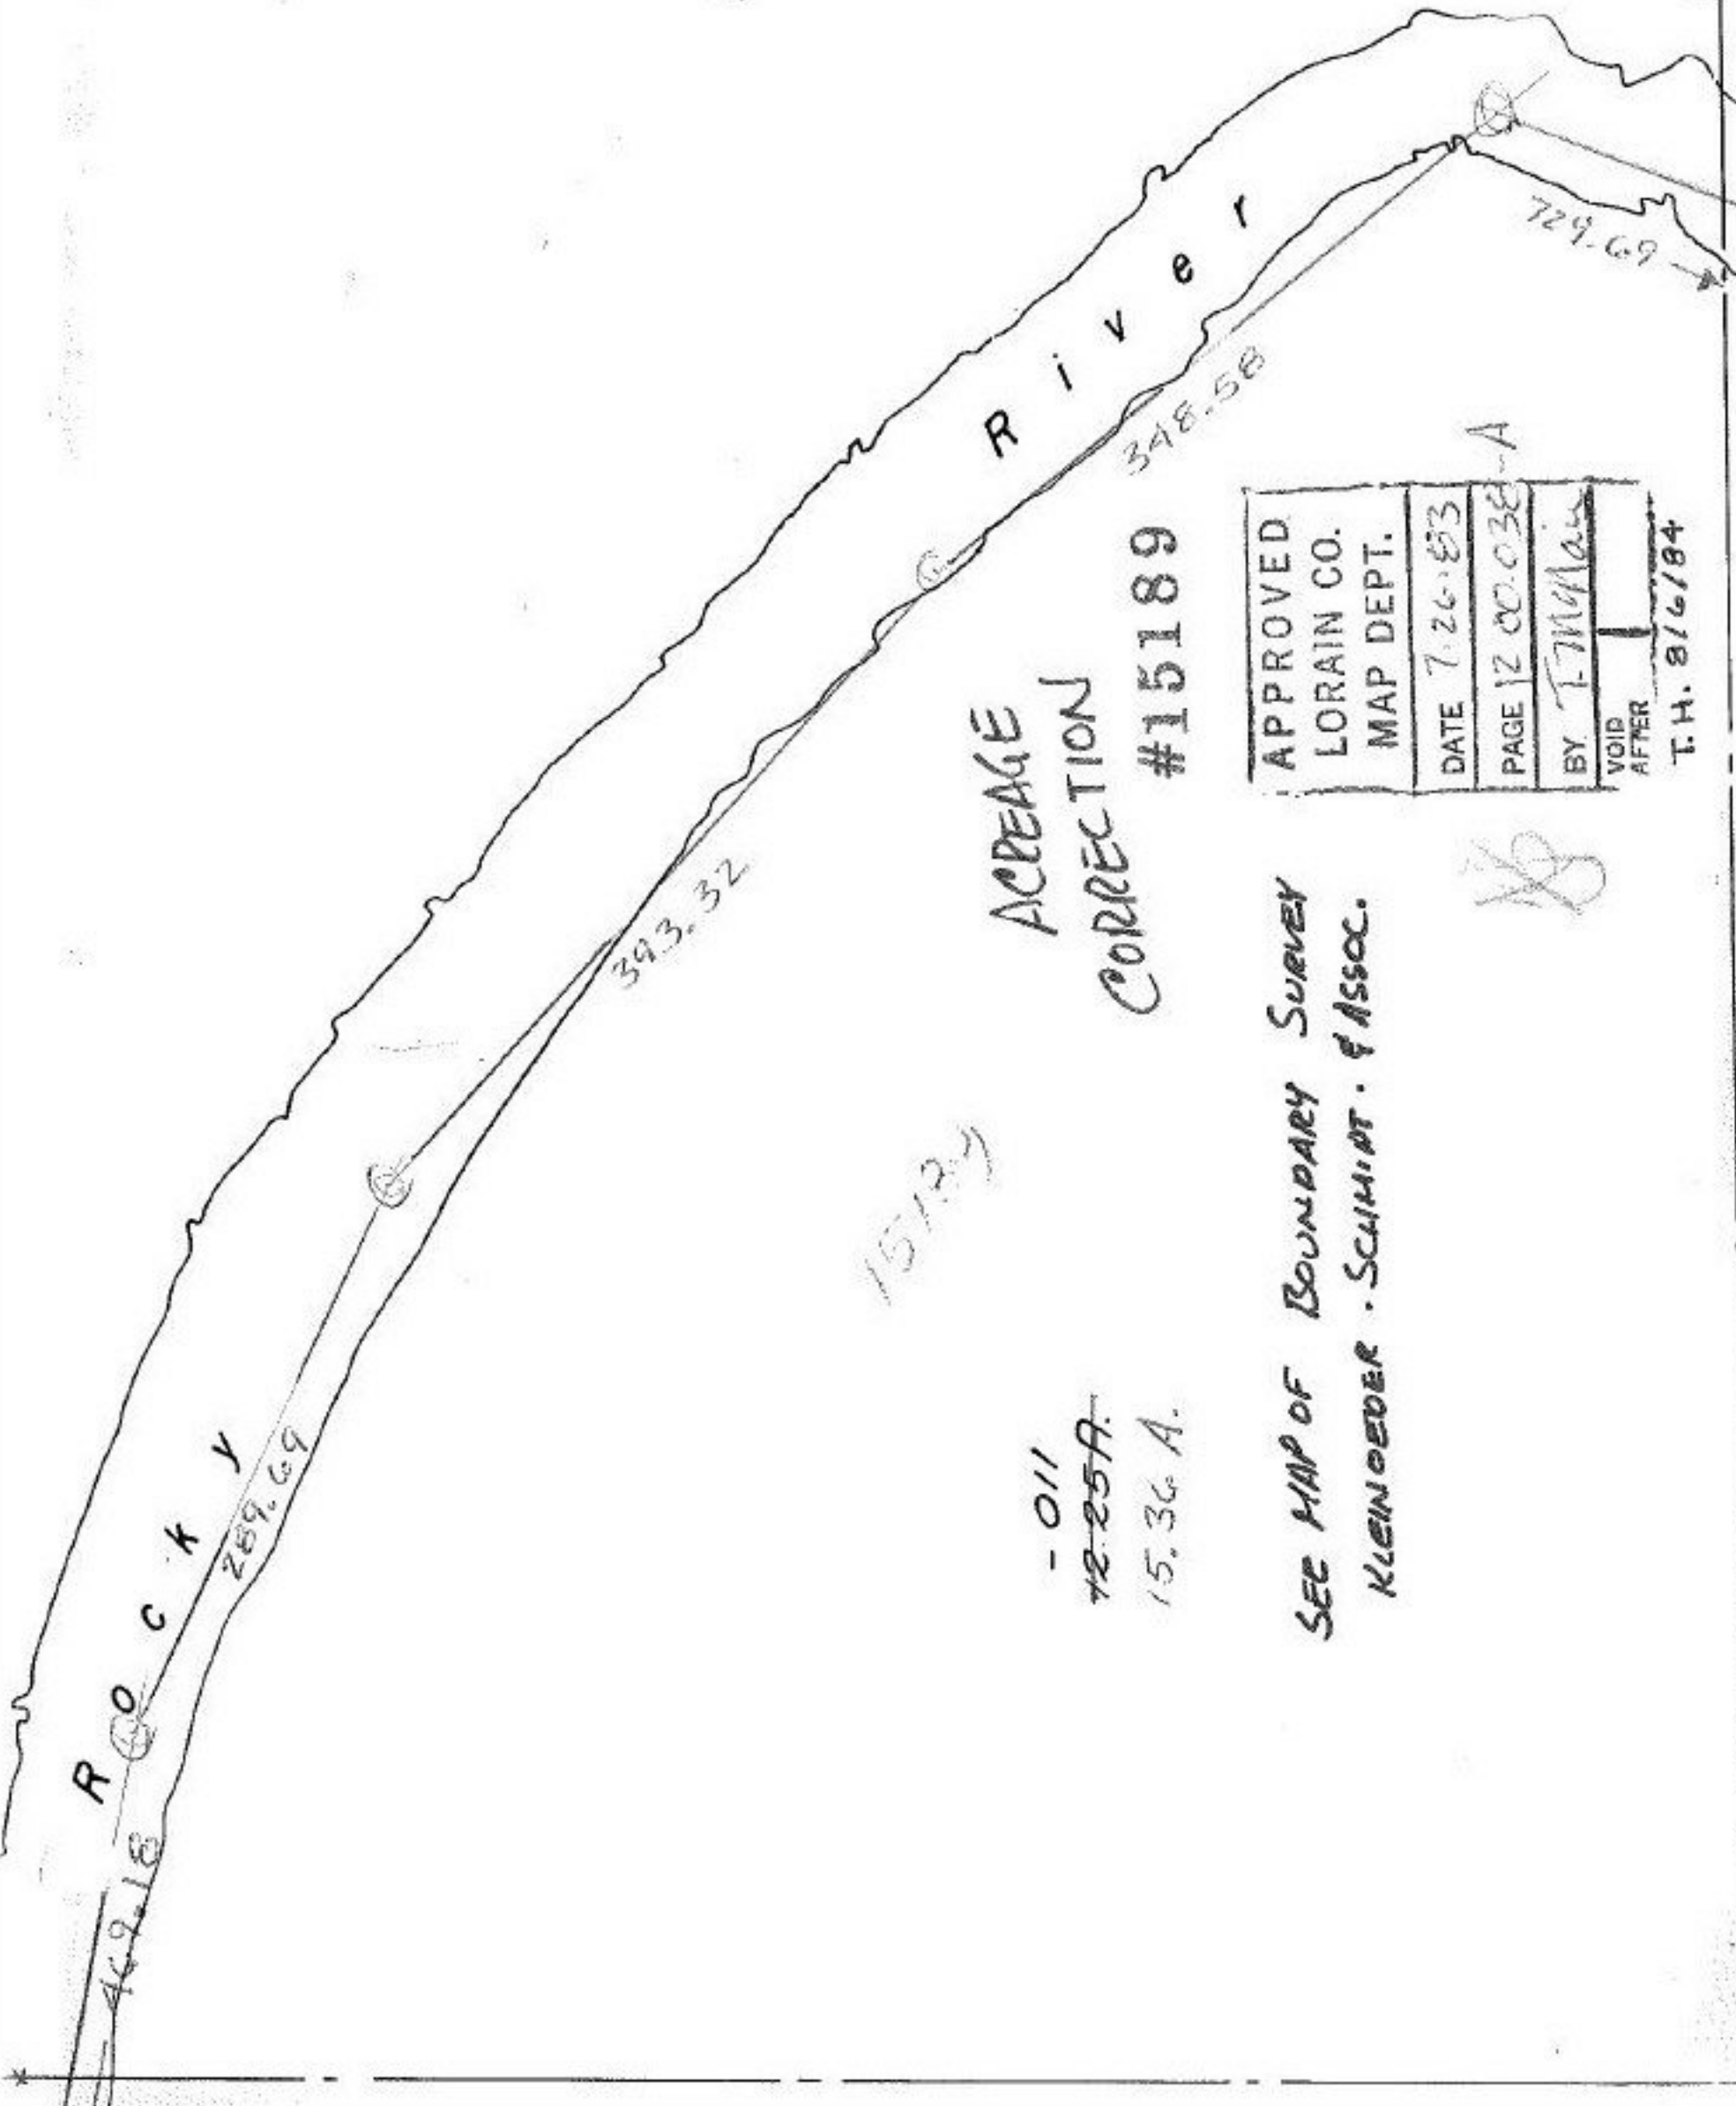

ACREAGE  
CORRECTION  
#15189

APPROVED	DATE 7-26-83
LORAIN CO.	PAGE 12 00.038-A
MAP DEPT.	BY T. McManis
VOID AFTER	T.H. 8/6/84

15189

- 011  
12-25A  
15.36 A.

SEE MAP OF BOUNDARY SURVEY  
KLEINODER - SCHMIDT - & ASSOC.