


1/2

MAP CORRECTION ONLY

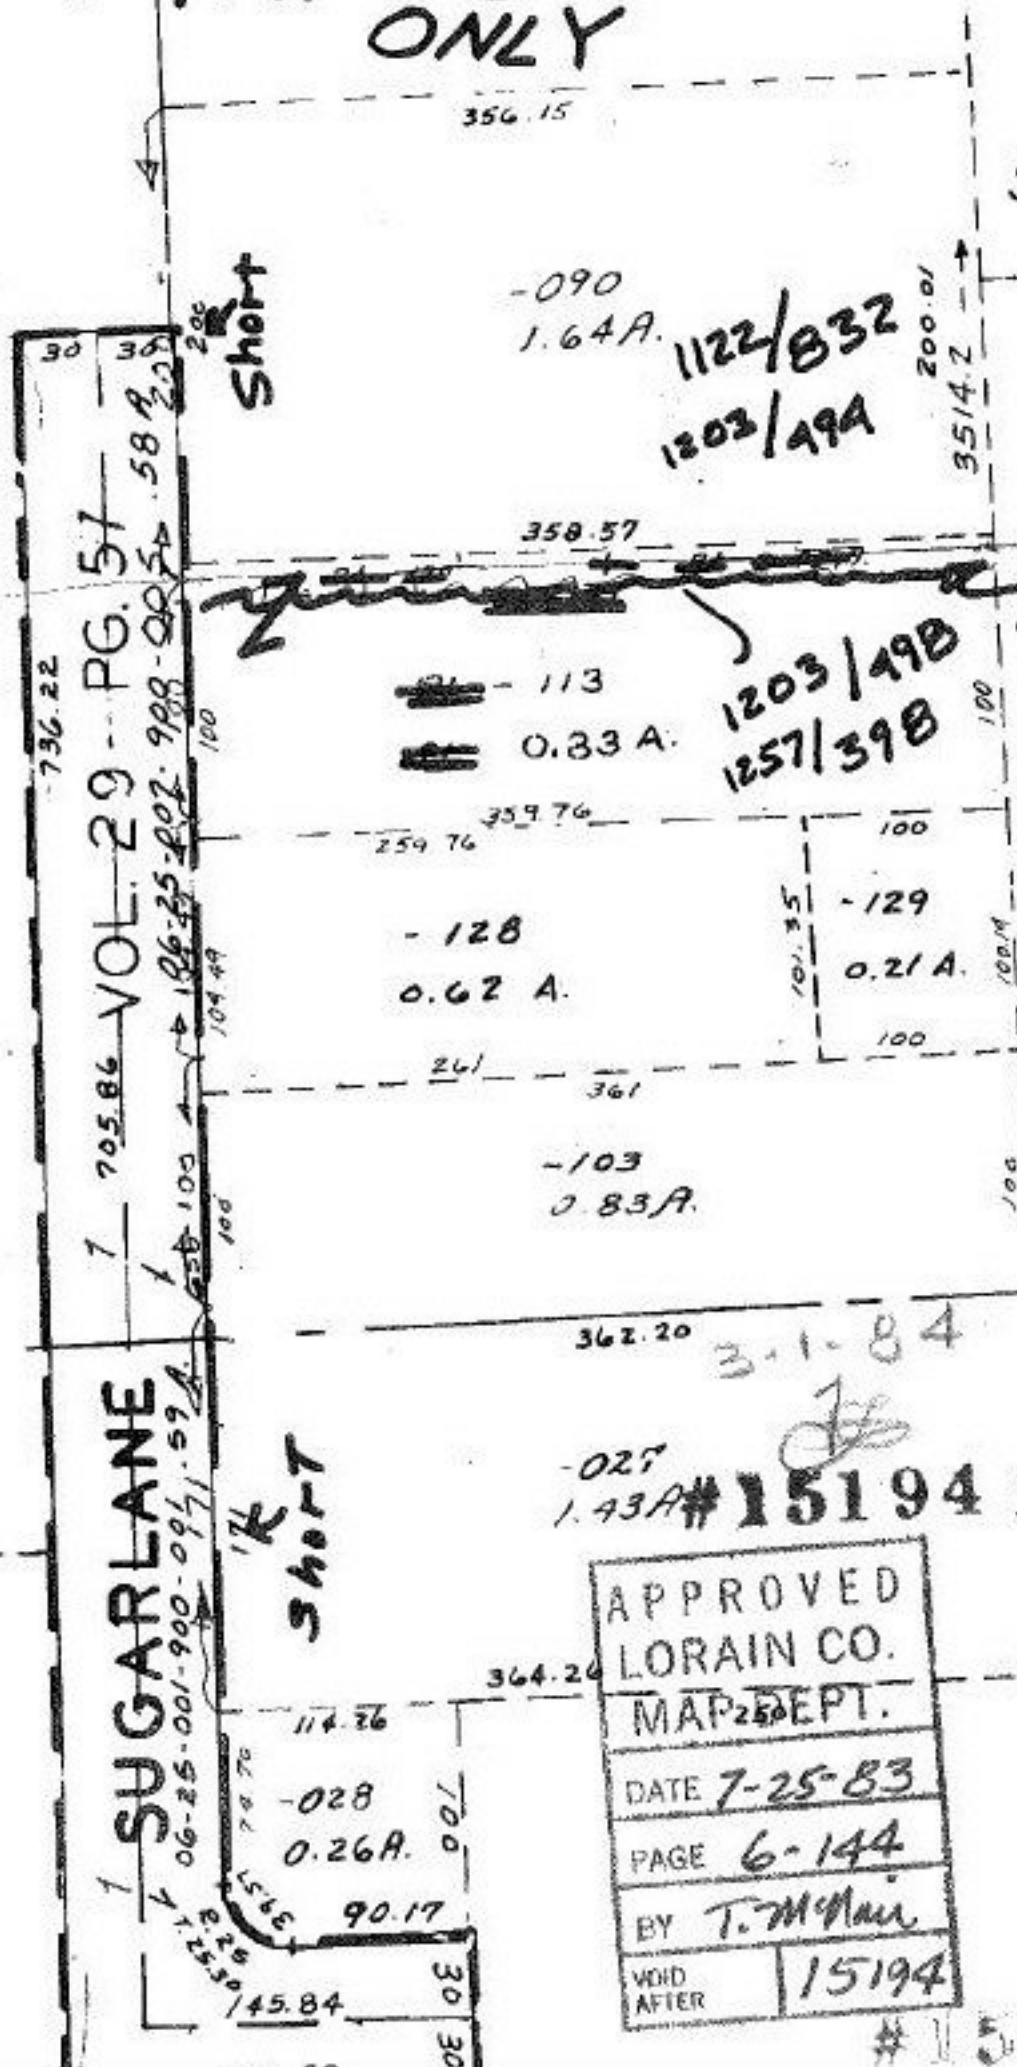

SEE 6-126

Short

Take OUT This LINE.

1
E 7

CROSS OUT INFORMATION

SUGARLANE

Short

APPROVED
LORAIN CO.
MAP DEPT.
DATE 7-25-83
PAGE 6-144
BY T. McNeil
VOID AFTER 15194

APPROVED
LORAIN CO.
MAP DEPT.
DATE 4-22-83
PAGE 6-144
BY T. McNeil
VOID AFTER

~~#15067~~

~~VOID~~
~~7-25-83~~
~~#15067~~

#15194