

6-76


1327.48
452.31
865.17

1325.01
660.31
665.

300
125
174

#152
APPROVED
LORAIN CO.
MAP DEPT.
DATE 1-29-68
6-76
D. D. Raymond

pe 6-76

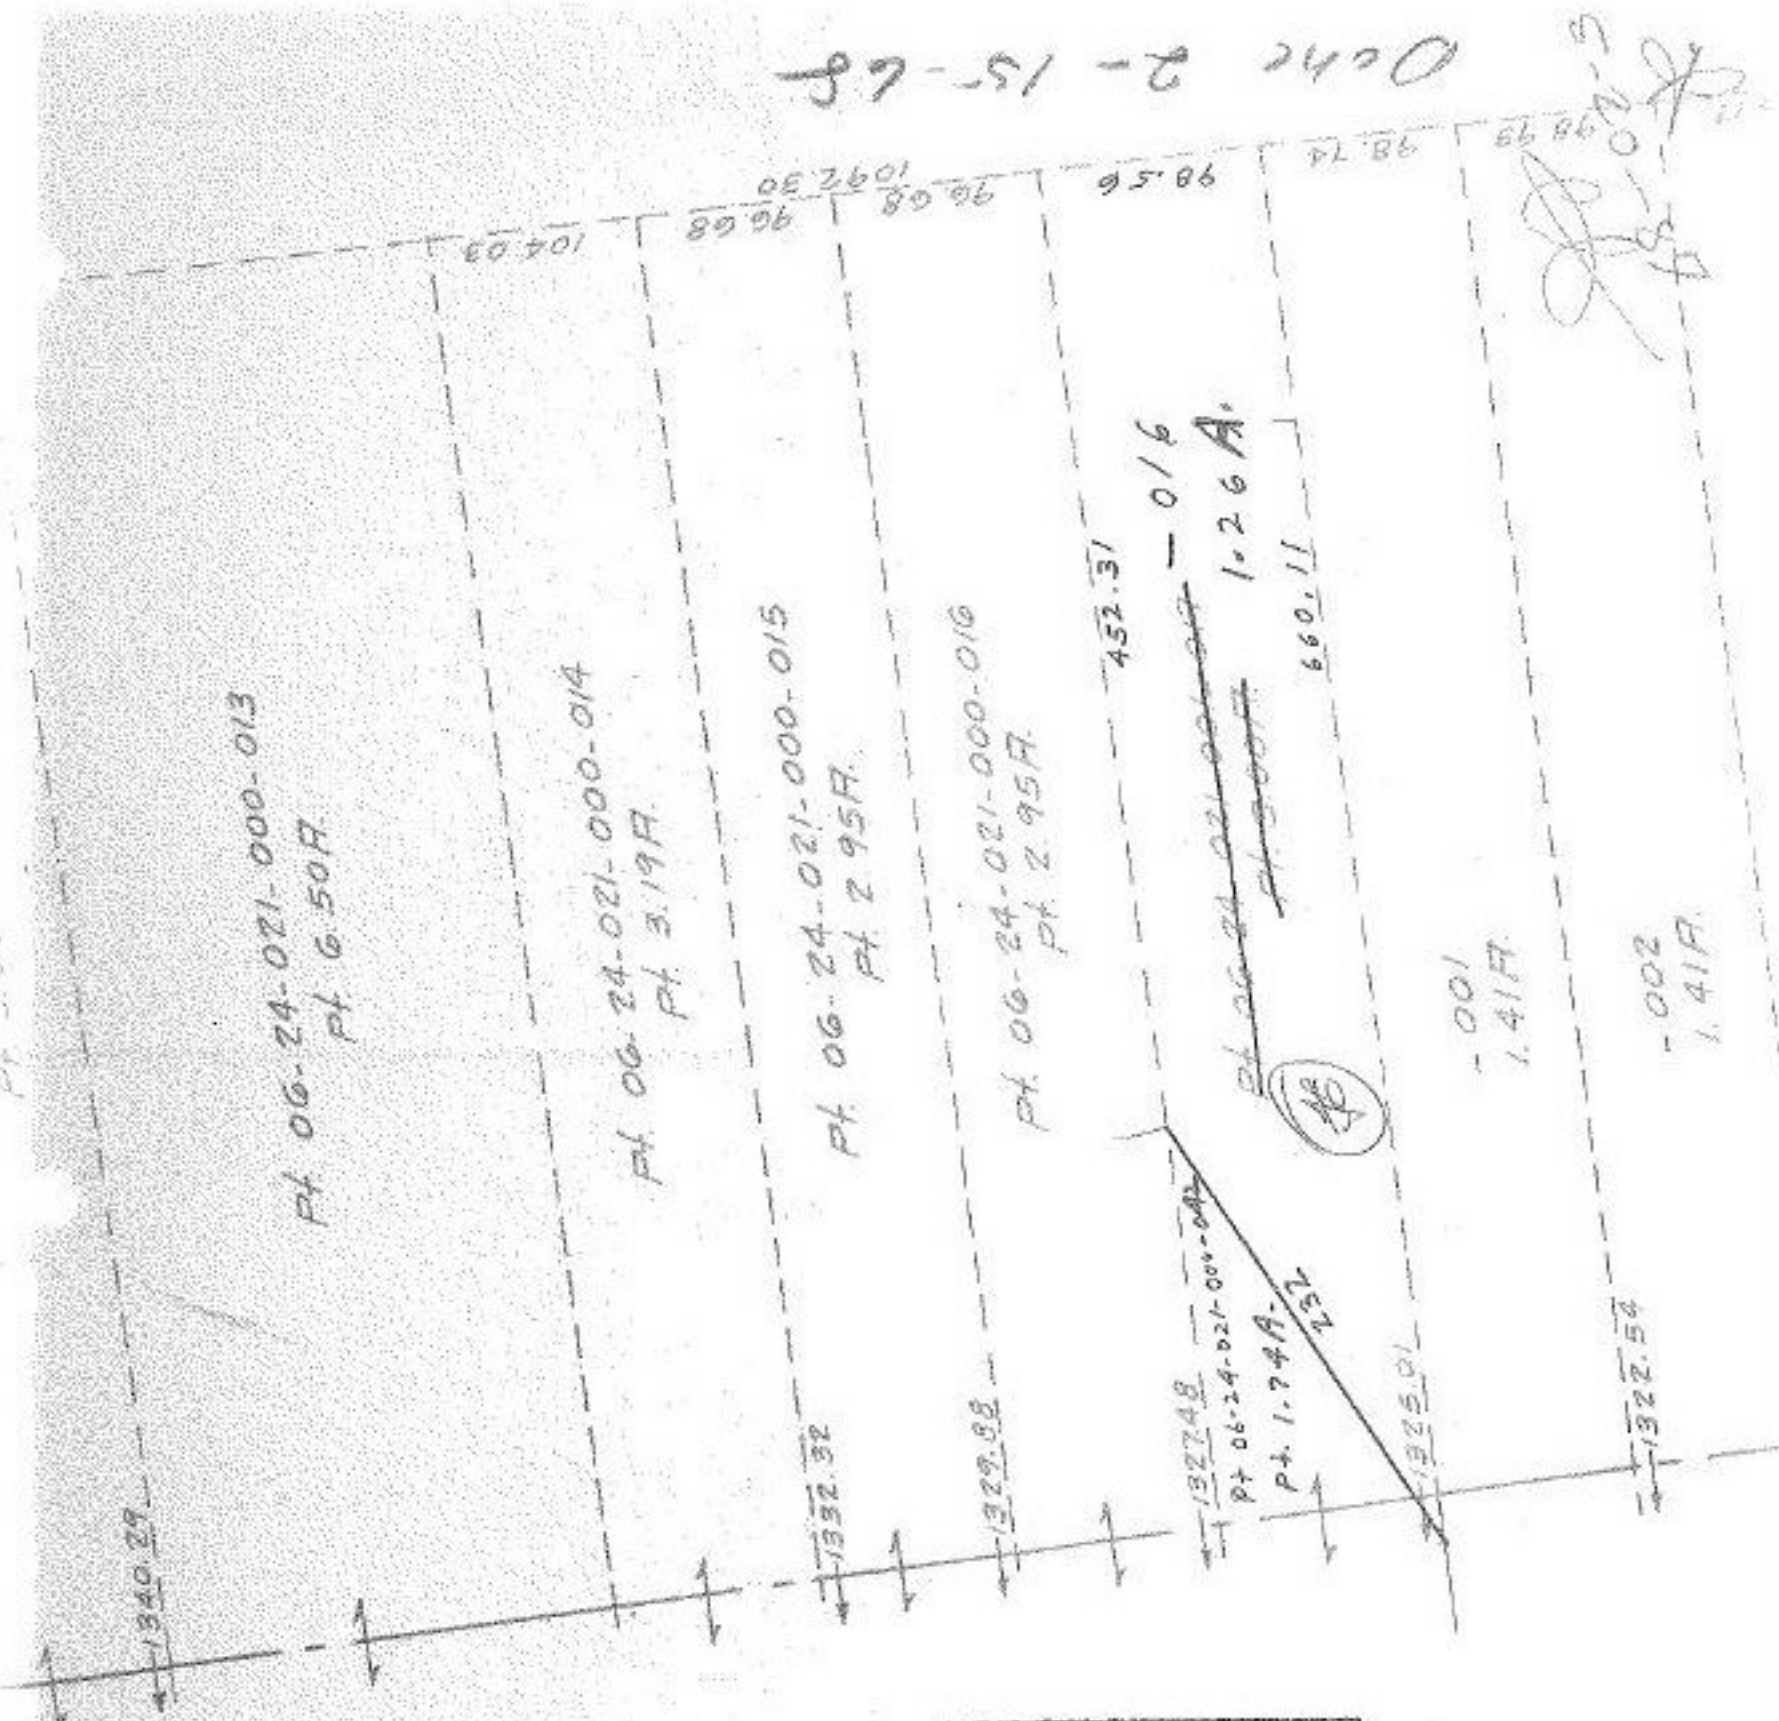

Ochc 2-15-68

Handwritten signature and scribbles.