


#152
APPROVED
 LORAIN CO.
 MAP DEPT.
 DATE 1-29-68
 6-75
 BY *D. Maynard*

** Done 2-15-68
 L.W. Hall*

pg 6-75

19/2

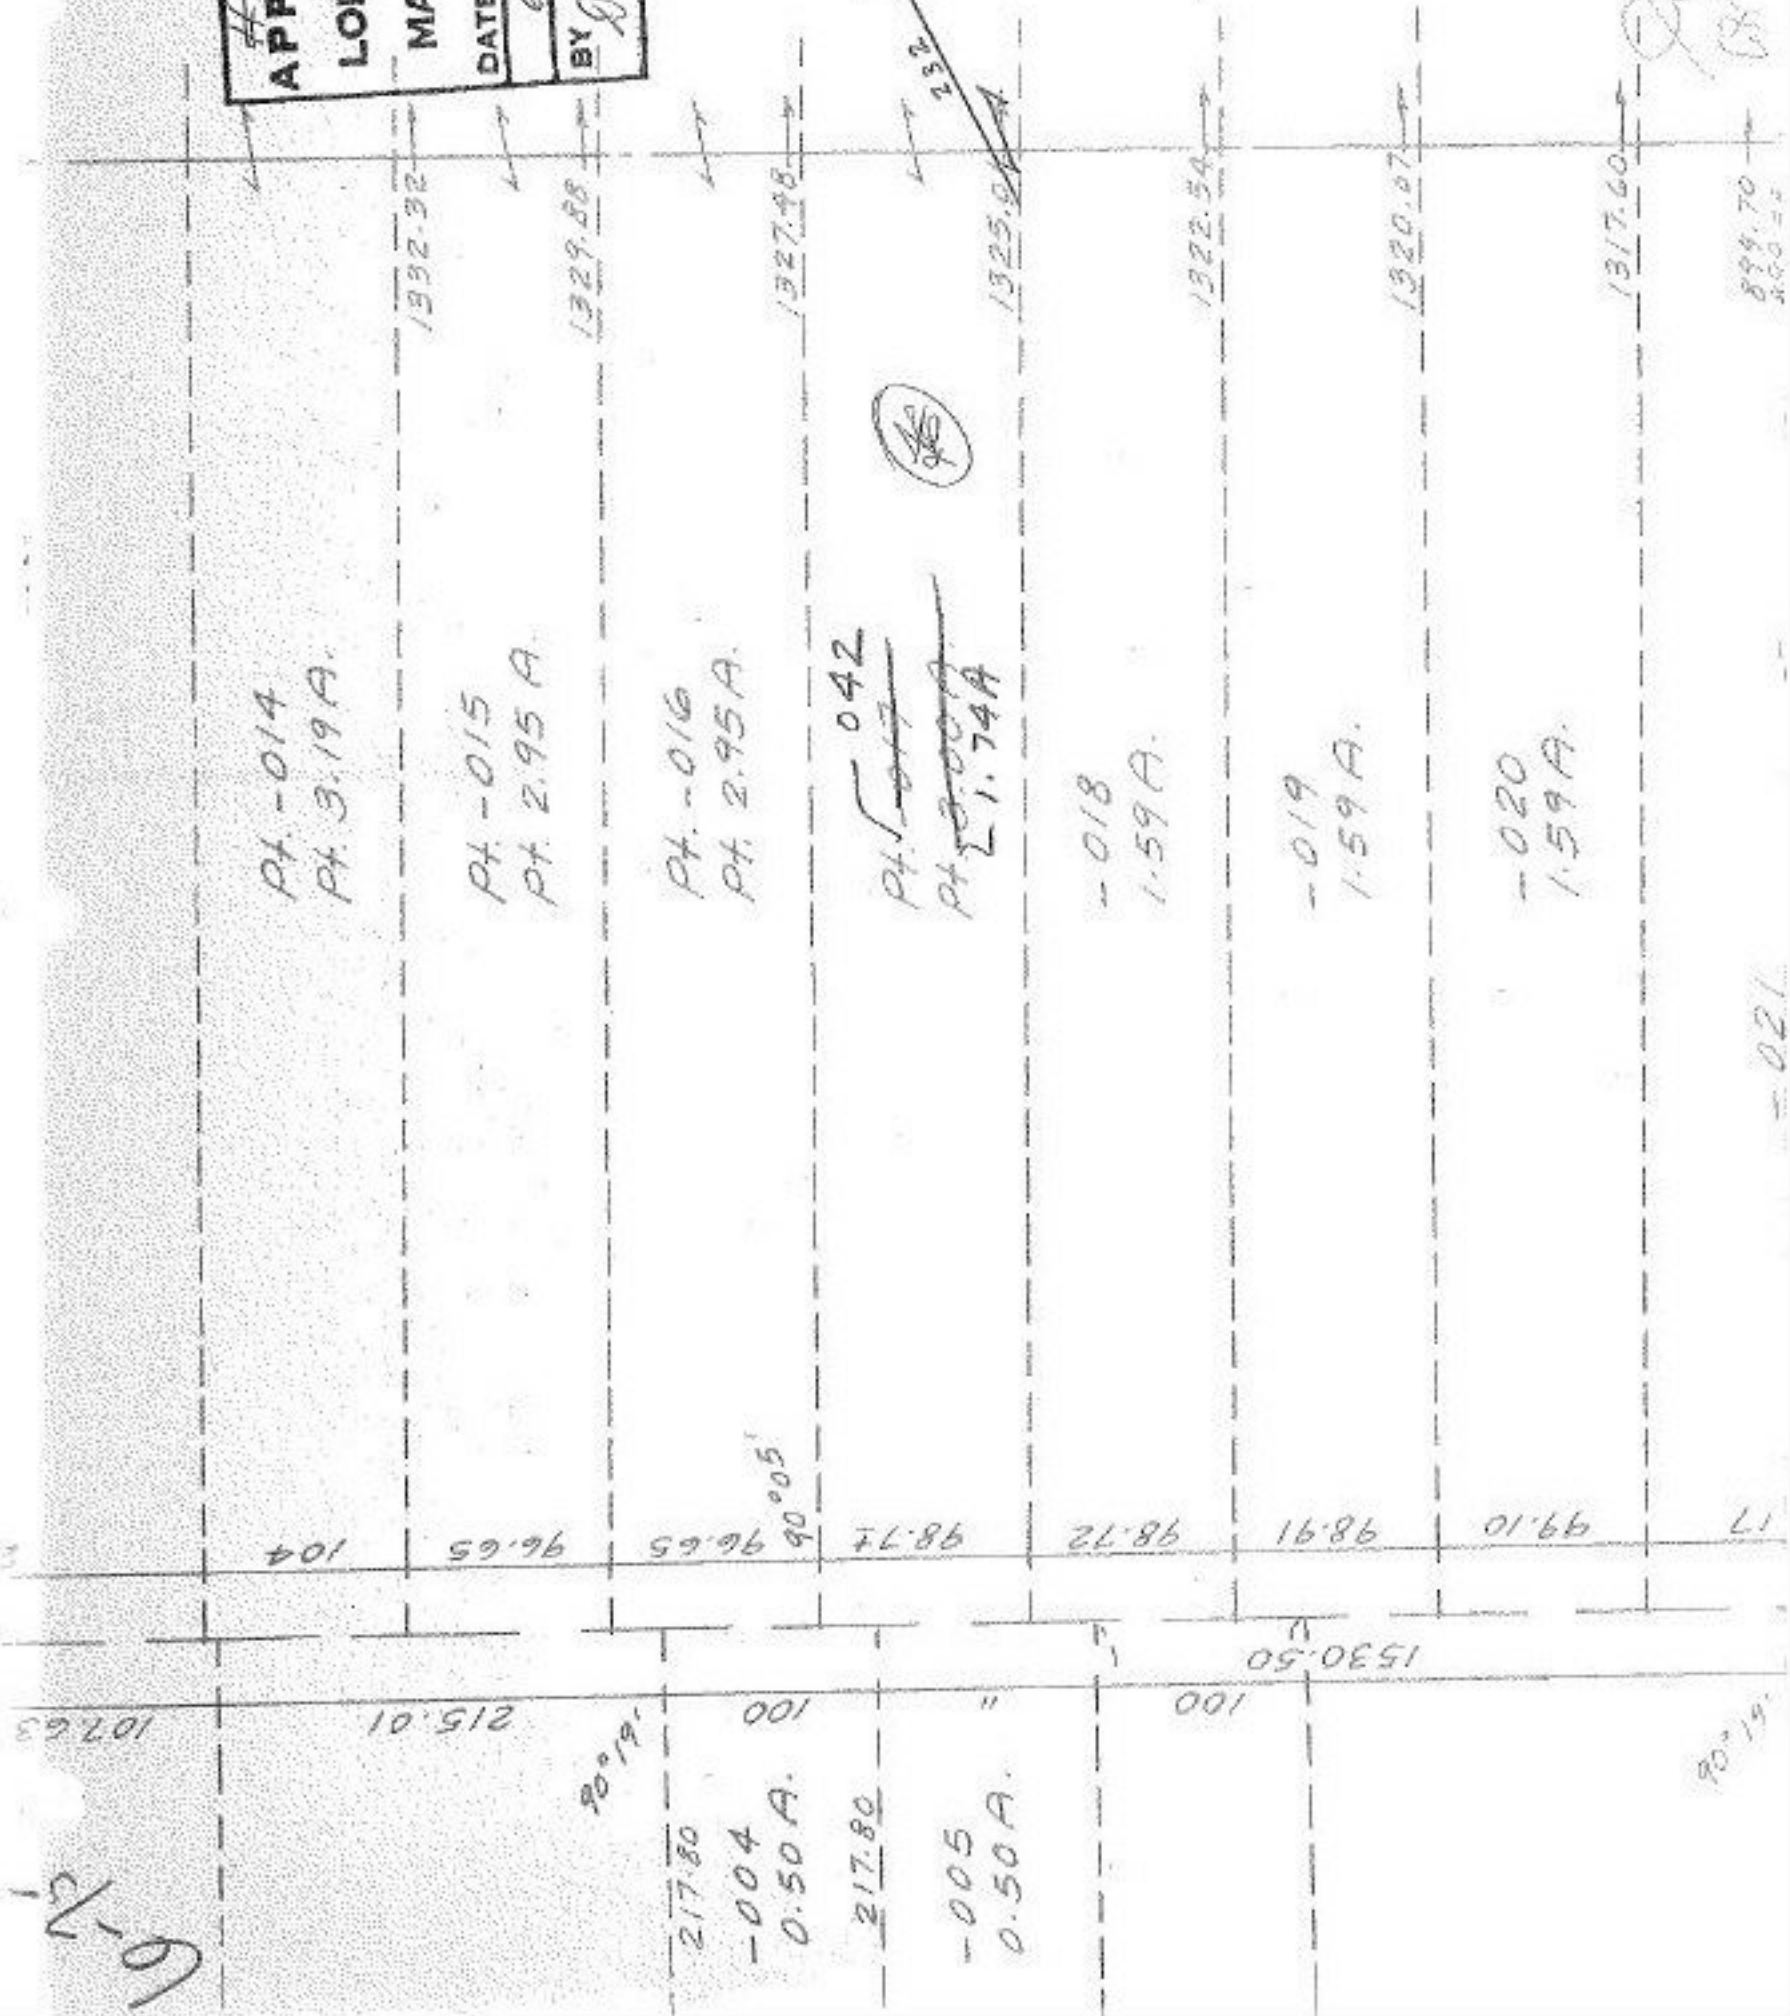

90°19'

-021

*899.70
 300.00*

D. Maynard