


SEE 10-00-003-D

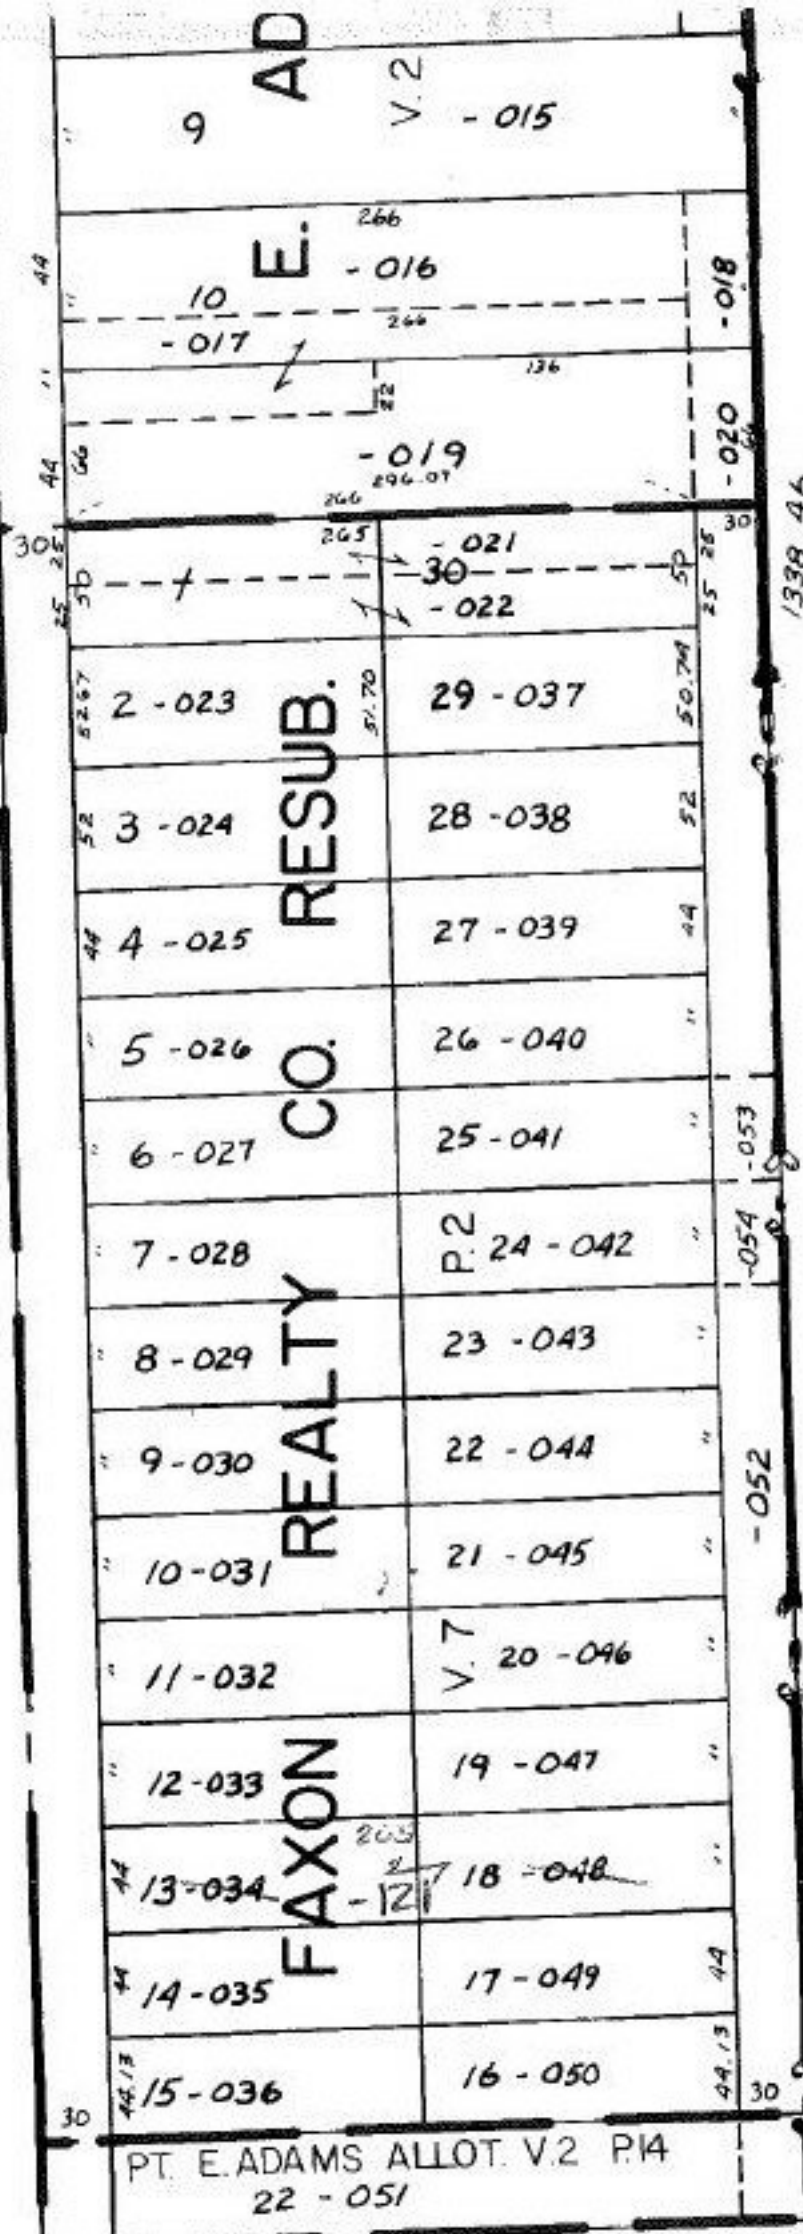

COMBINATION
#15220

APPROVED
LORAIN CO.
MAP DEPT.

DATE 8.24.83
PAGE 10.00.004A
BY T. McNamee
VOID
AFTER

9-17-85