


SEE SURVEY A. KOEPP

SEE 12-00-043-A

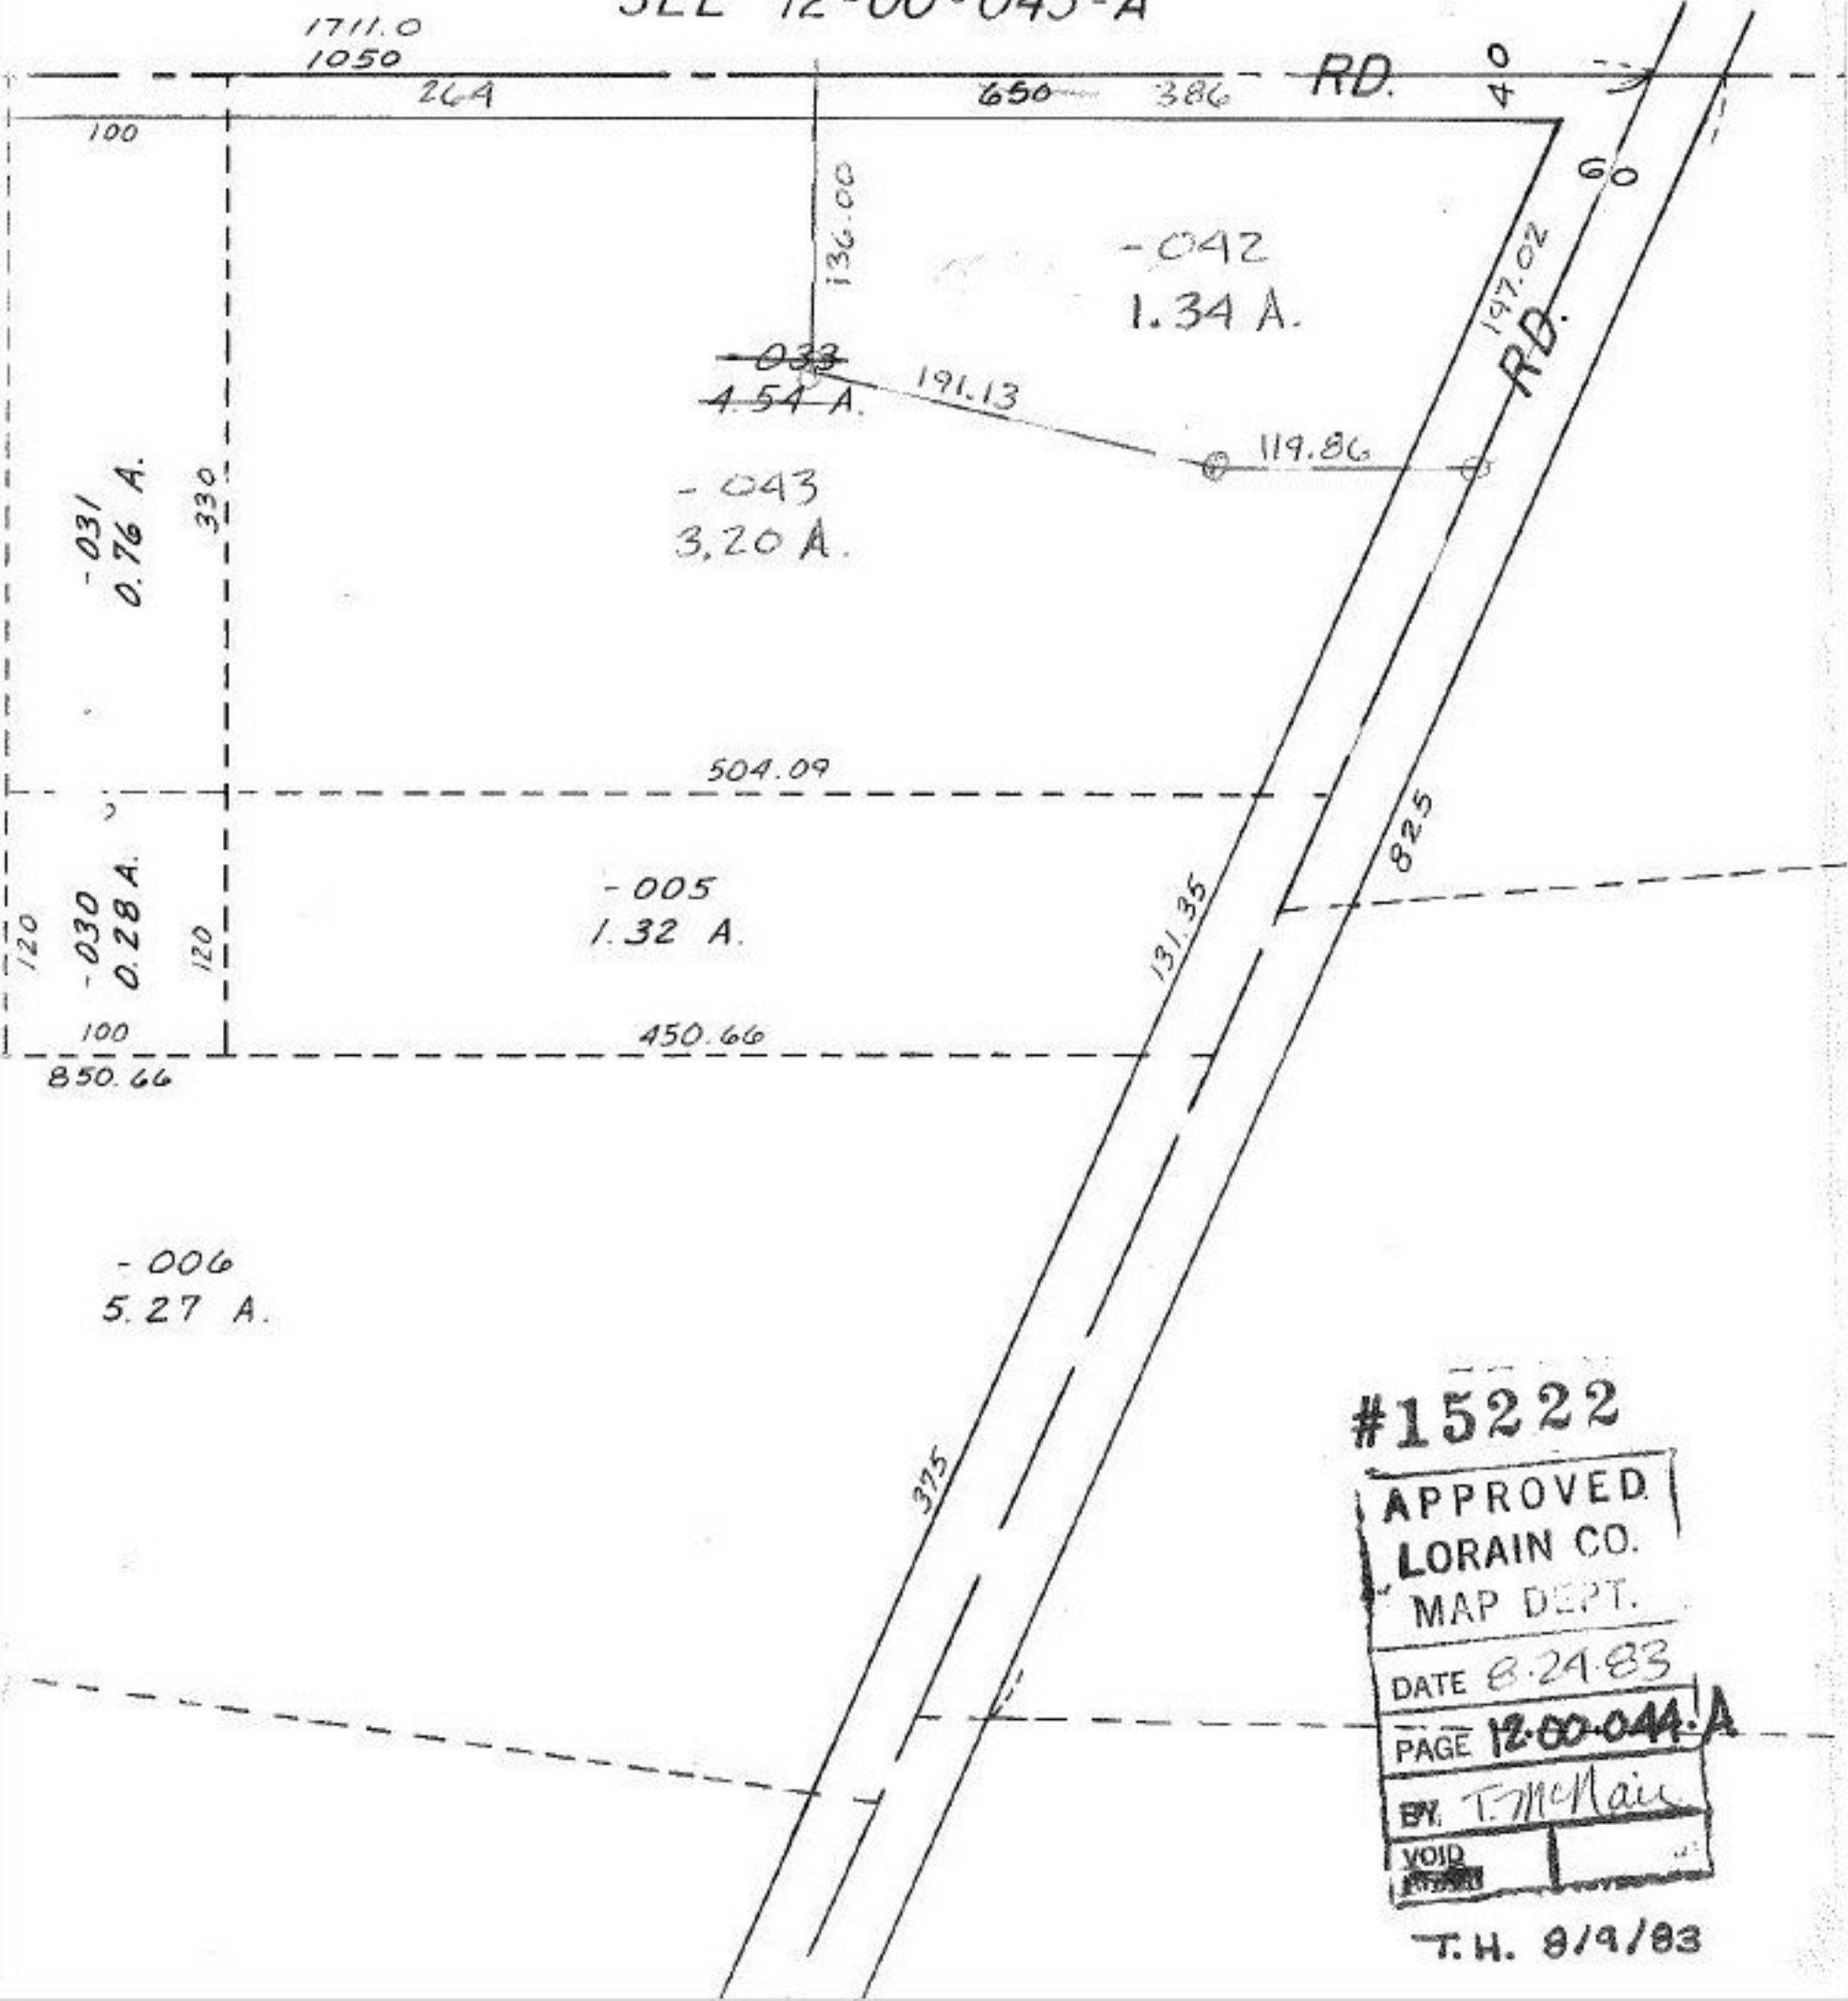

#15222

APPROVED  
LORAIN CO.  
MAP DEPT.

DATE 8-24-83

PAGE 12-00-044-A

BY T. McNamee

VOID

T.H. 8/9/83