


SEE SURVEY OF ENTIRE AREA  
COWLEY KLEINDECKER - SCHMIDT & ASSOC.

02  
00 A.

RU 13  
33  
50



RD.

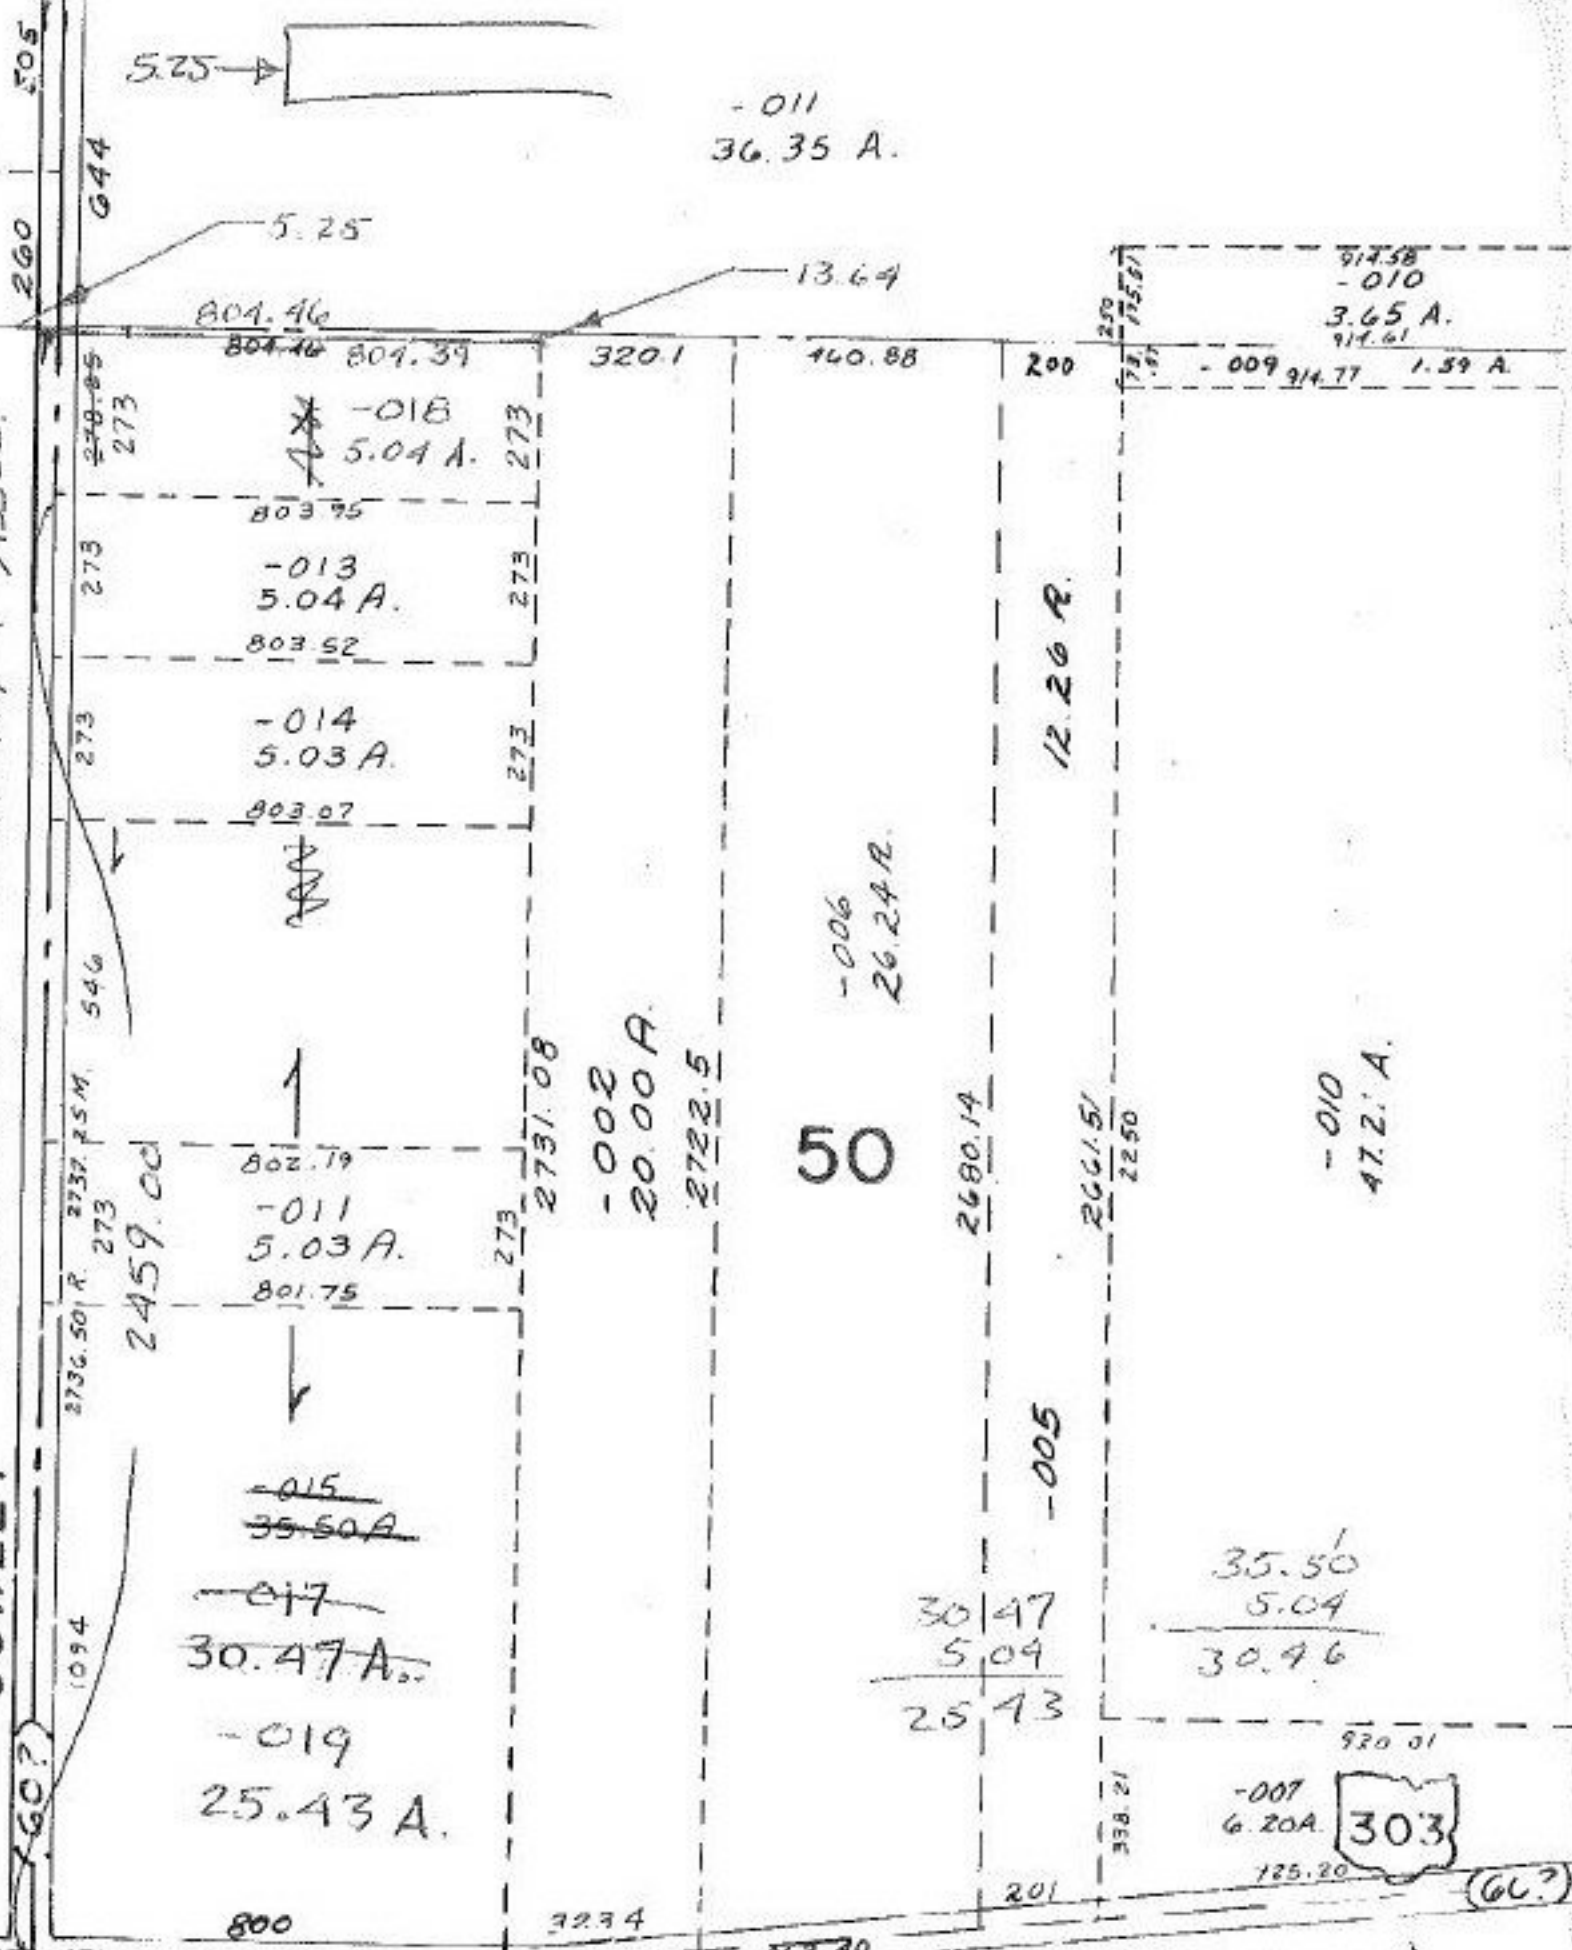

#15225

APPROVED. Copyright  
LORAIN CO. 5-26  
MAP DEPT. 16

DATE 8-26-83

PAGE 16-D

BY T. McVain

VOID AFTER

T.H. 7/18/84