


12
90A.

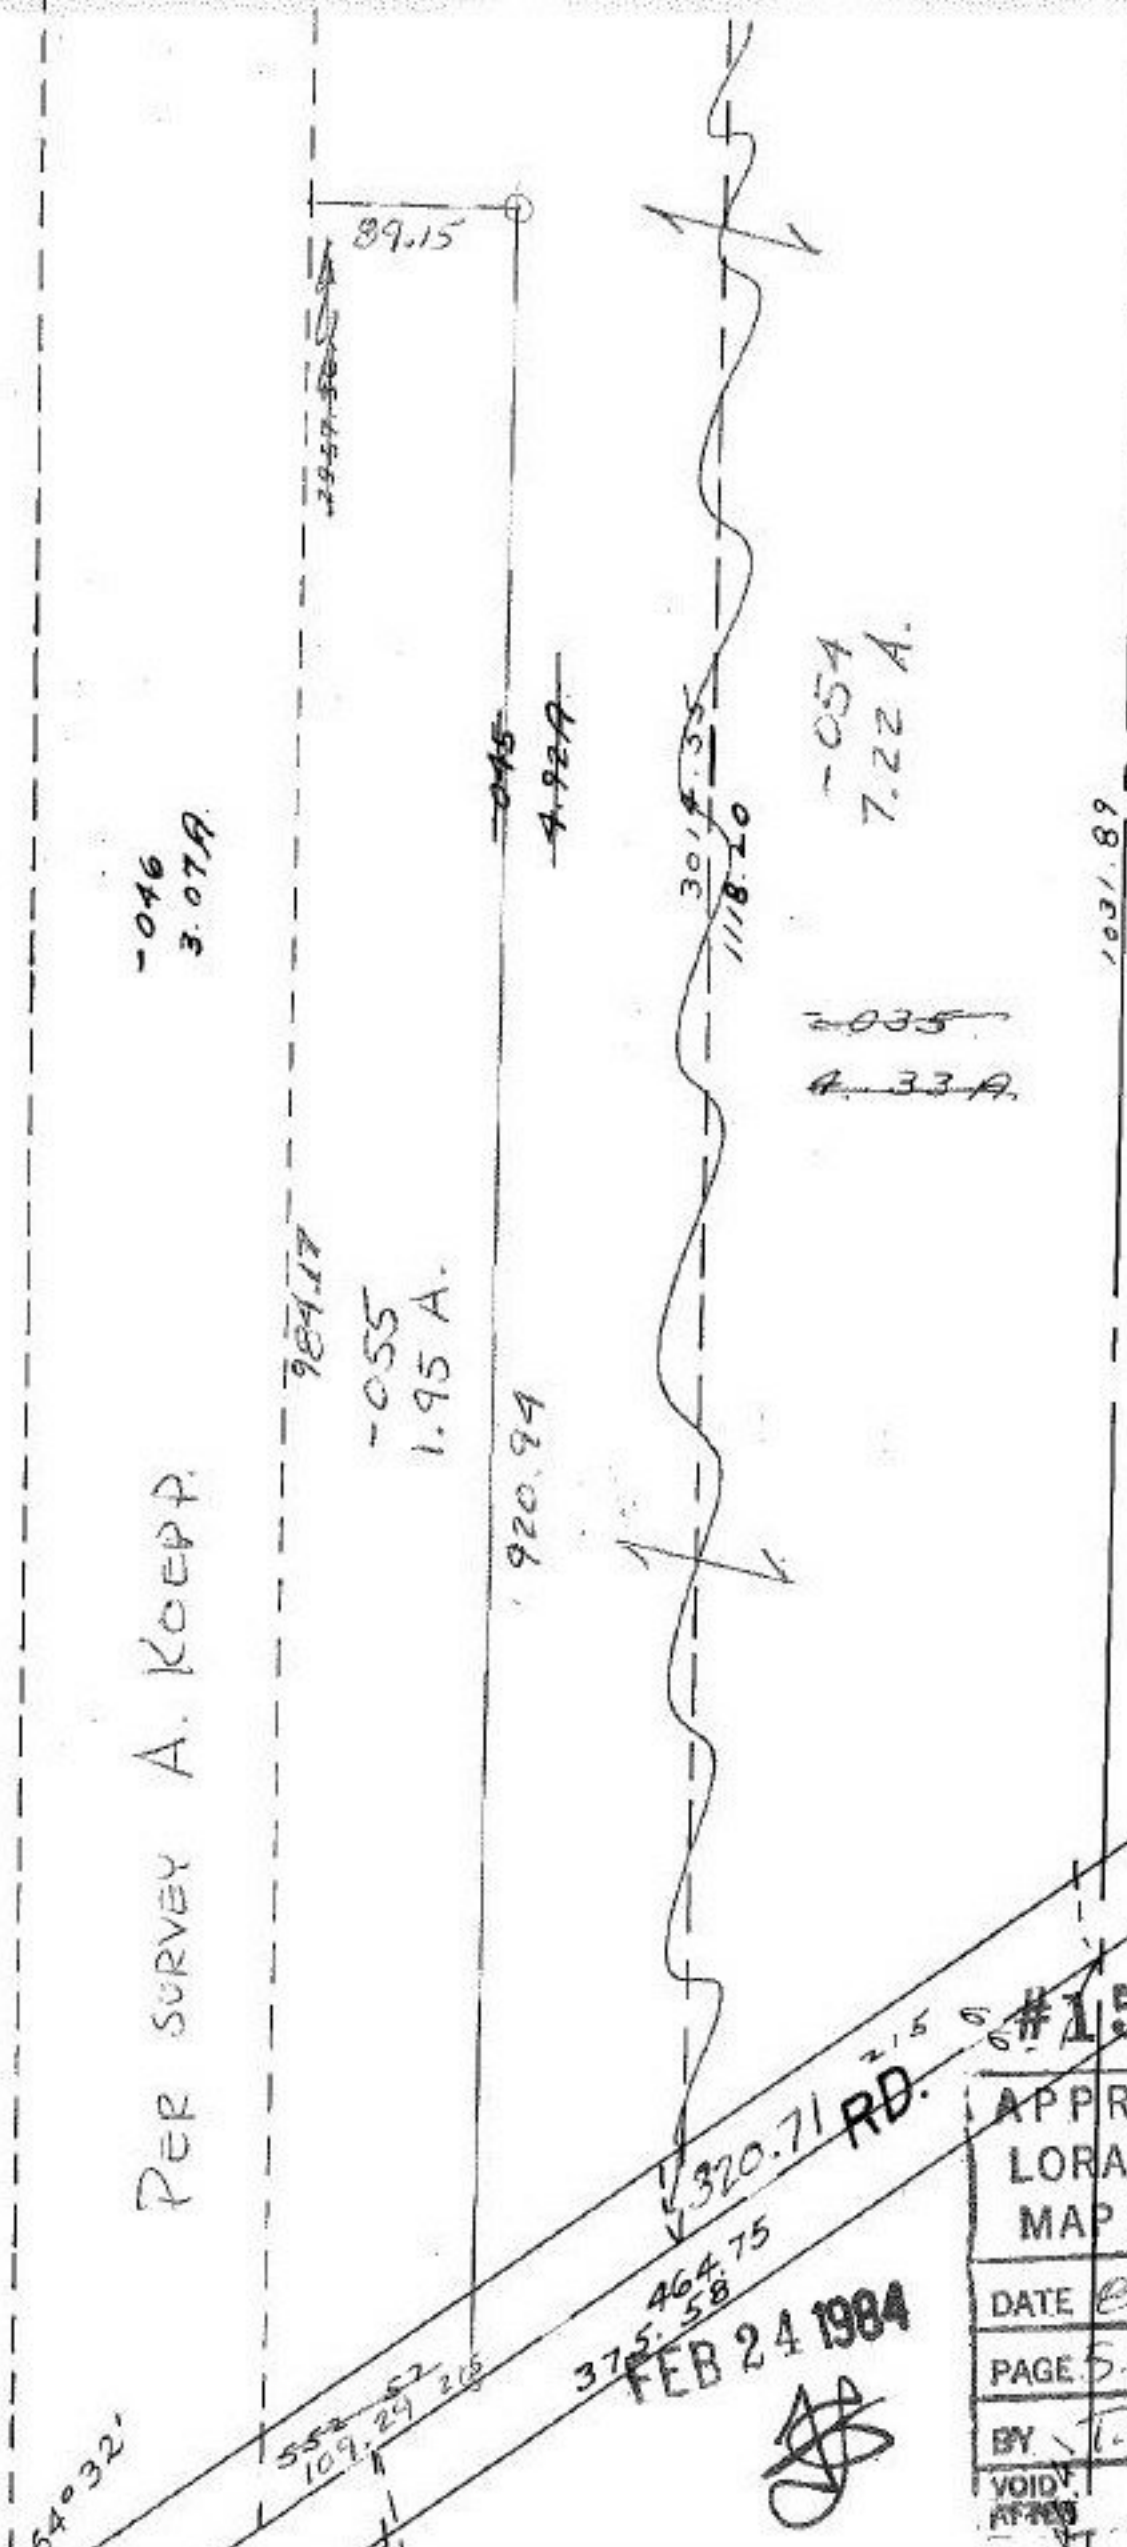

9.25
7.22

2.03

PER SURVEY A. KOEPP.



#15228

APPROVED LORAIN CO. MAP DEPT.	
DATE	8.29.83
PAGE	5-00-029-3
BY	T. McHain
VOID	

FEB 24 1984

[Signature]

E 5-00-032-A