


SURVEYED BY - MARTINI HAPONEK & ASSOC.

N. Y. C. R. R.

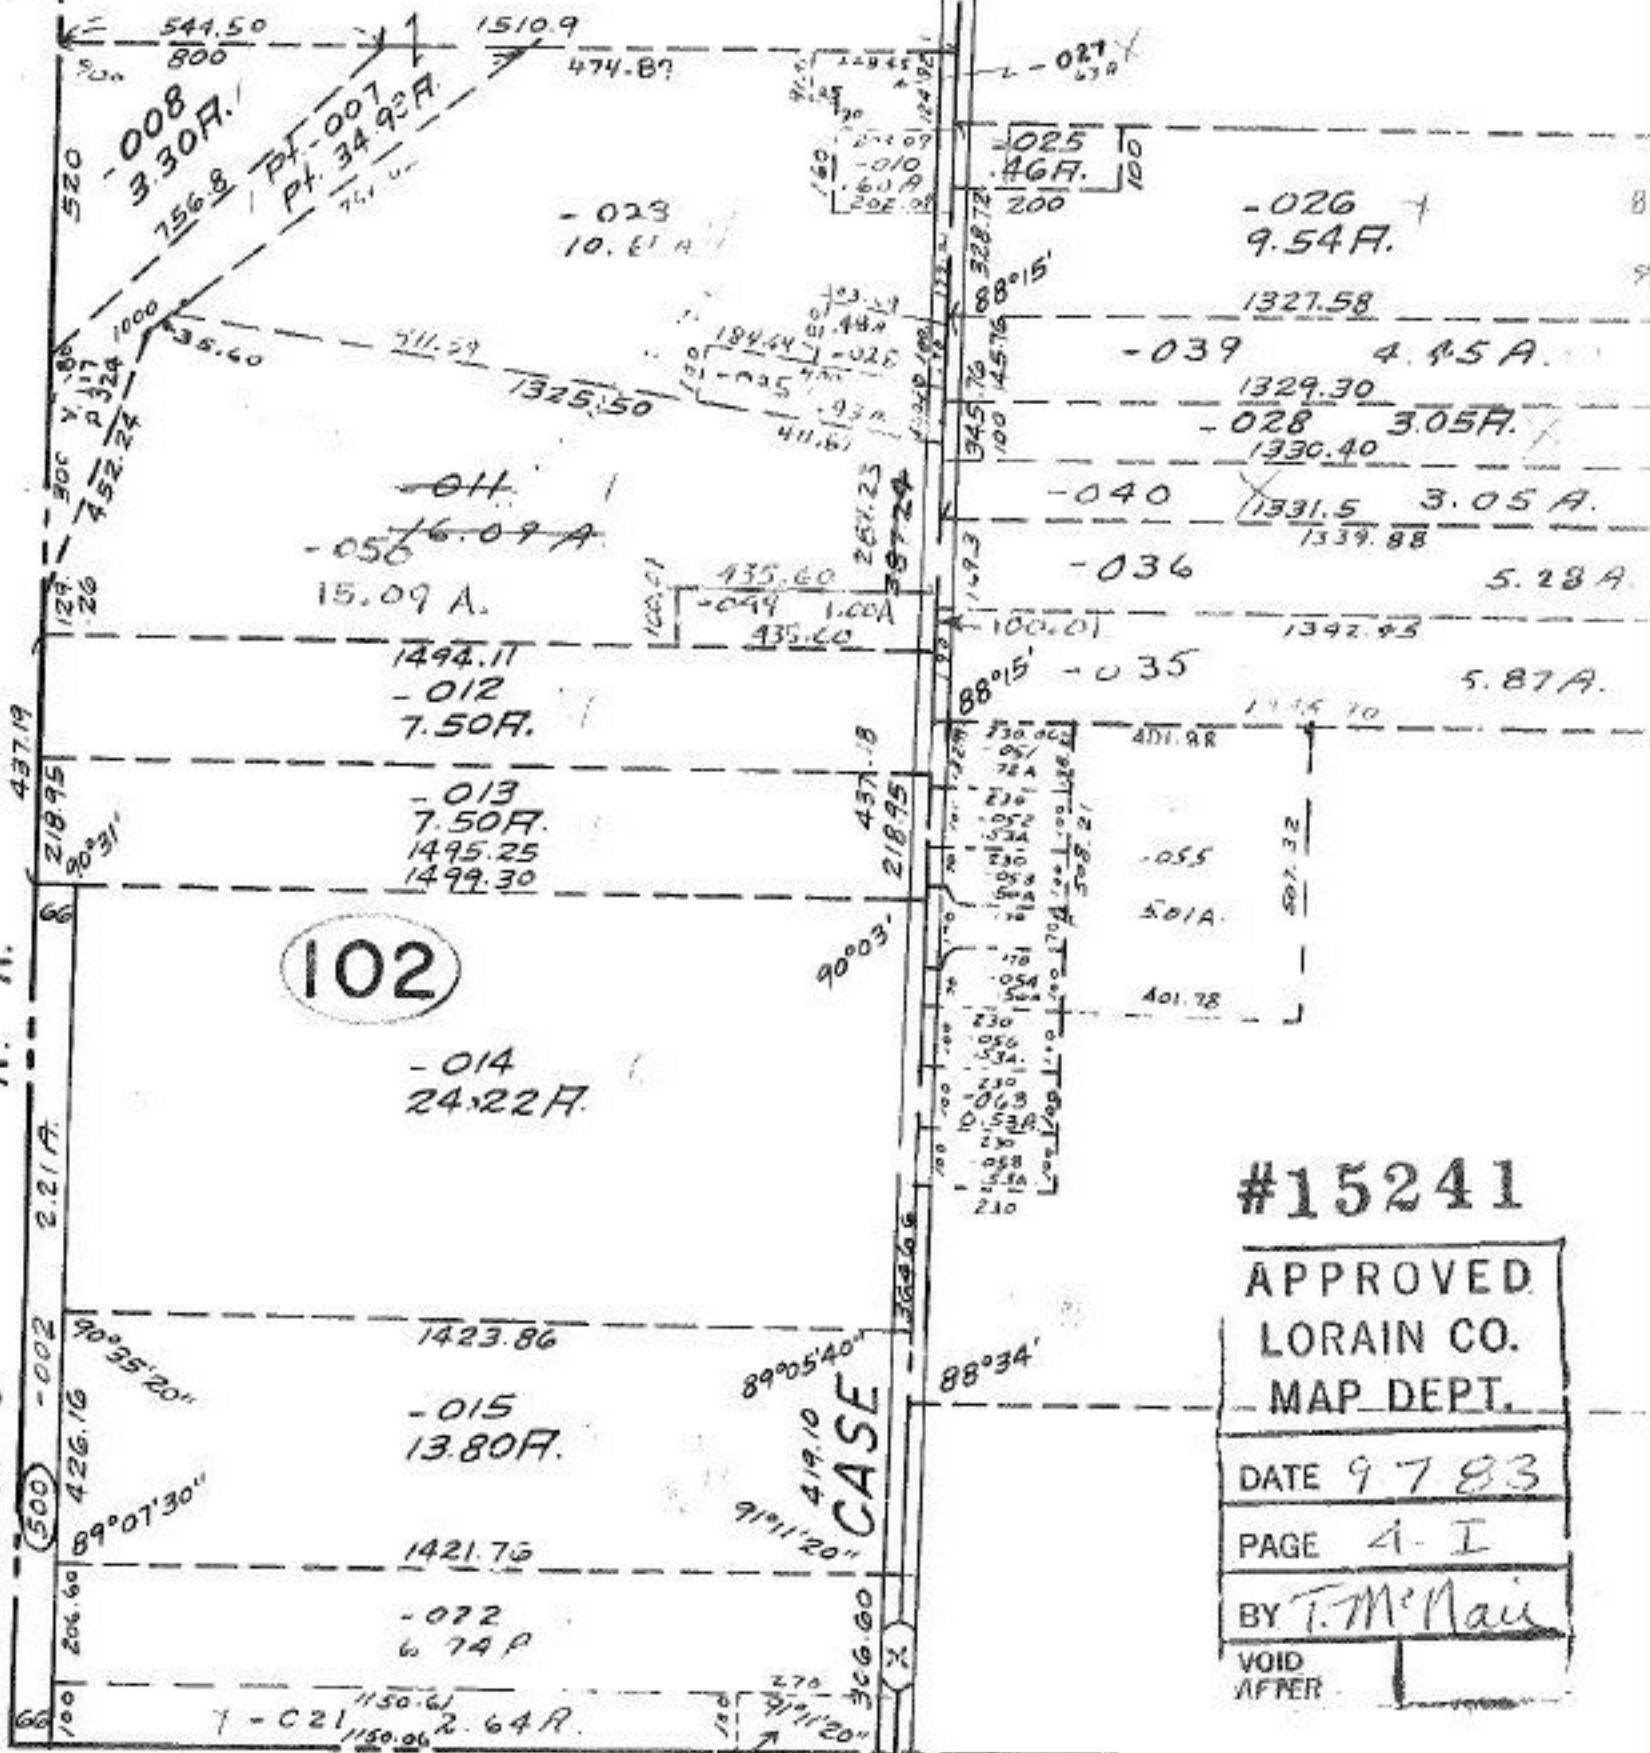

#15241

APPROVED  
LORAIN CO.  
MAP DEPT.

DATE 9 7 83

PAGE 4-I

BY T. McNeil

VOID  
AFTER

T.H. 3/13/85 SEE

AVON CITY