


SEE 5-00-002-B

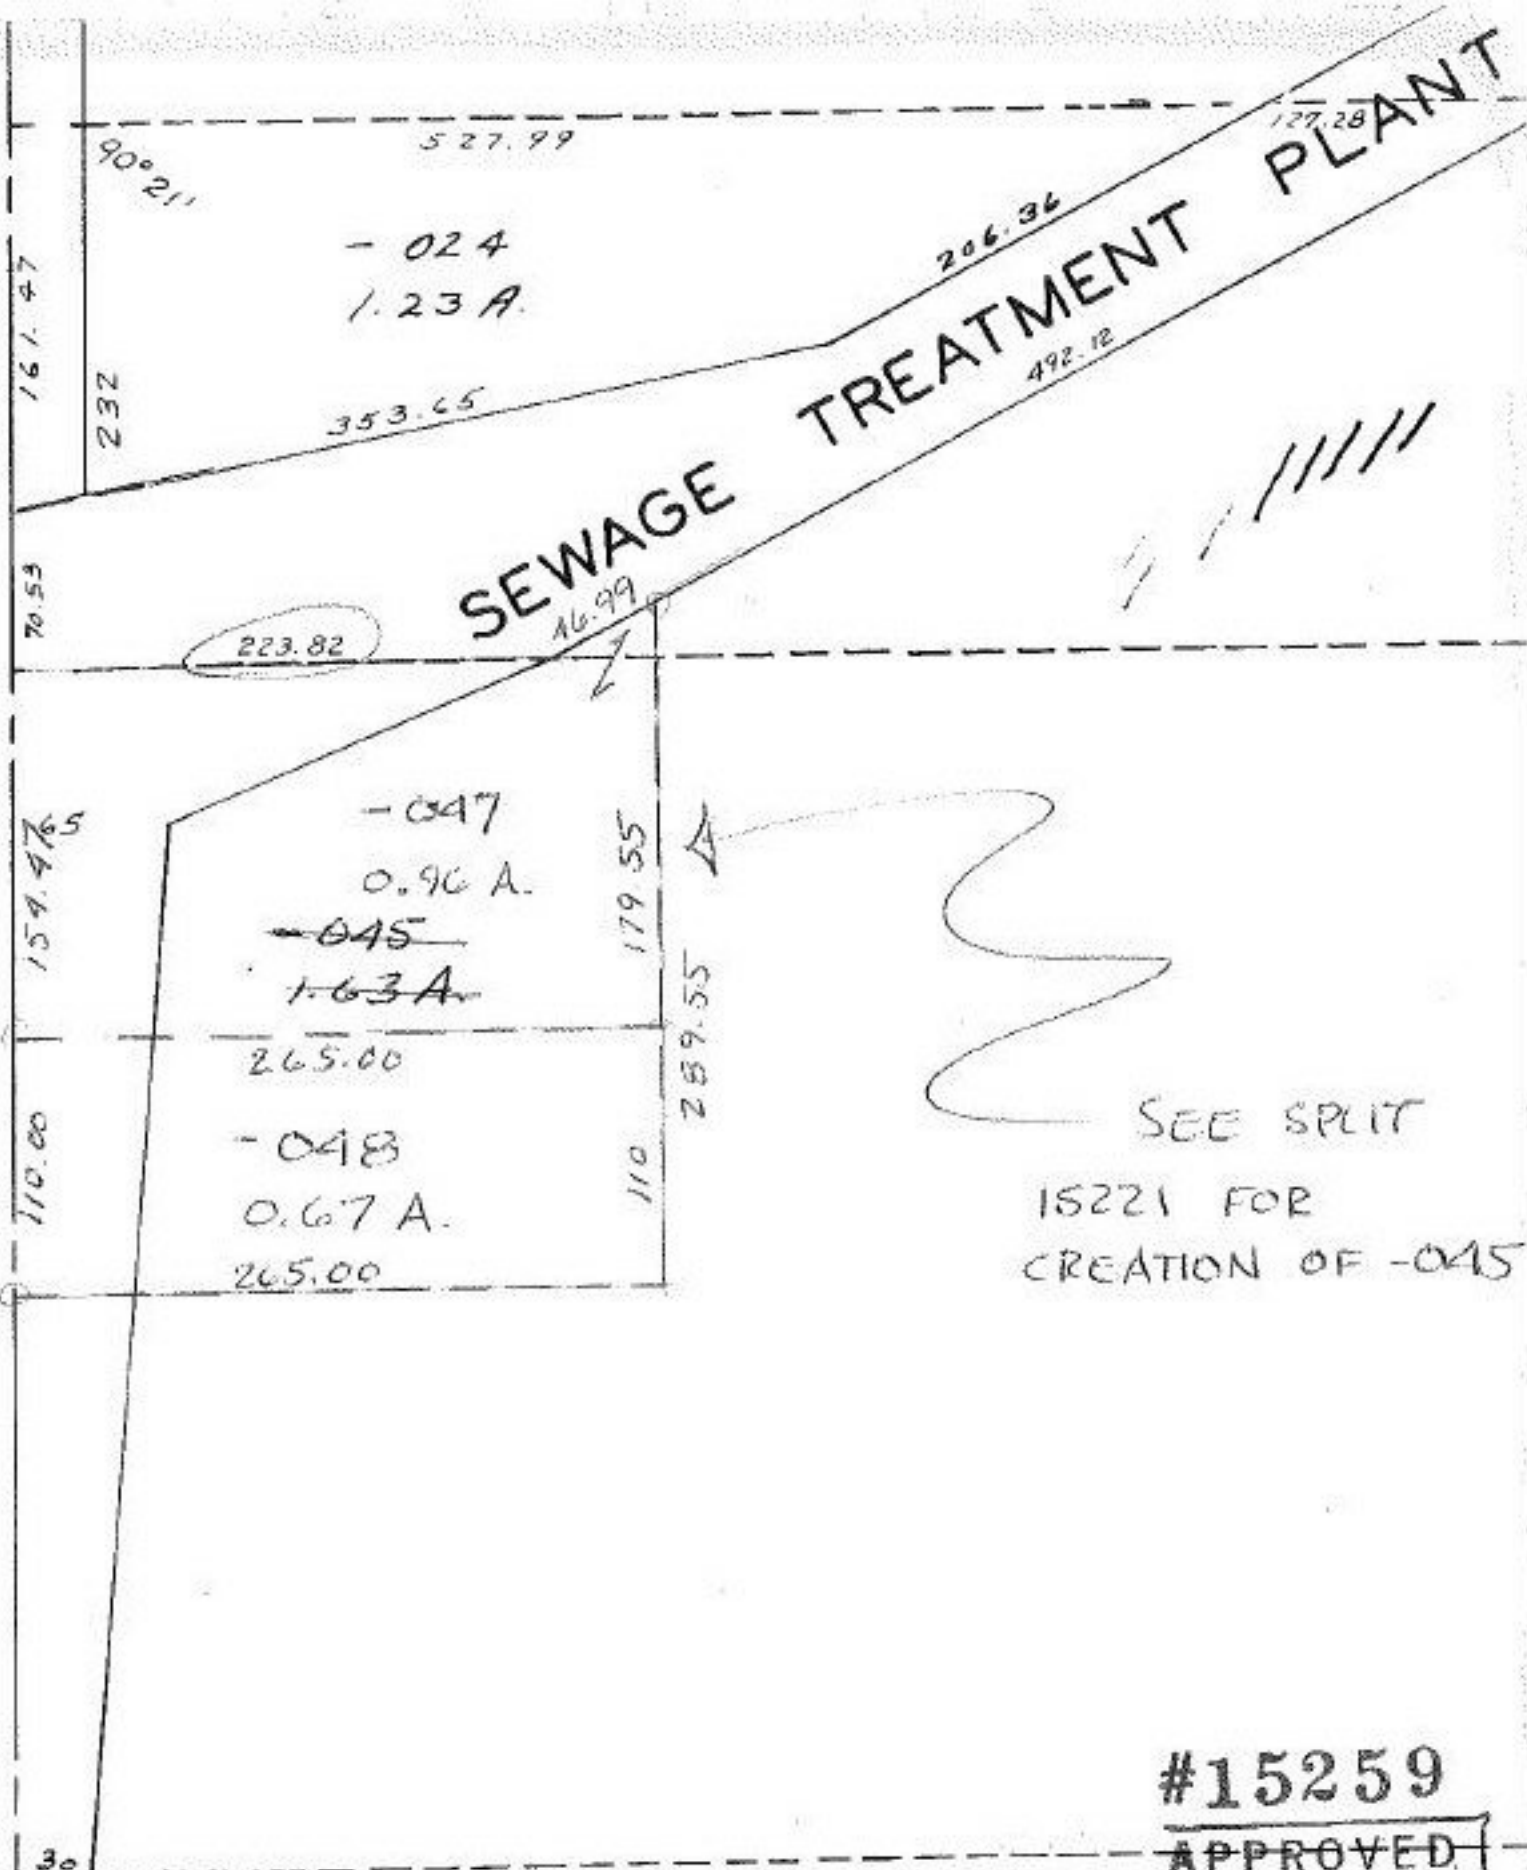

SEWAGE TREATMENT PLANT

SEE SPLIT
15221 FOR
CREATION OF -045

#15259

APPROVED
LORAIN CO.
MAP DEPT.

FEB 24 1984

DATE 9.13.83

PAGE 5-00-019-A

BY T. McMan

VOID AFTER

5-00-019-A

SEE SPLIT
TICKET #15221