


SEE 10-00-005-D

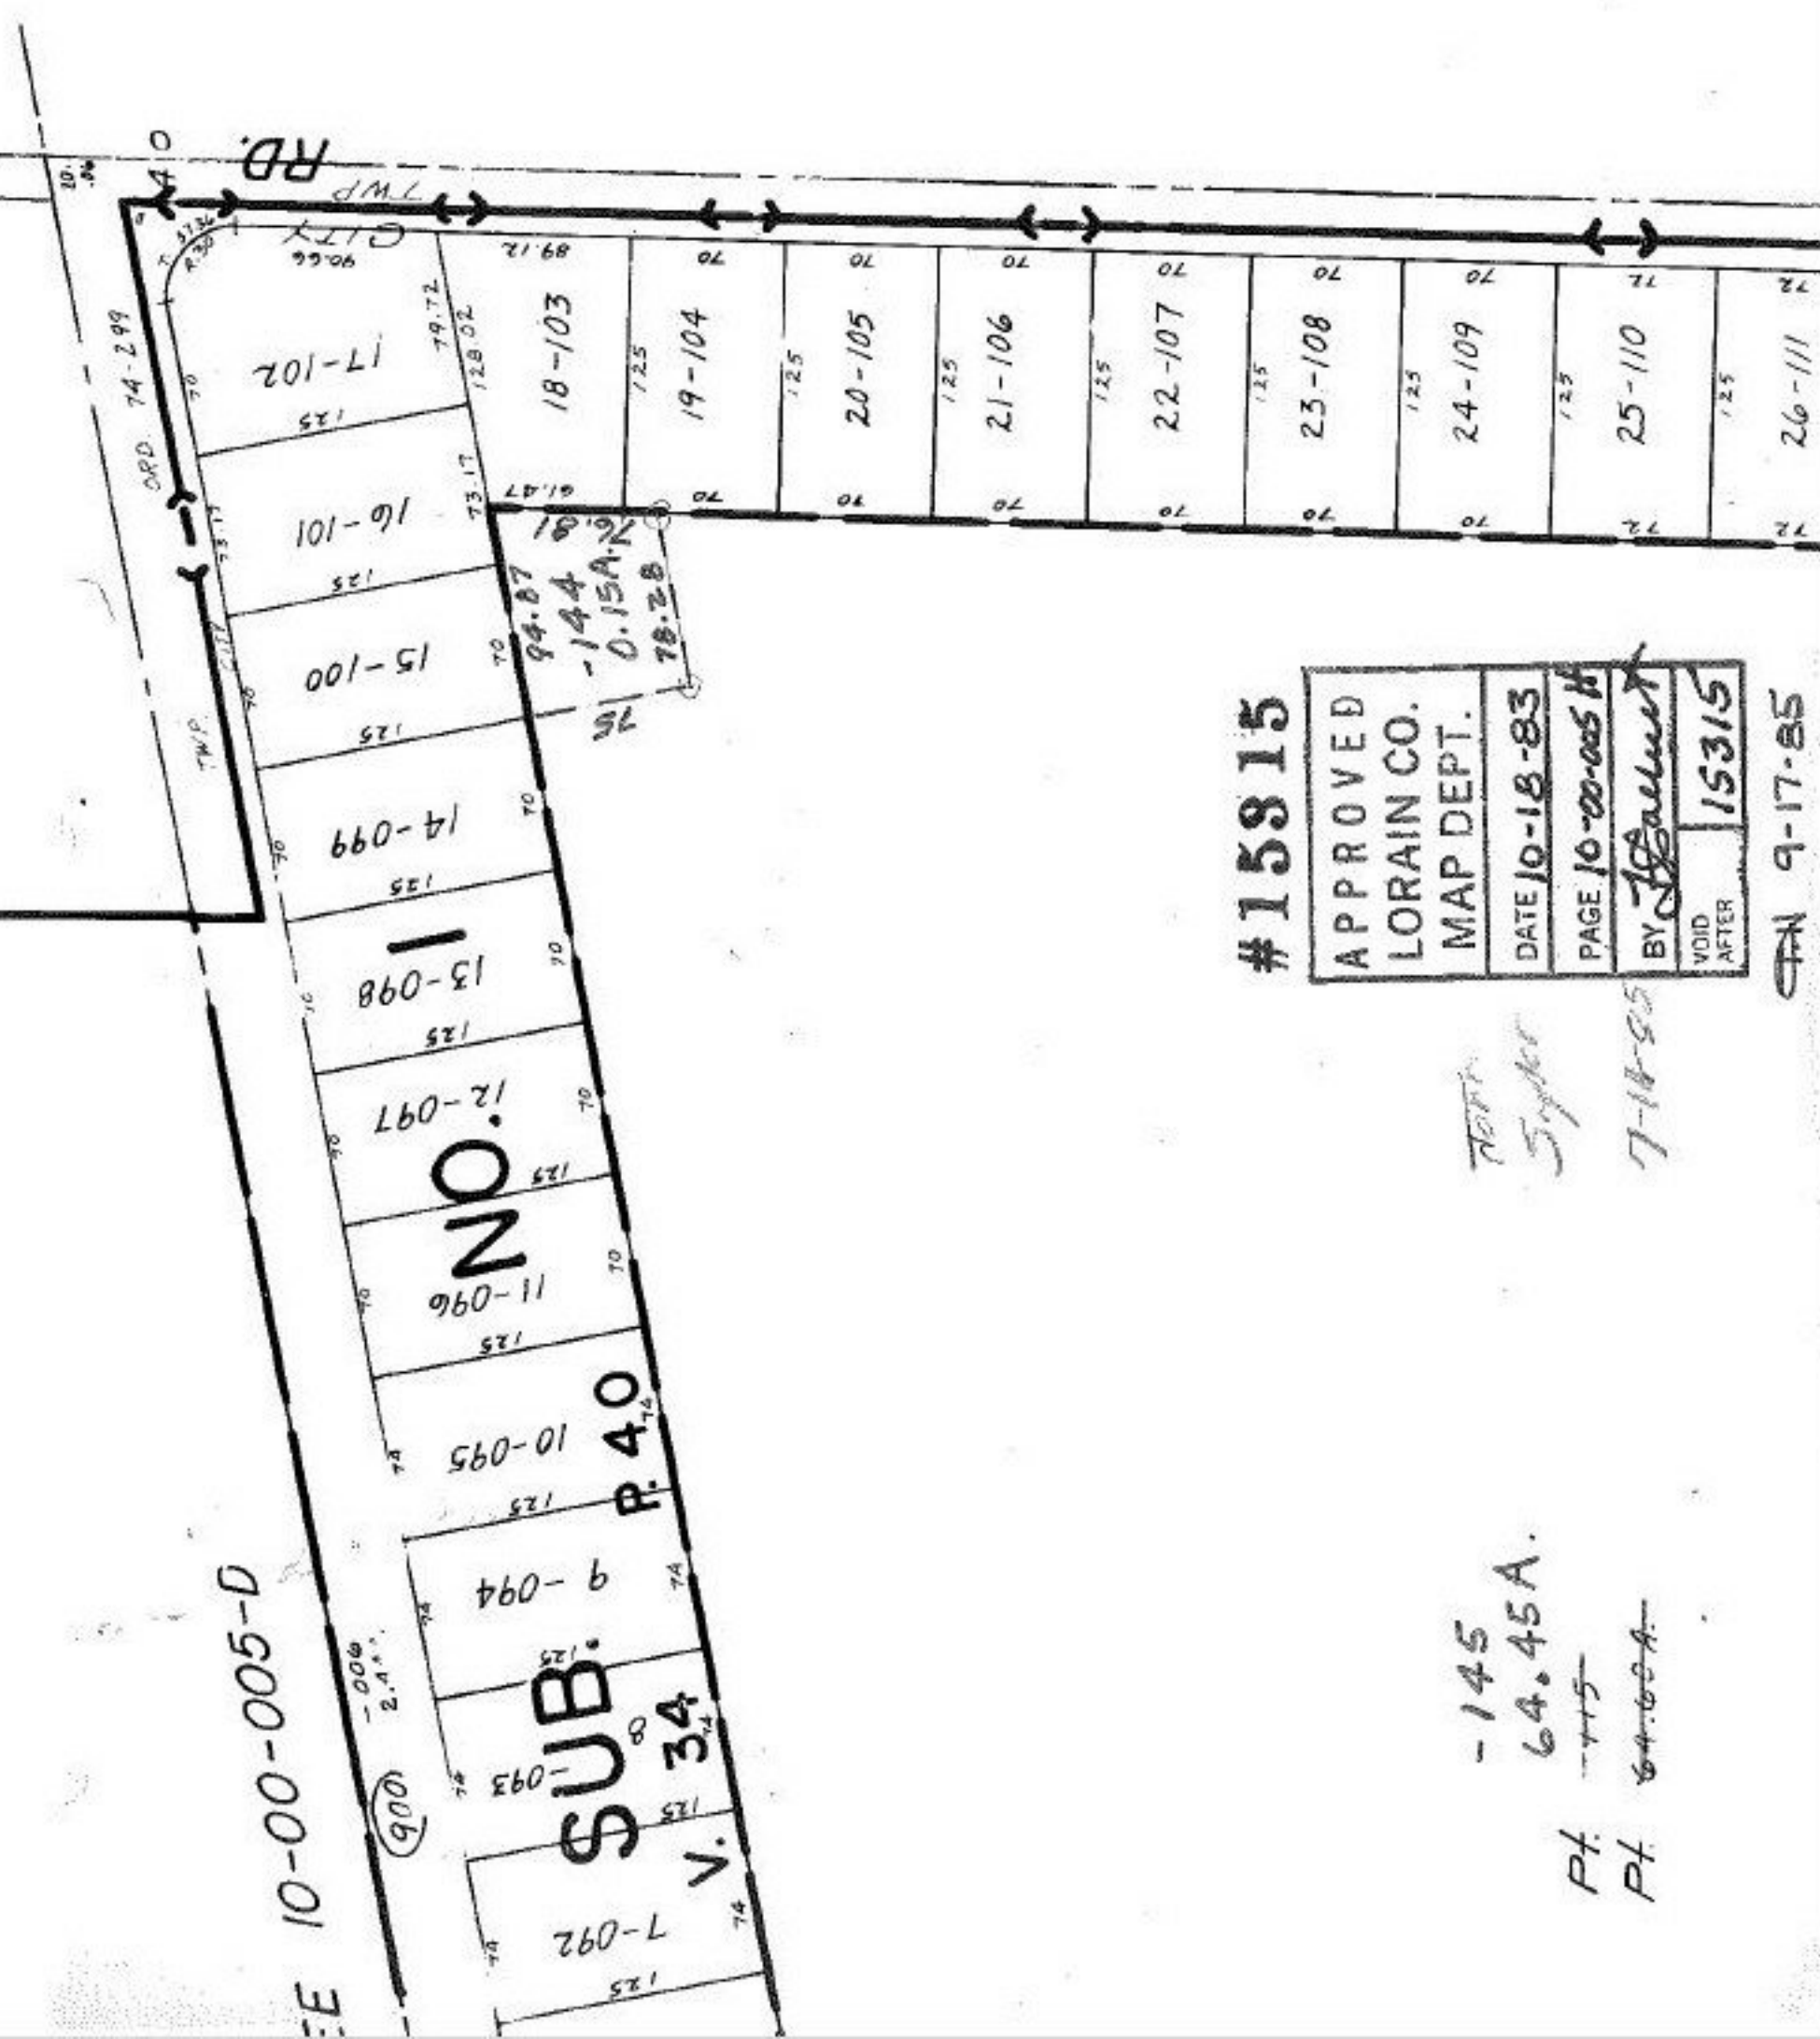

#15315

APPROVED LORAIN CO. MAP DEPT.	DATE 10-18-83	PAGE 10-00-005 H	BY J. J. [Signature]	VOID AFTER 15315
-------------------------------------	---------------	------------------	----------------------	------------------------

TOP
Syke
7-18-85

-145
64.45A.
Pt. 115
Pt. 64.60A-

FN 9-17-85