


5-00-012-A

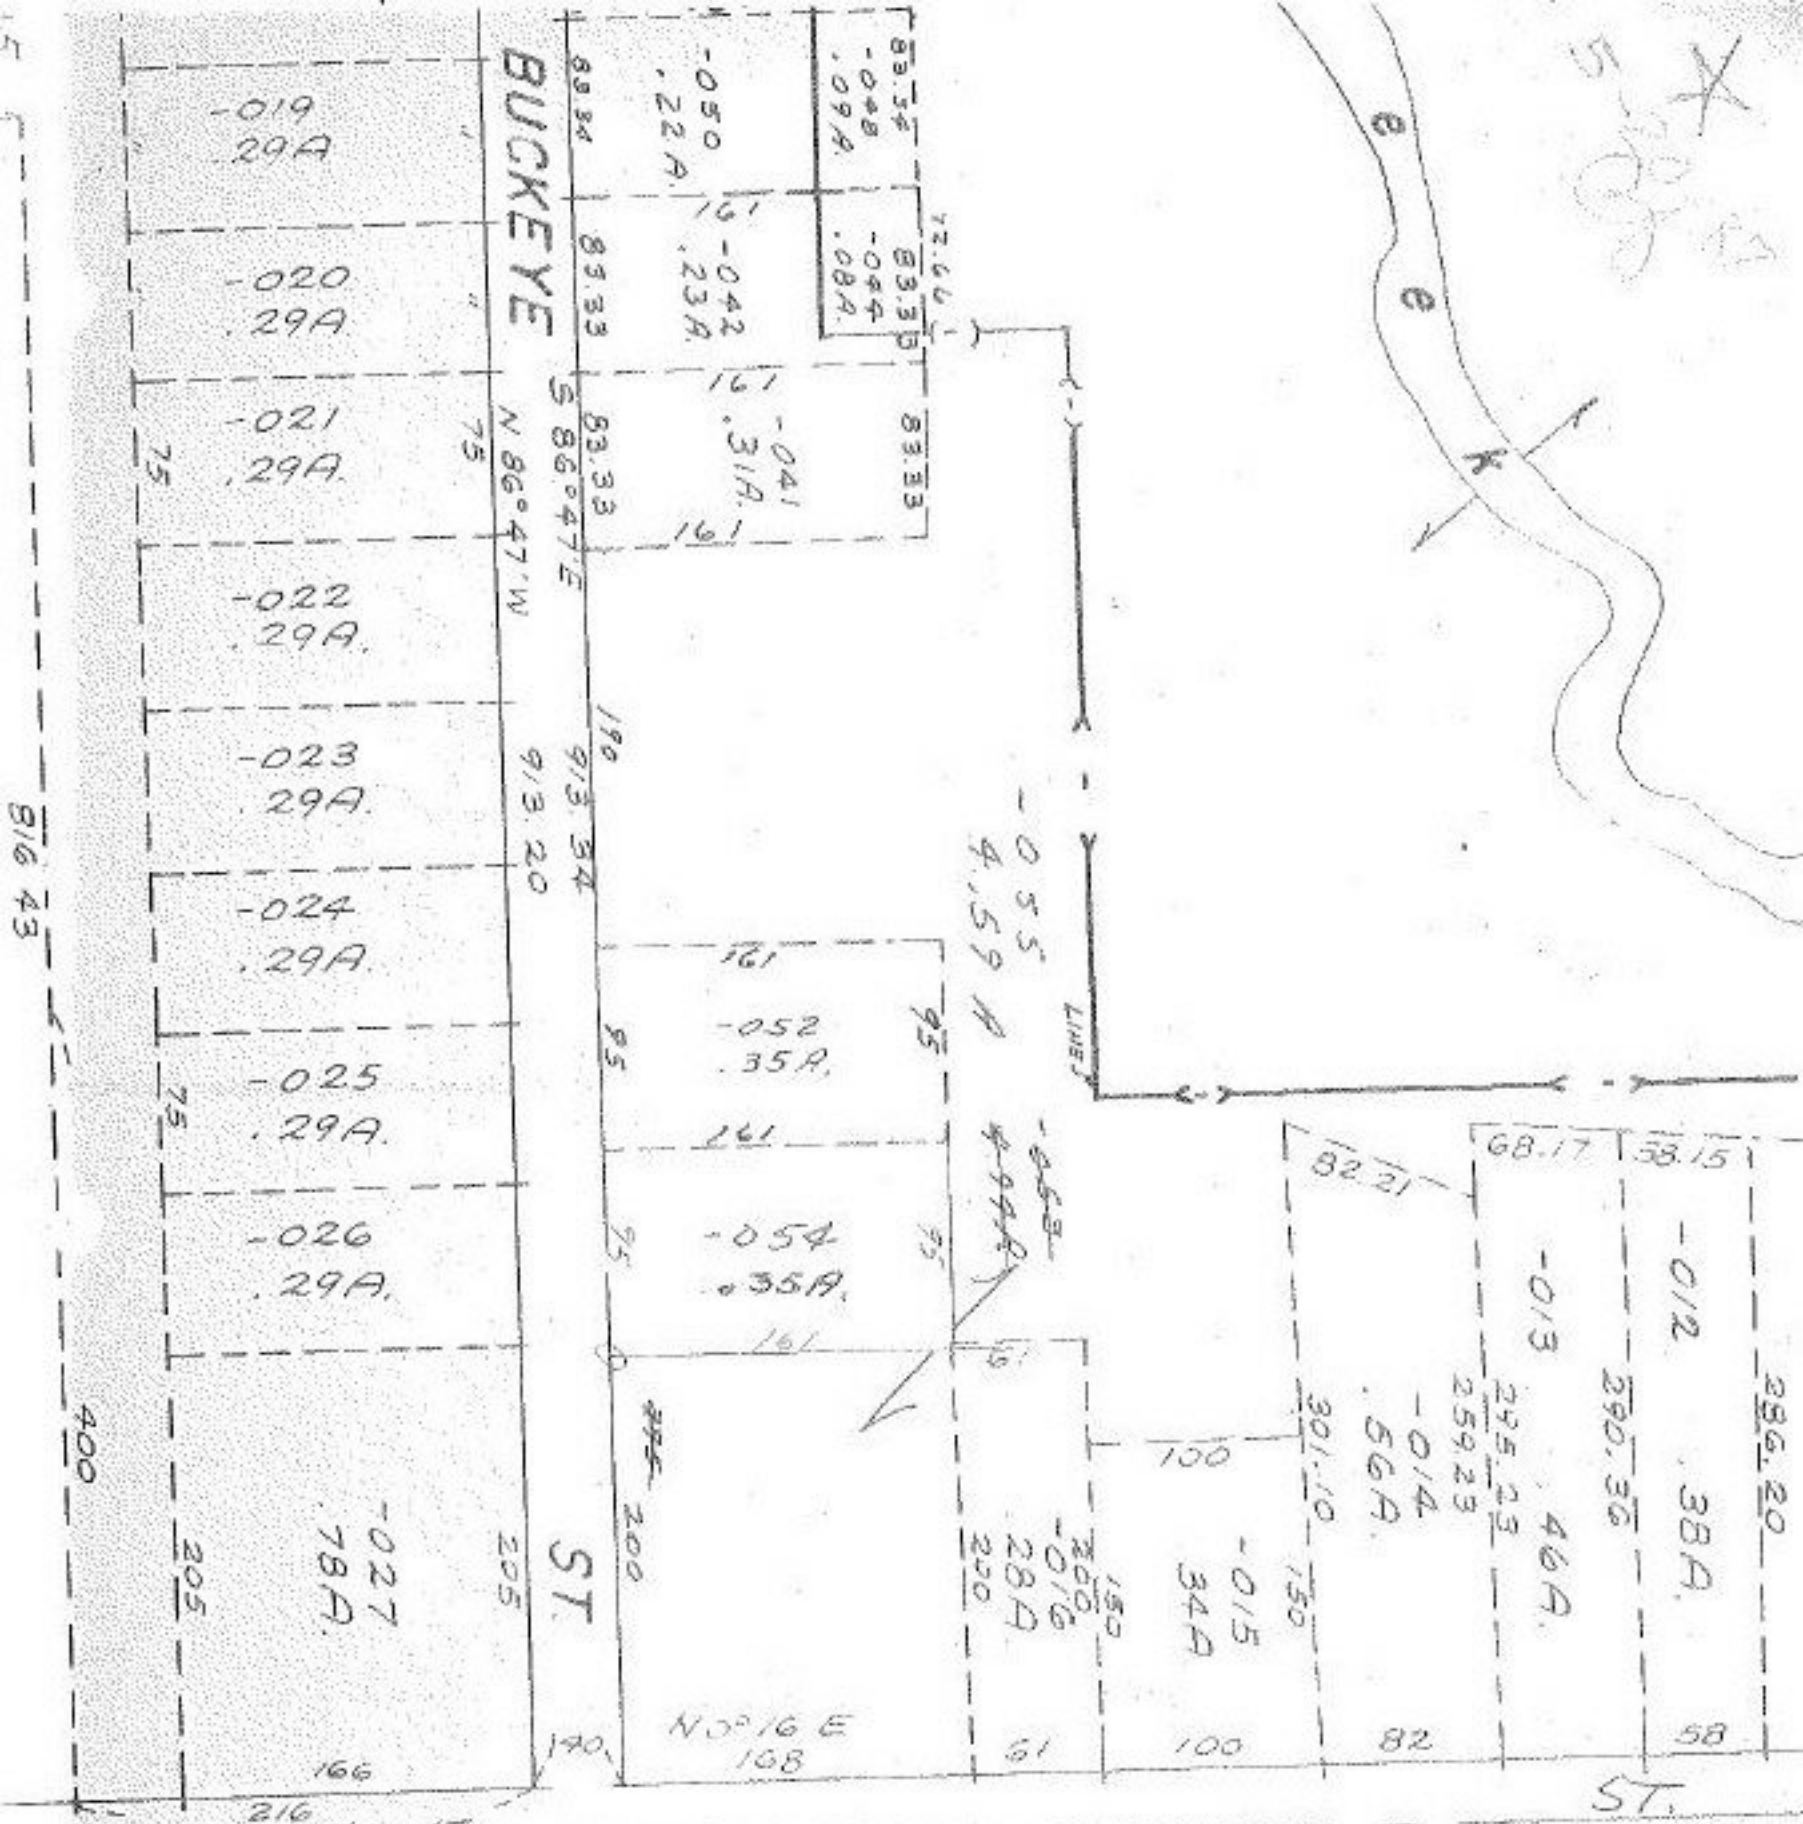

SEE 5-00-012-A Done 5-4-68

D. Maynard

Pg. 5-00-009-B

Handwritten signatures and initials in circles.

APPROVED
LORAIN CO.
MAP DEPT.
 DATE 5-6-68
 # 1532
 BY *[Signature]*