



50 49th

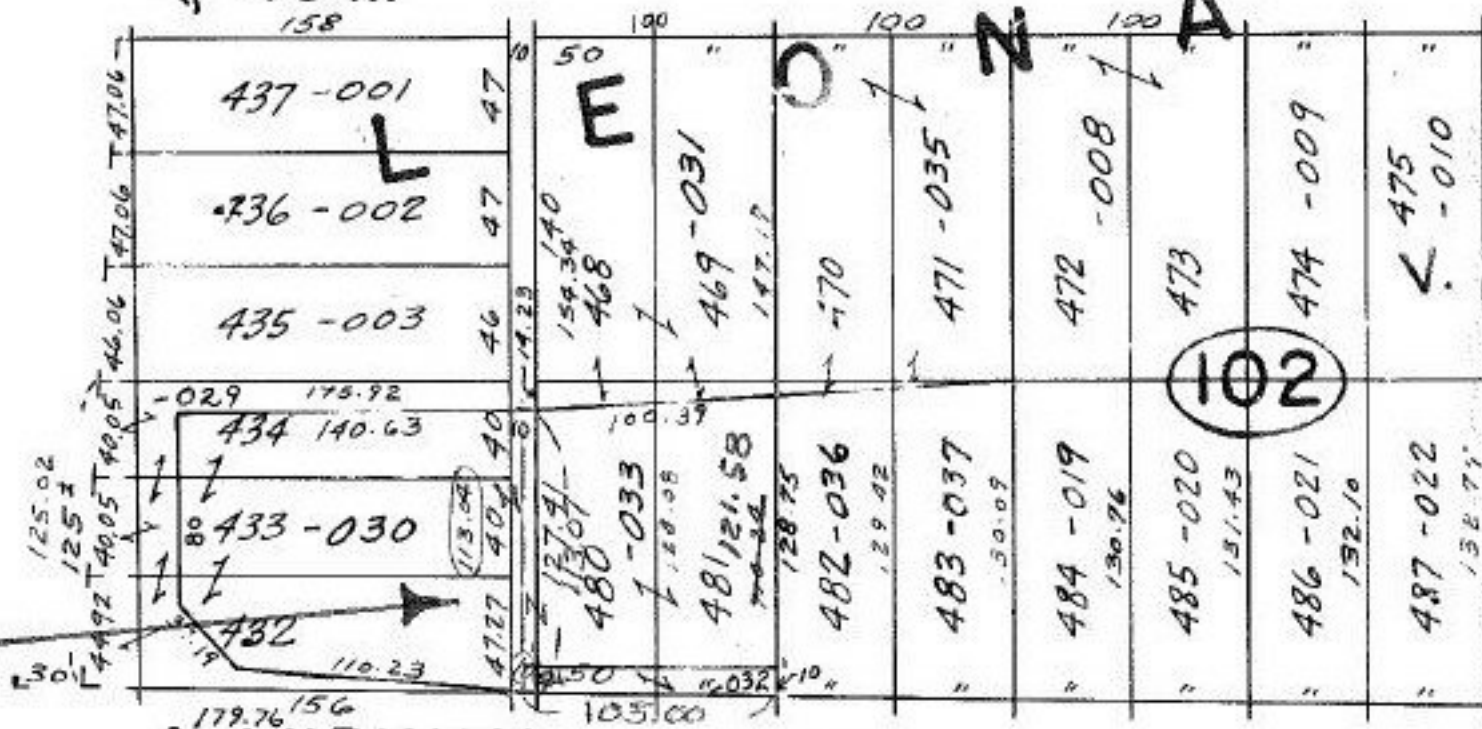

50 MIDWAY

VAC. ORD.
69-32

6-45

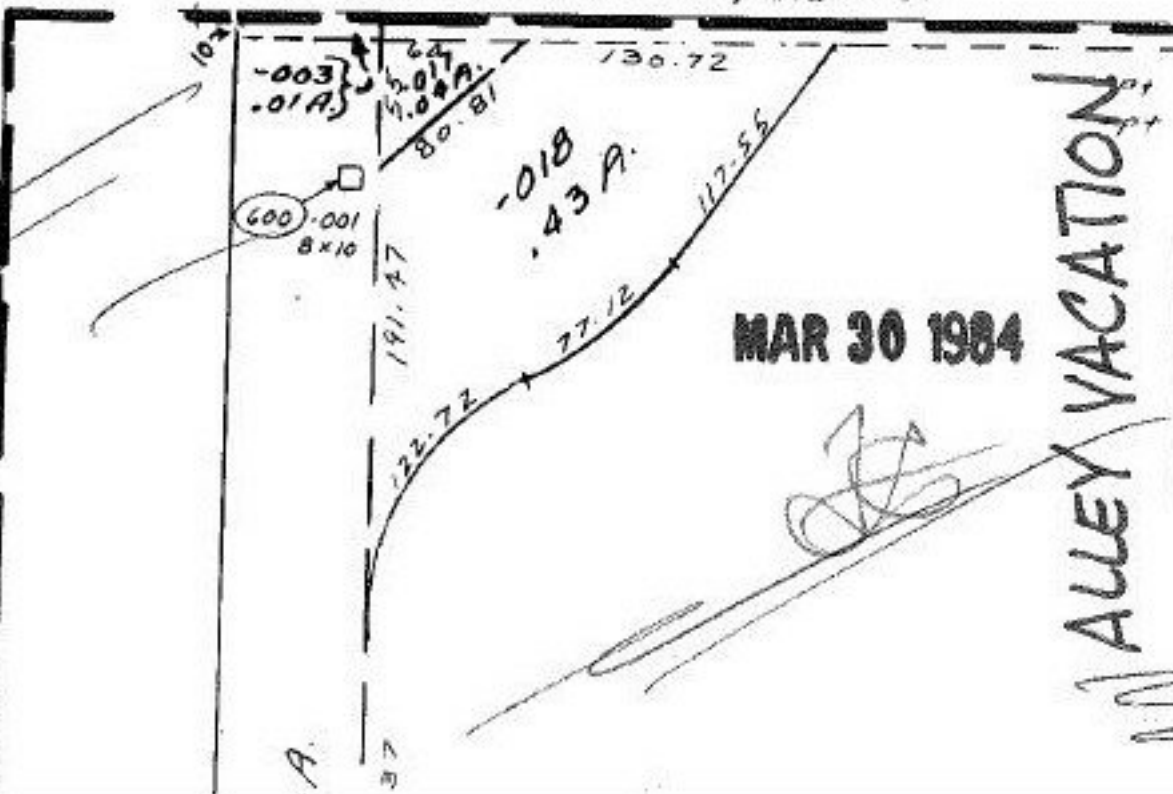

MAR 30 1984

ALLEY VACATION

#15326
APPROVED
LORAIN CO.
MAP DEPT.
DATE 10-25-83
PAGE 6-46
BY T. McHain
VOID
AFTER