


76-38
75.00
88 S
50.00
T=25
R=25
105.80
0.00
T=25
M=25
206-010
75.00
75.00
187-020
100.00
100.00
0.00
T=25
R=25
186-010
75.00
75.00
167-020
100.00
100.00
IVE
T=25
R=25
7-020
72.00
100.00
100.00

AVE

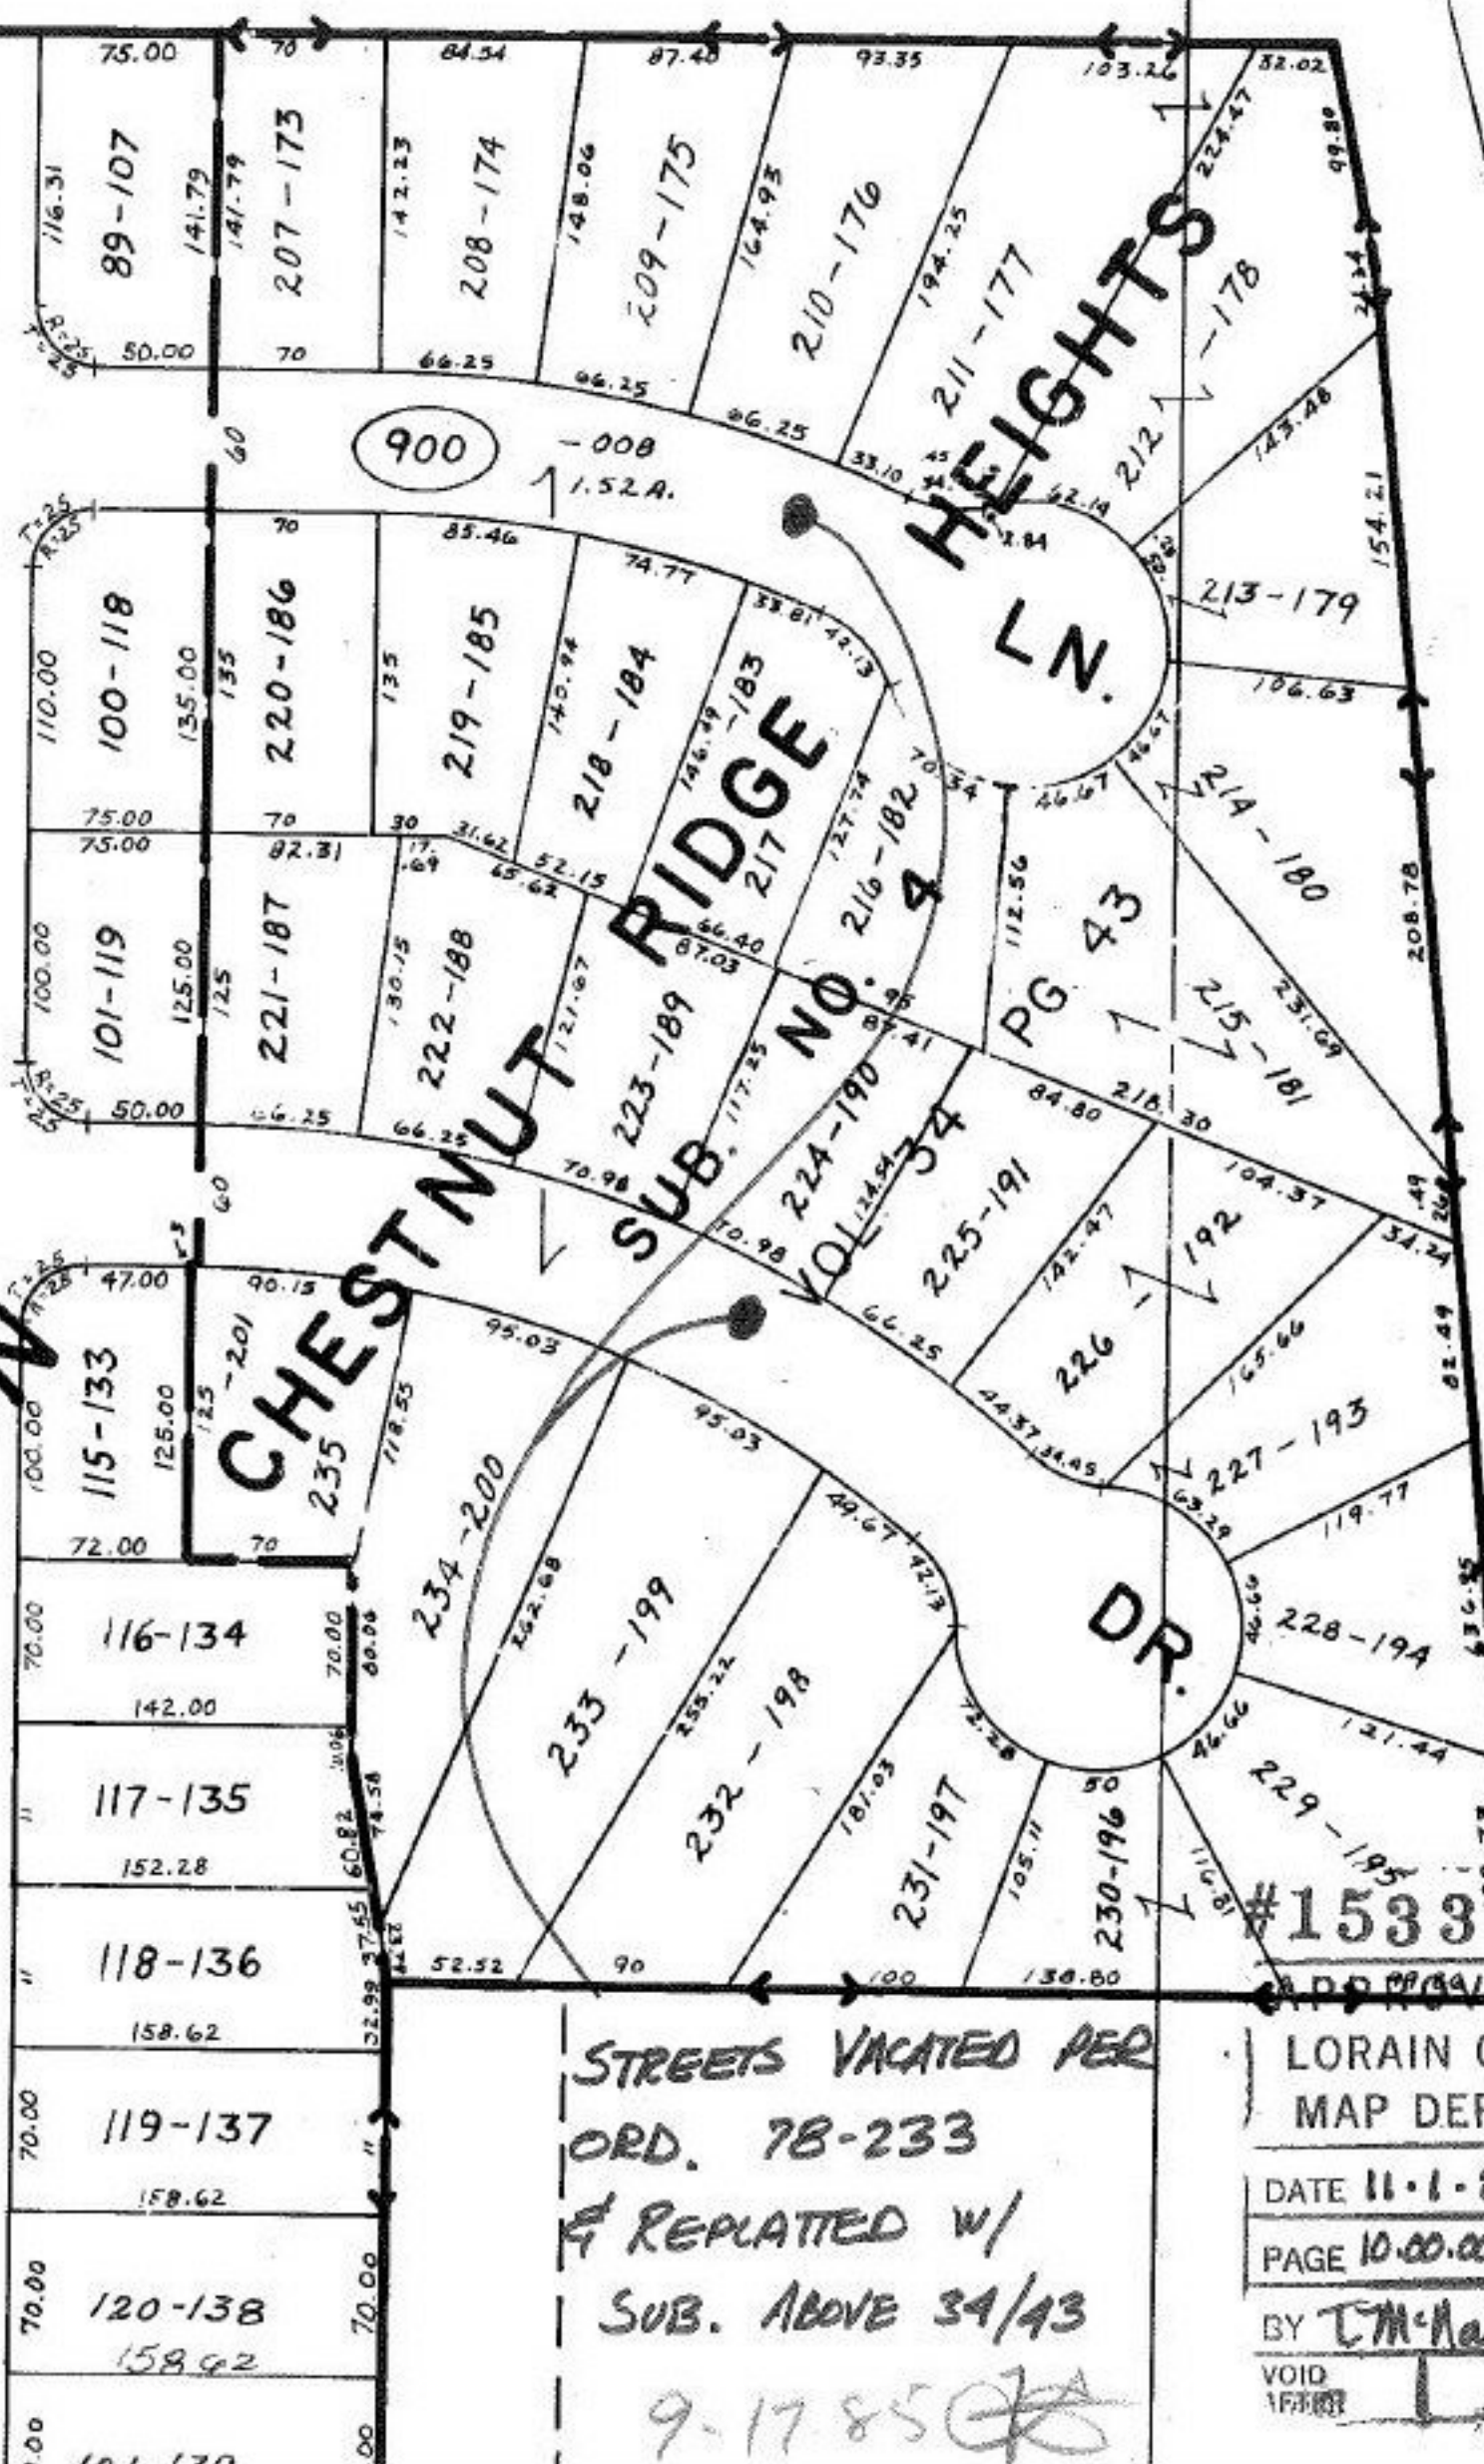

**SEE 11-A
VACATION**

STREETS VACATED PER
ORD. 78-233
REPLATED W/
SUB. ABOVE 34/43
9-17-85

APPROVED
LORAIN CO.
MAP DEPT.
DATE 11-1-83
PAGE 10.00.005.D
BY T.M. Han
VOID
1983

#1533