


630.99
360
280.99

SEE 4-003 014-
76

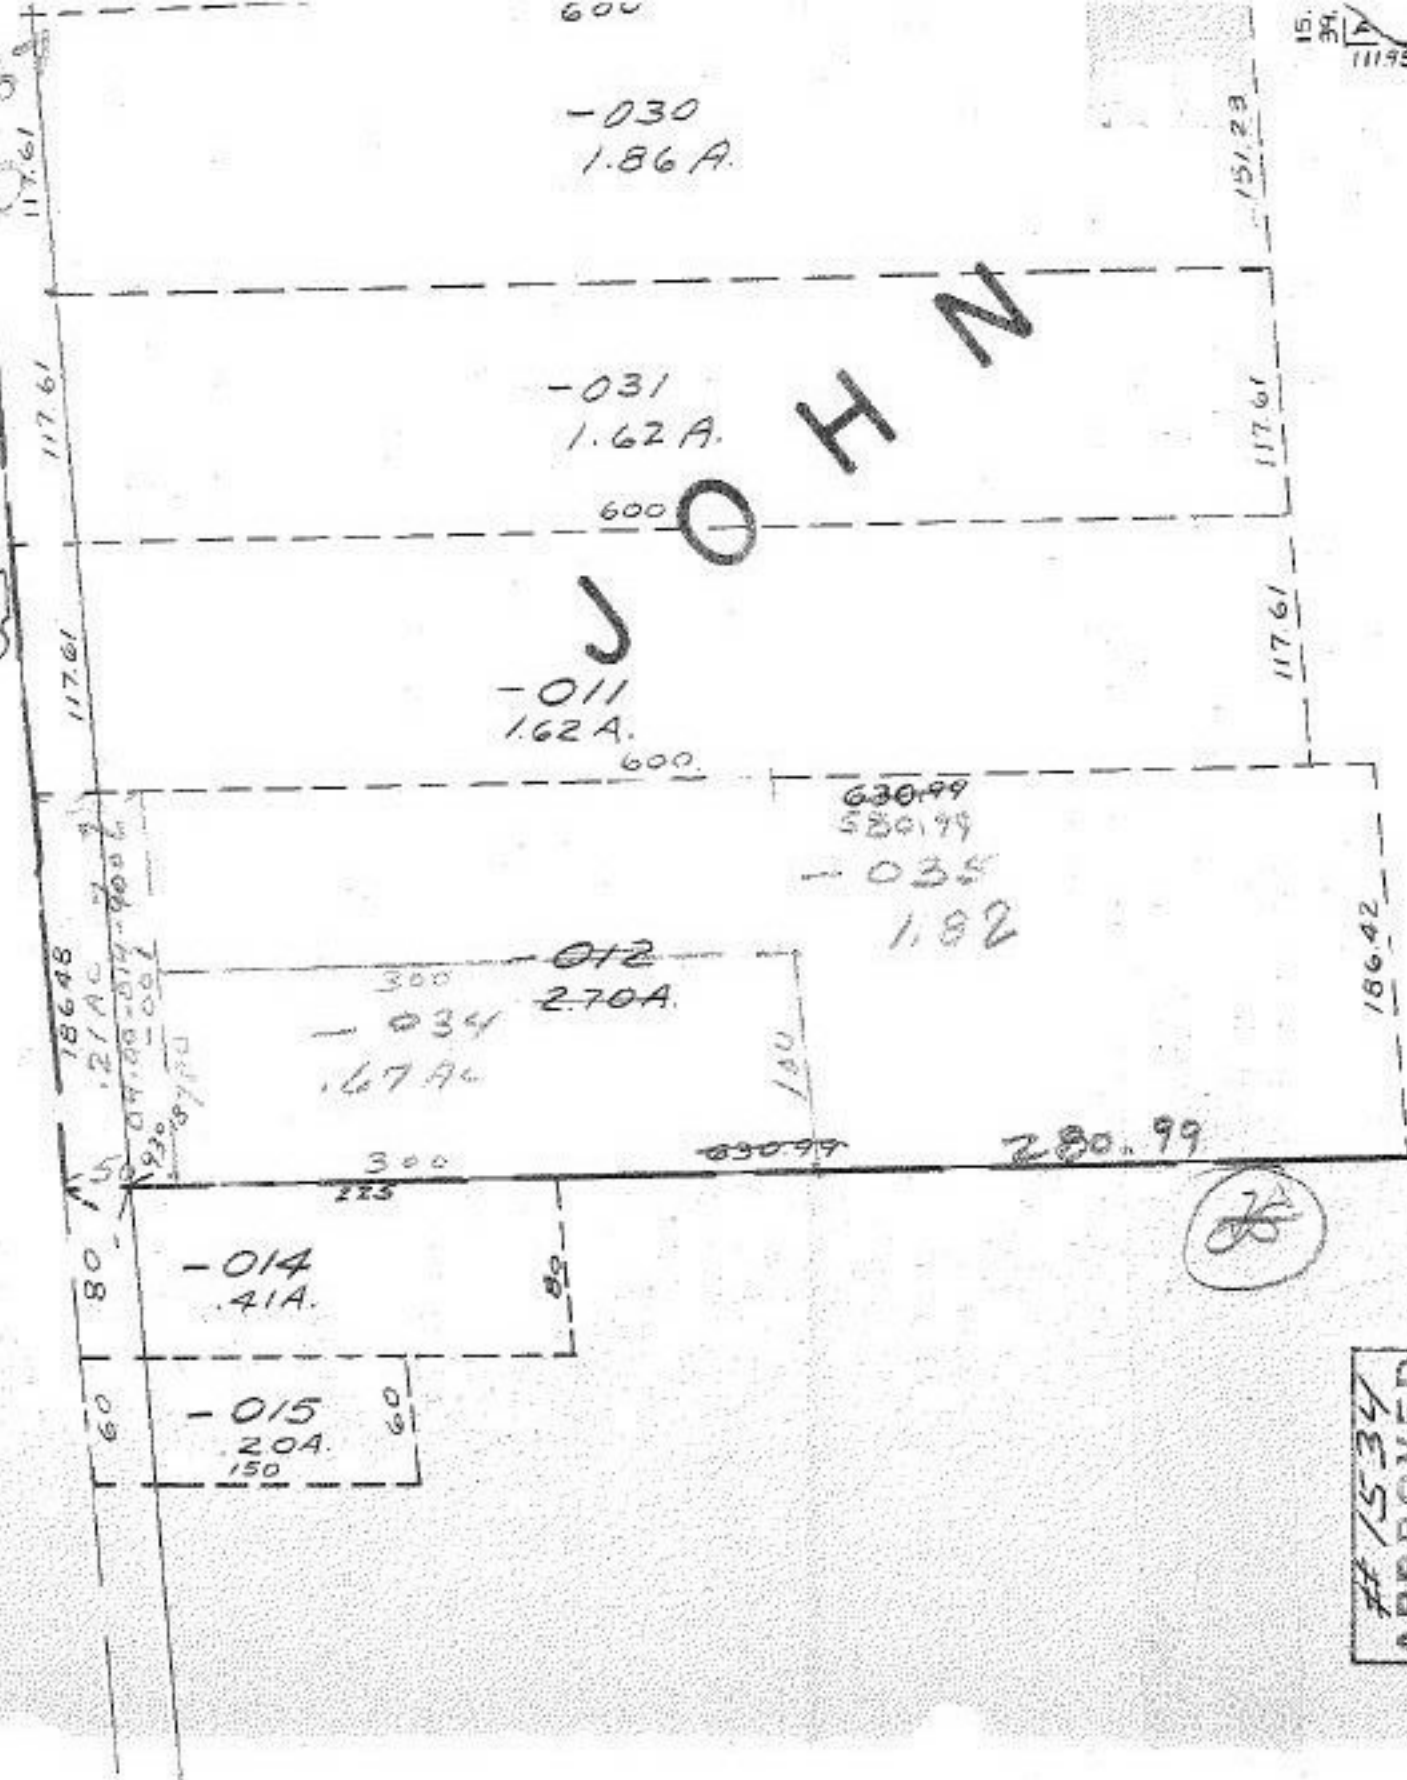

1534
APPROVED
LORAIN CO.
MAP DEPT.
DATE 2-7-68
BY L.W. Hall

DONE S.A.B.B. COLBERT
FRANK COLBERT

Tax Map P9
11-00-014

15.34
111.95
257.35

-018
7.47A

666.04