


~~Pt. -022~~
~~Pt. 55.22A~~

Pt. -024
Pt. 54.27 A

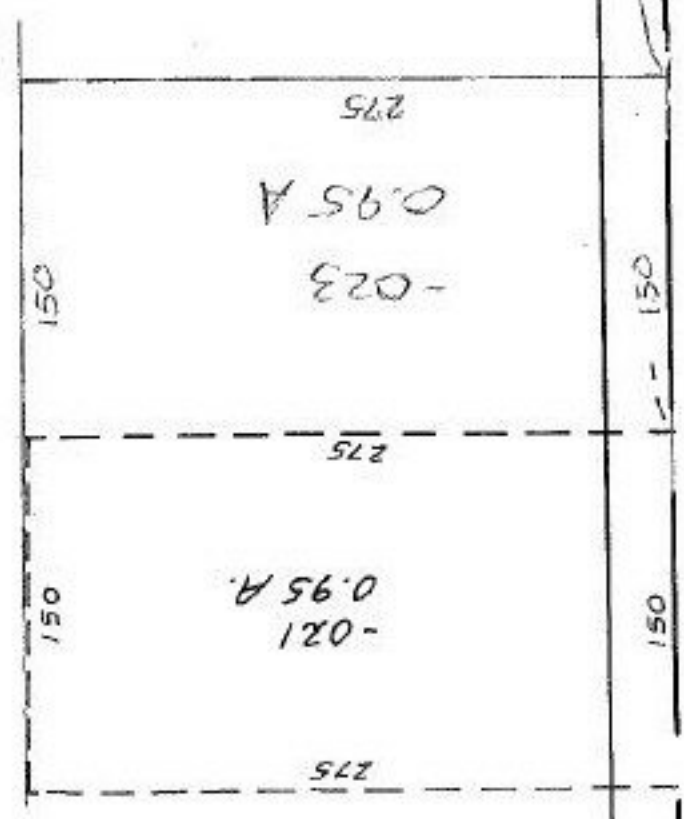

9/23/64
[Signature]

OB 11-85
1-11-85

SEE SURVEY ARNOLD KOEPP.

#15362

APPROVED
LORAIN CO.
MAP DEPT.
DATE 11-17-83
PAGE 10-00-015-0
BY T. B. McMain
VOID AFTER

1950 TO E. OF MEXNA-ELYRIA RD
RD. 2100 0 9