


01-A

(LIBERTY AVE.)

(RD.) R.L.

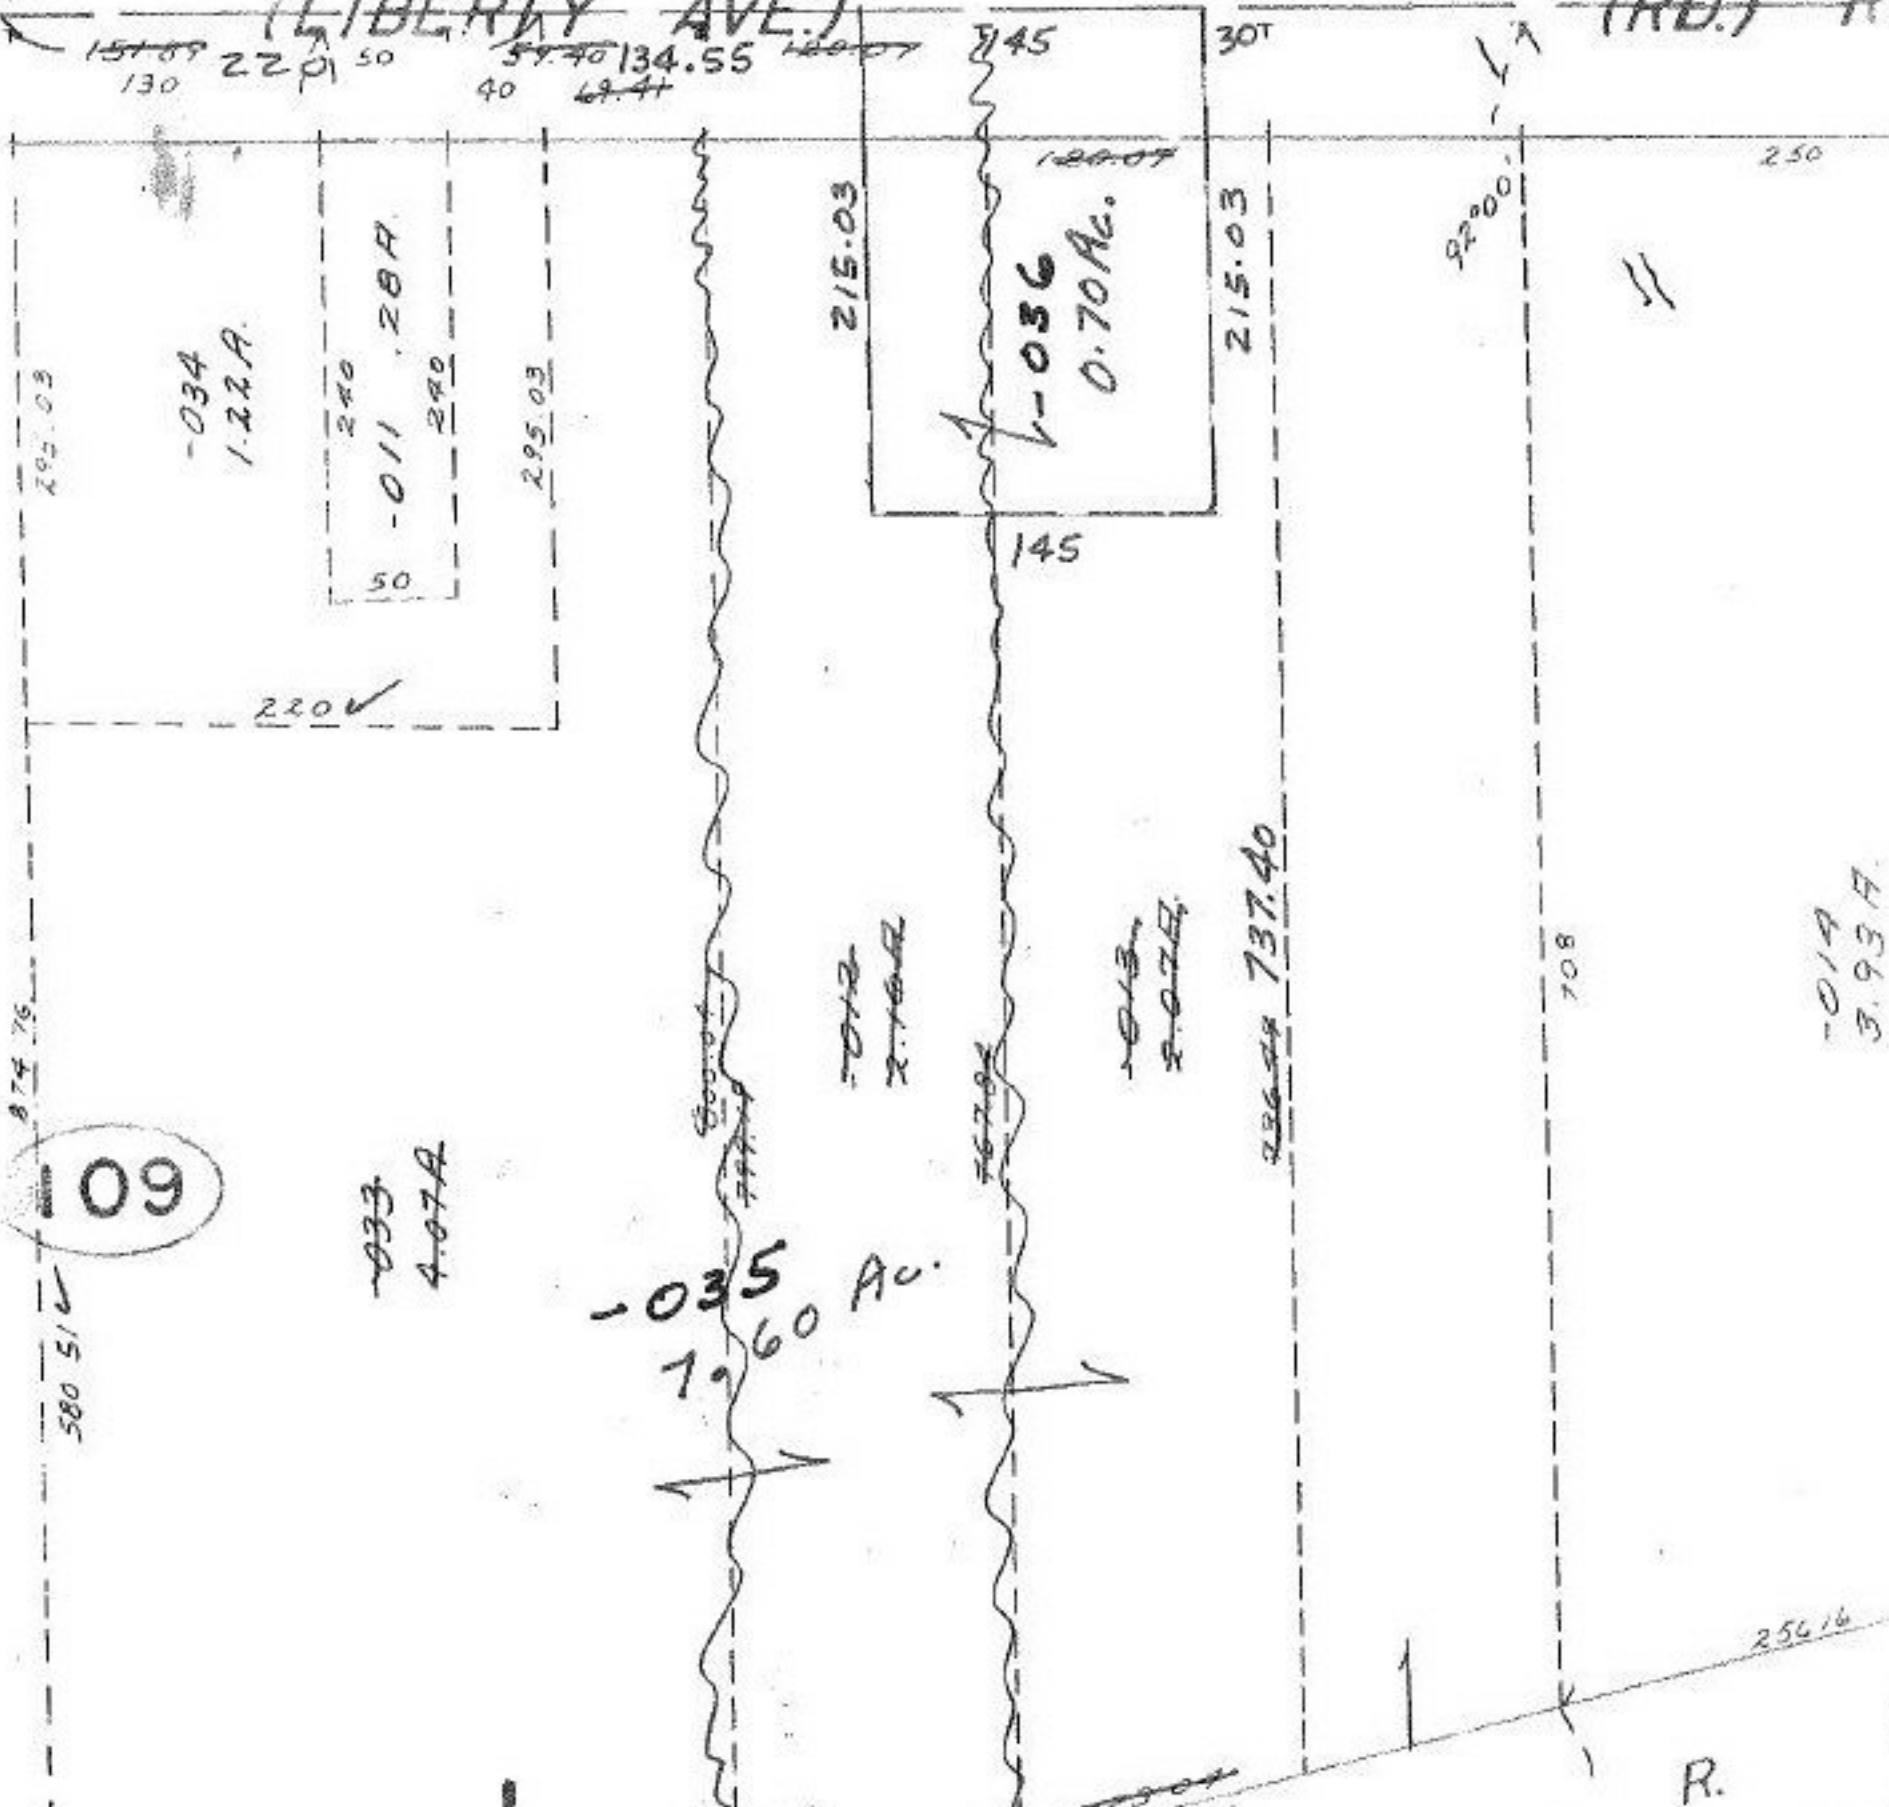

09

500

#15366

APPROVED
LORAIN CO.
MAP DEPT.
DATE 12-5-83
PAGE 1-00-001 C
BY <i>[Signature]</i>
VOID AFTER 15366

APR 27 1984

PT  
PT

30