


487.19

-041
Pt. ~~030~~
9.40A.
Pt. ~~H-14A~~

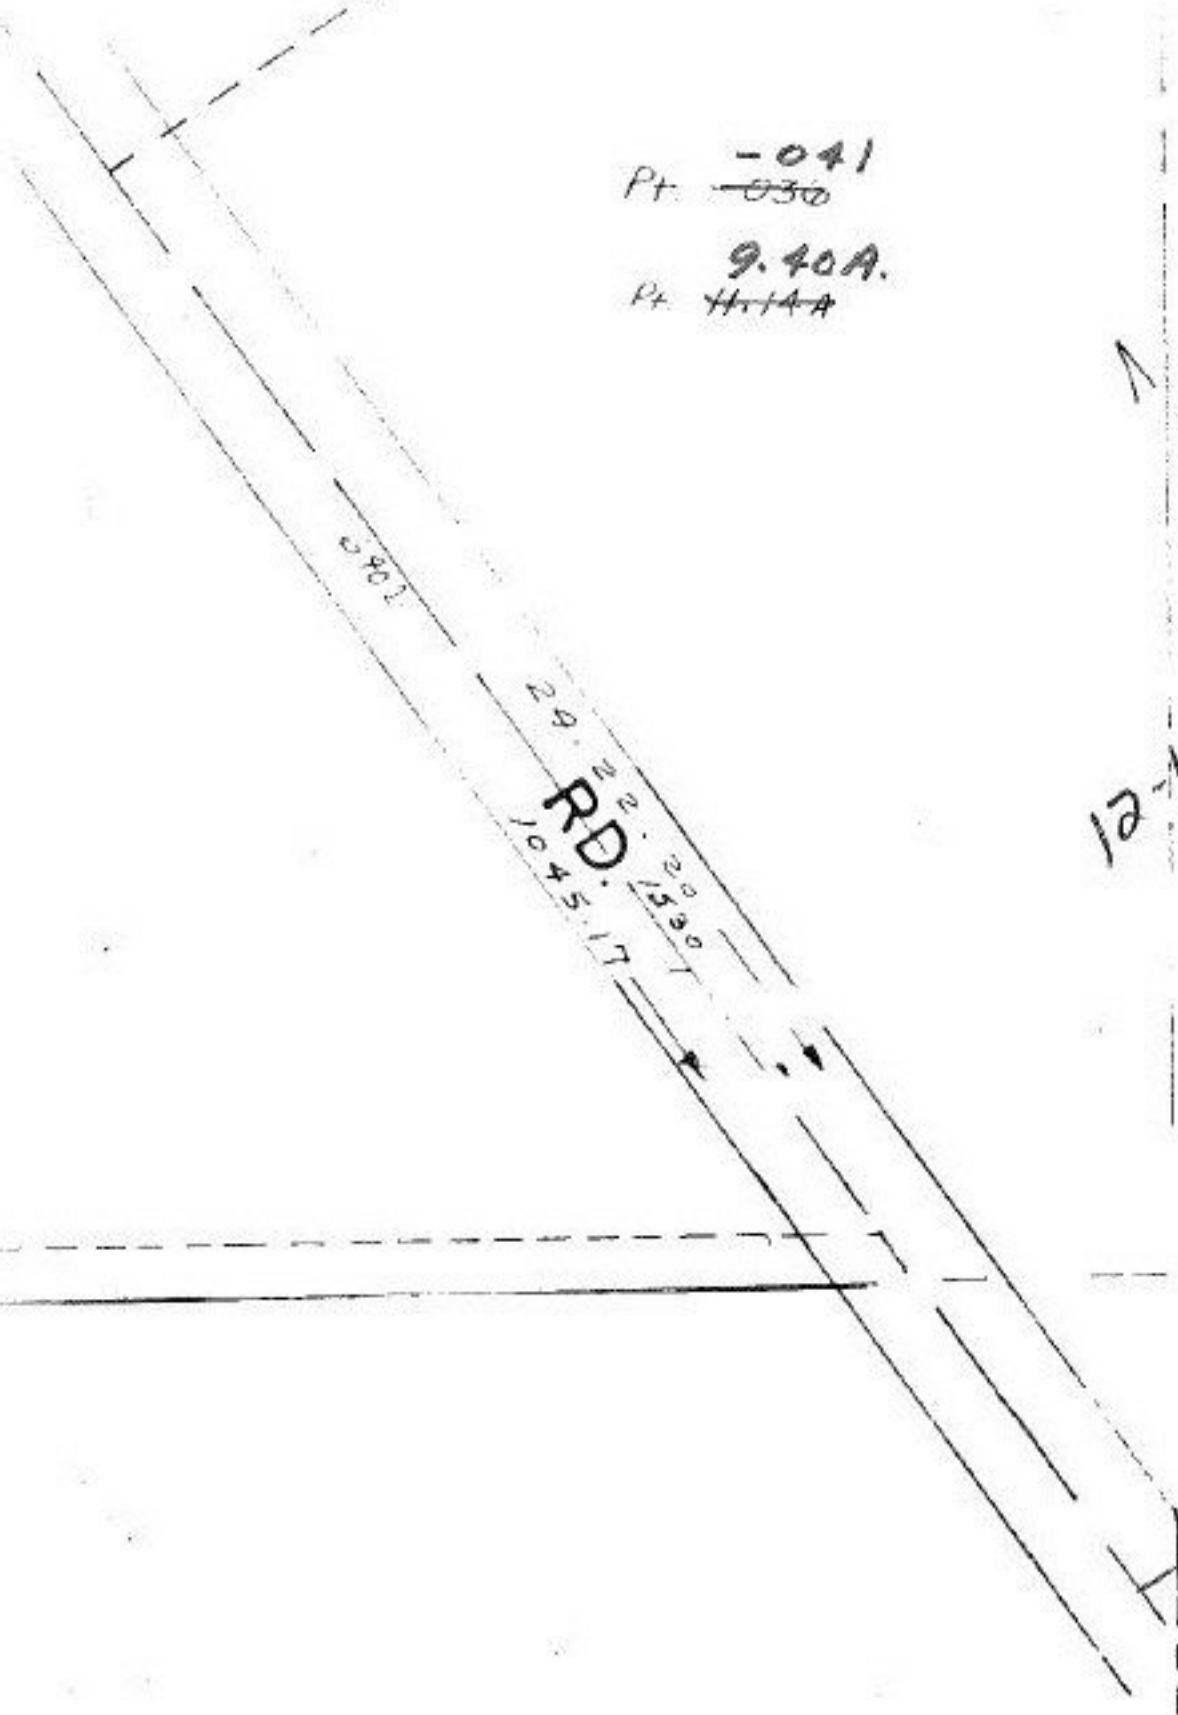

12-1-83
[Signature]

#15369
APPROVED
LORAIN CO.
MAP DEPT.
DATE 11-25-83
PAGE 2-03-0048
BY *[Signature]*
VOID AFTER 15369