

1023  
S 87-52 E

192.74  
~~2186.58~~

598.30

Average Correction  
Pt. ~~443~~  
Pt. ~~824~~  
Pt. ~~234~~  
11.82 A.

-059

S 62-53-20 W

495.70  
496.31

N 61-24-18 E

106

-042  
3.18 A.

S 34-58-30 E

S 36-18-18 E  
270.80

S 55-45-28 W  
394.01

394.12  
N 57-13-54 E 394.12

N 52-15-06 W  
356.94  
N 50-46-40 W

Pt. 071  
Pt. 74A

Pt. 070  
Pt. 25.31 A.

43.61  
60  
98.16


16.23  
11.82  
4.41

Pt. 071  
Pt. 71.74A

-060  
4.41 A.

624.50

#15372  
APPROVED  
LORAIN CO.  
MAP DEPT.  
DATE 11-28-83  
PAGE 700-025 D  
BY *H. Holm*  
VOID AFTER 15372  
10-18-85

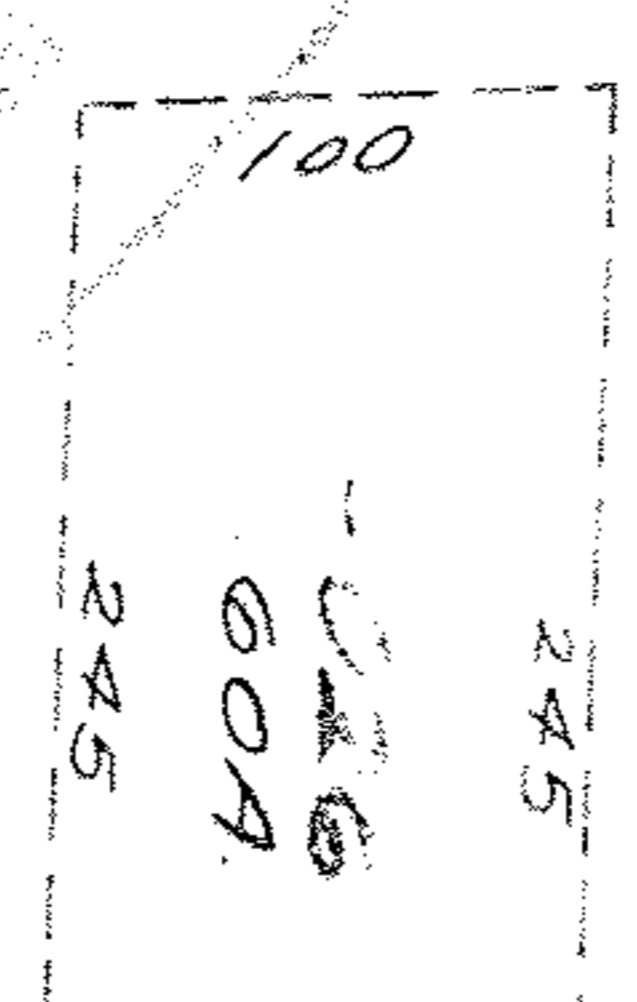

446.32  
AVE

TERNUT  
75

469.92  
RIDGE  
445.6

S 52-30-10 W  
210.2+38  
714.7

AKE