


58

SEE SURVEY MCGILVER  
& ASSOC.

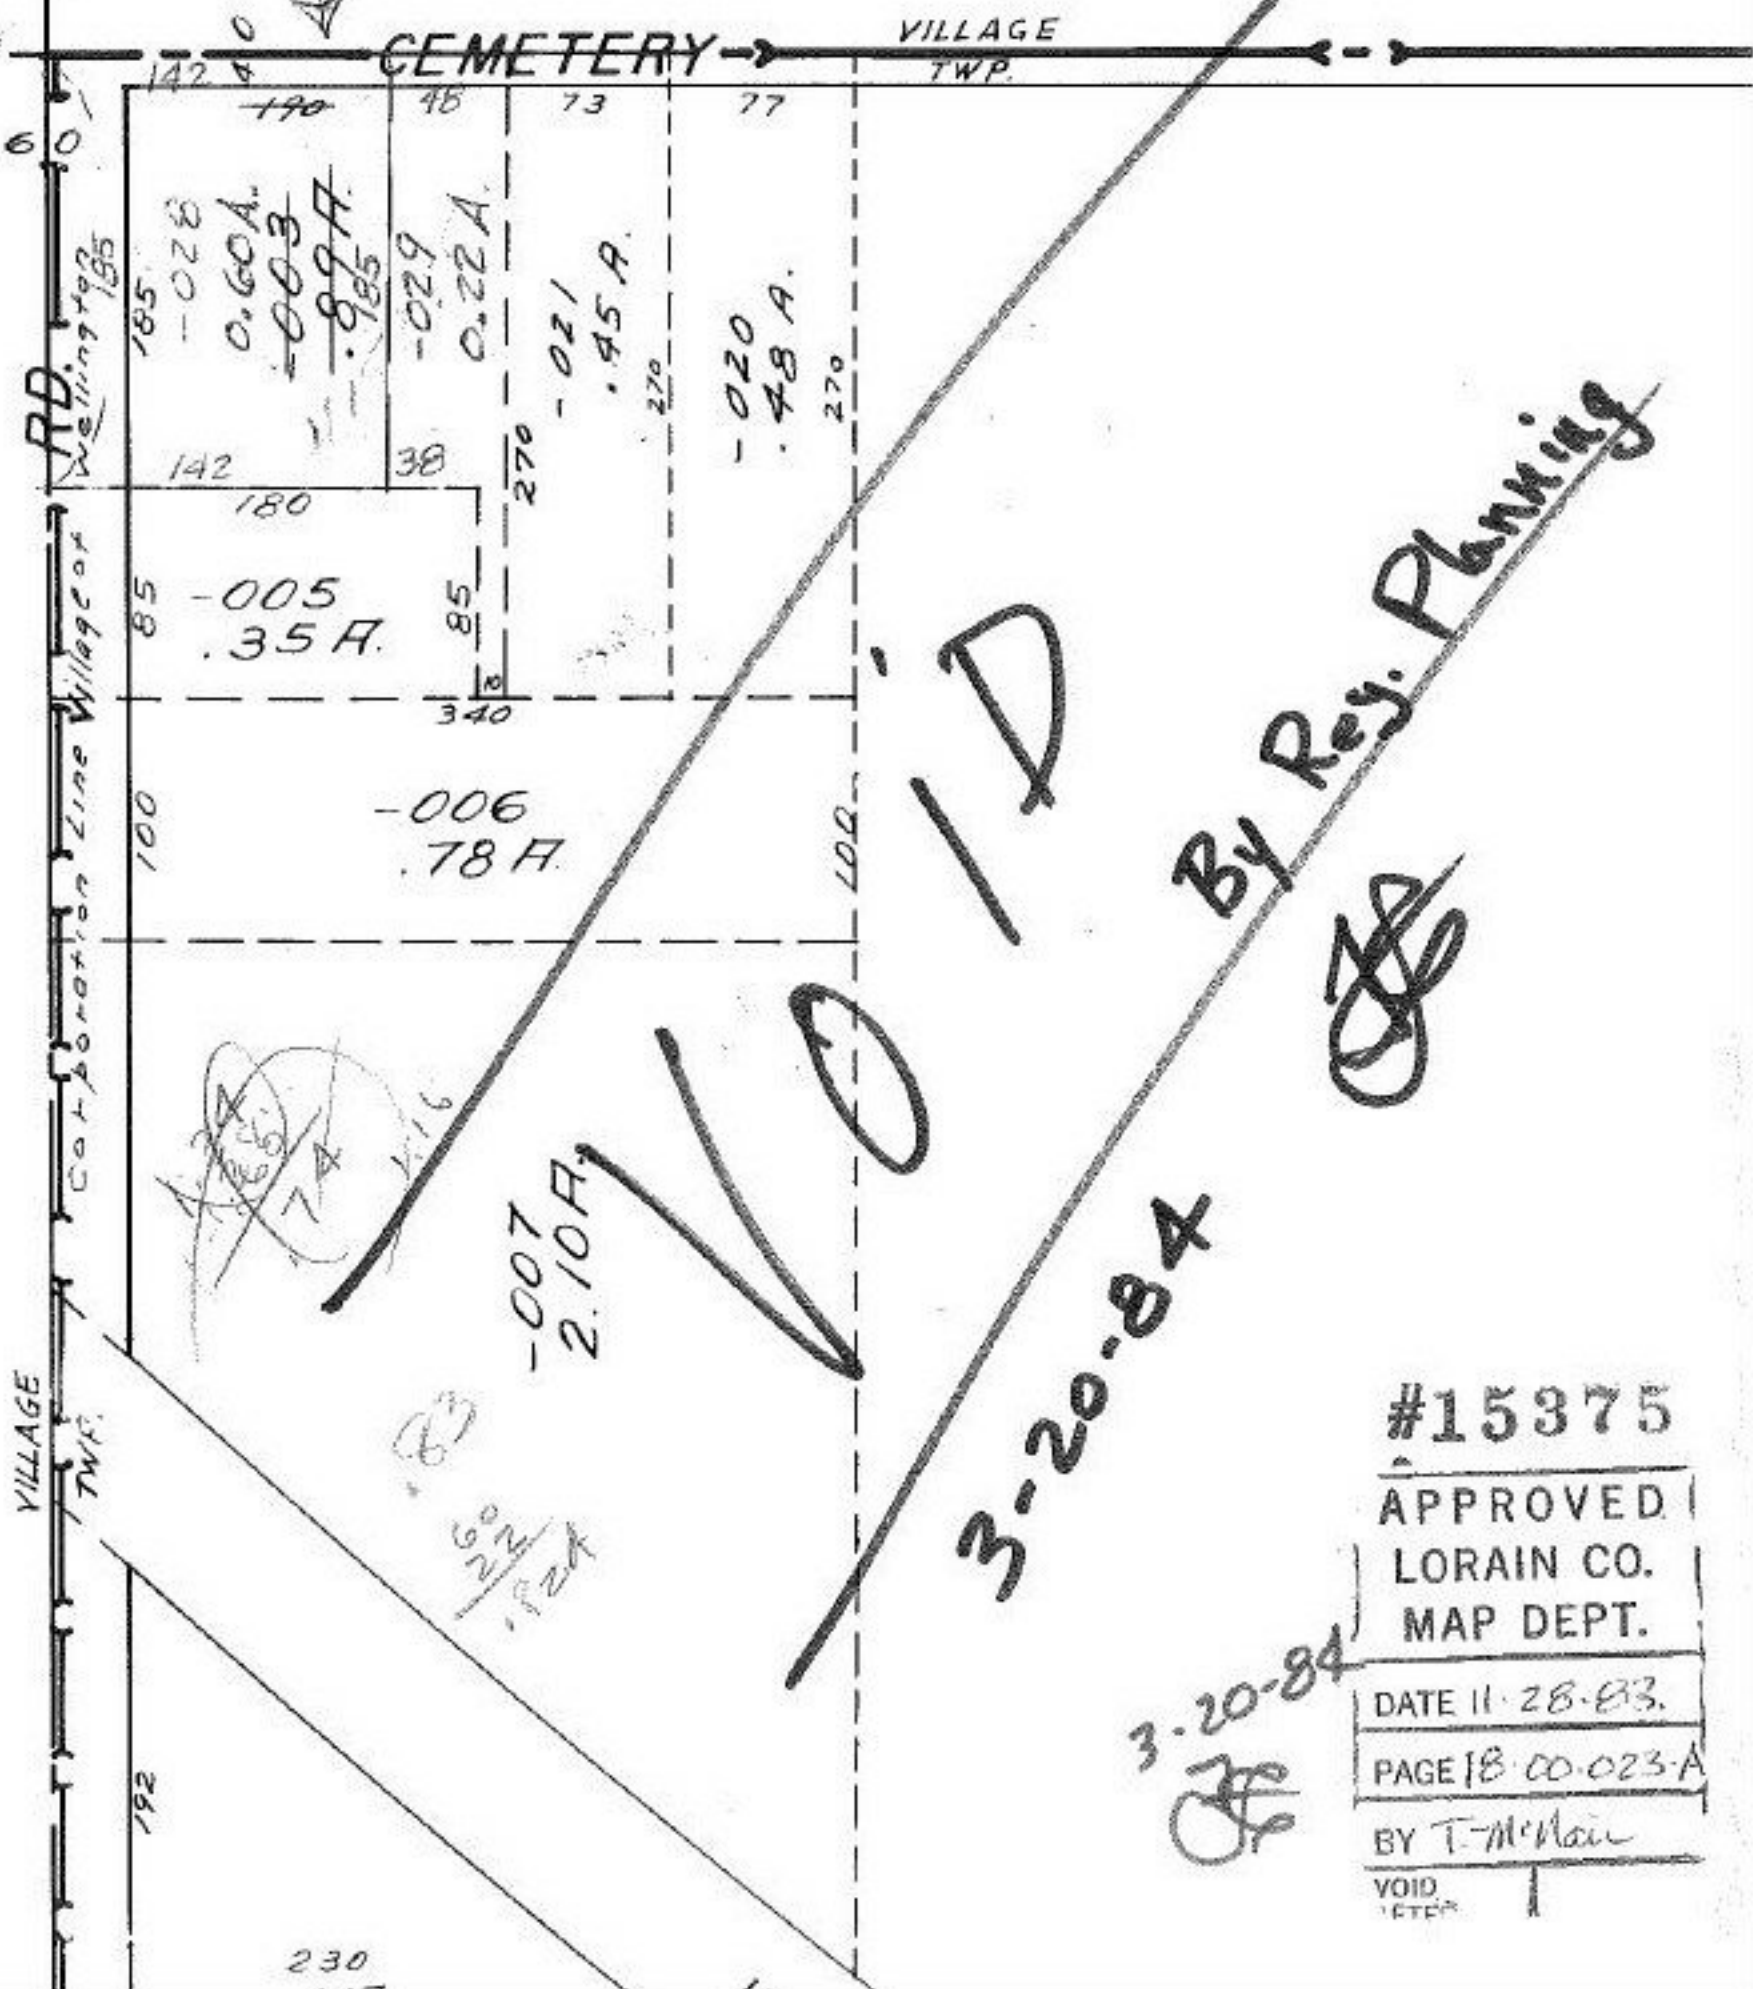

BY REY. PLANNING

3-20-84

#15375

APPROVED  
LORAIN CO.  
MAP DEPT.

DATE 11-28-83

PAGE 18 CO. 023-A

BY T. McNeil

VOID  
ETC

3-20-84