

TURNPIKE

Dup. #6
 Dup. #7
 Dup. #8
 Dup. #9
 Dup. #10
 Total

BYPASS

Add To Dup.

RD.


Vol. 758, Pg. 53

Vol. 1157, Pg. 638

Ac. CORR.

Vol. 775, Pg. 653

Vol. 569, Pg. 384

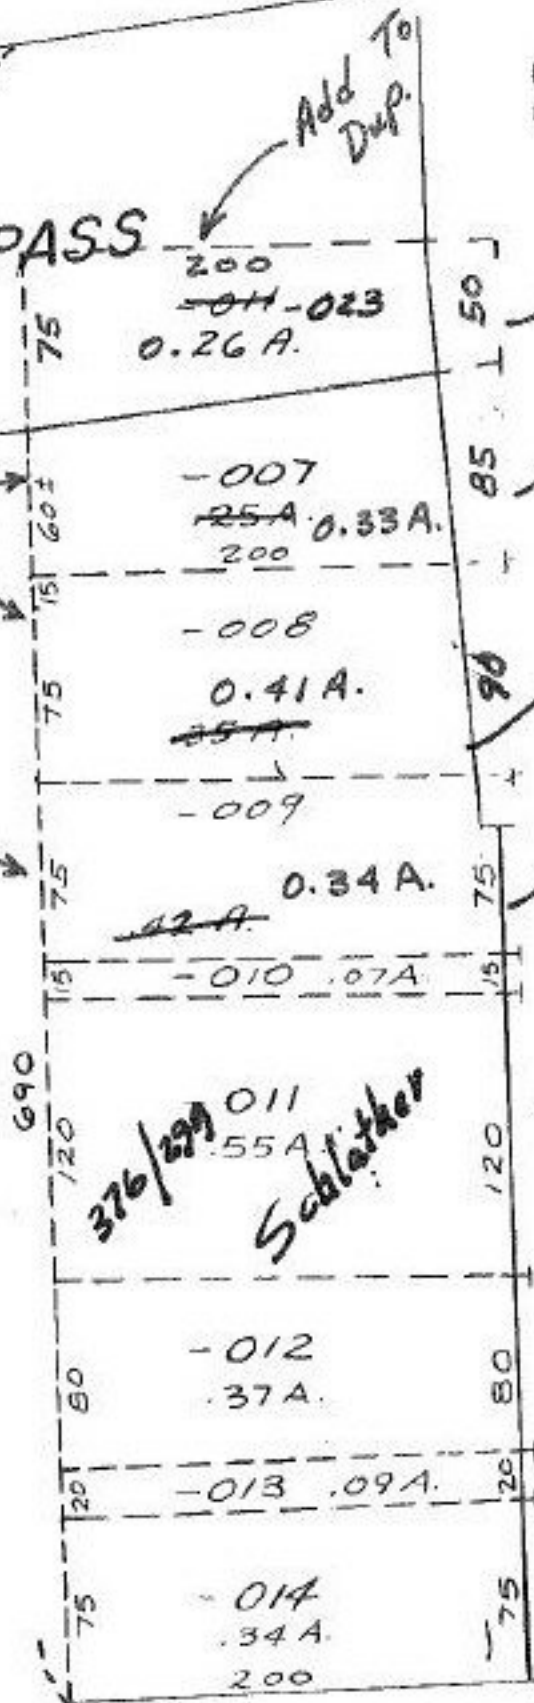

POPLAR ST.

MAR 30 1984

#15376

APPROVED
LORAIN CO.
MAP DEPT.
DATE 12-1-83
PAGE 6-85
BY J.E. [Signature]
VOID AFTER 15376

86