


039  
3.25A.

1714.0

972.70

# SURVEY BY EARL WM. PETERSON

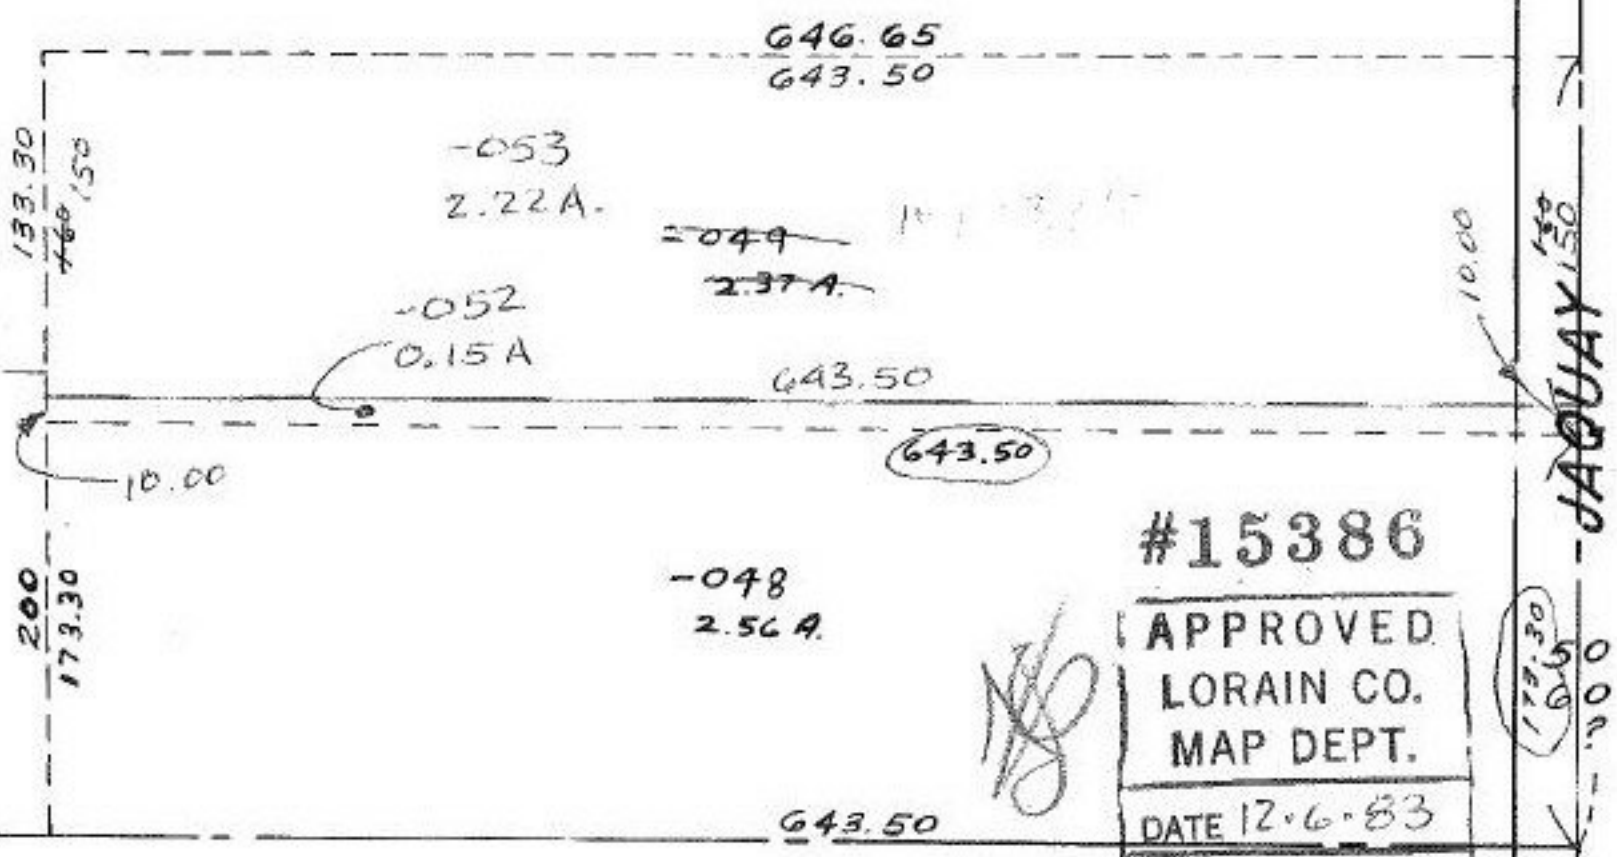

1-00-062-B

#15386

APPROVED  
LORAIN CO.  
MAP DEPT.

DATE 12.6.83

PAGE 12.00.061.B

BY T. McInair

VOID  
IF  
T.H. 8/8/84

FLY DT LOT CI