

25A.

972.70

COMBINATION

#15392


APPROVED
LORAIN CO.
MAP DEPT.

DATE 12.12.83

PAGE 12.00.061-B

BY T. Main

VOID AFTER T.M. 8/8/84

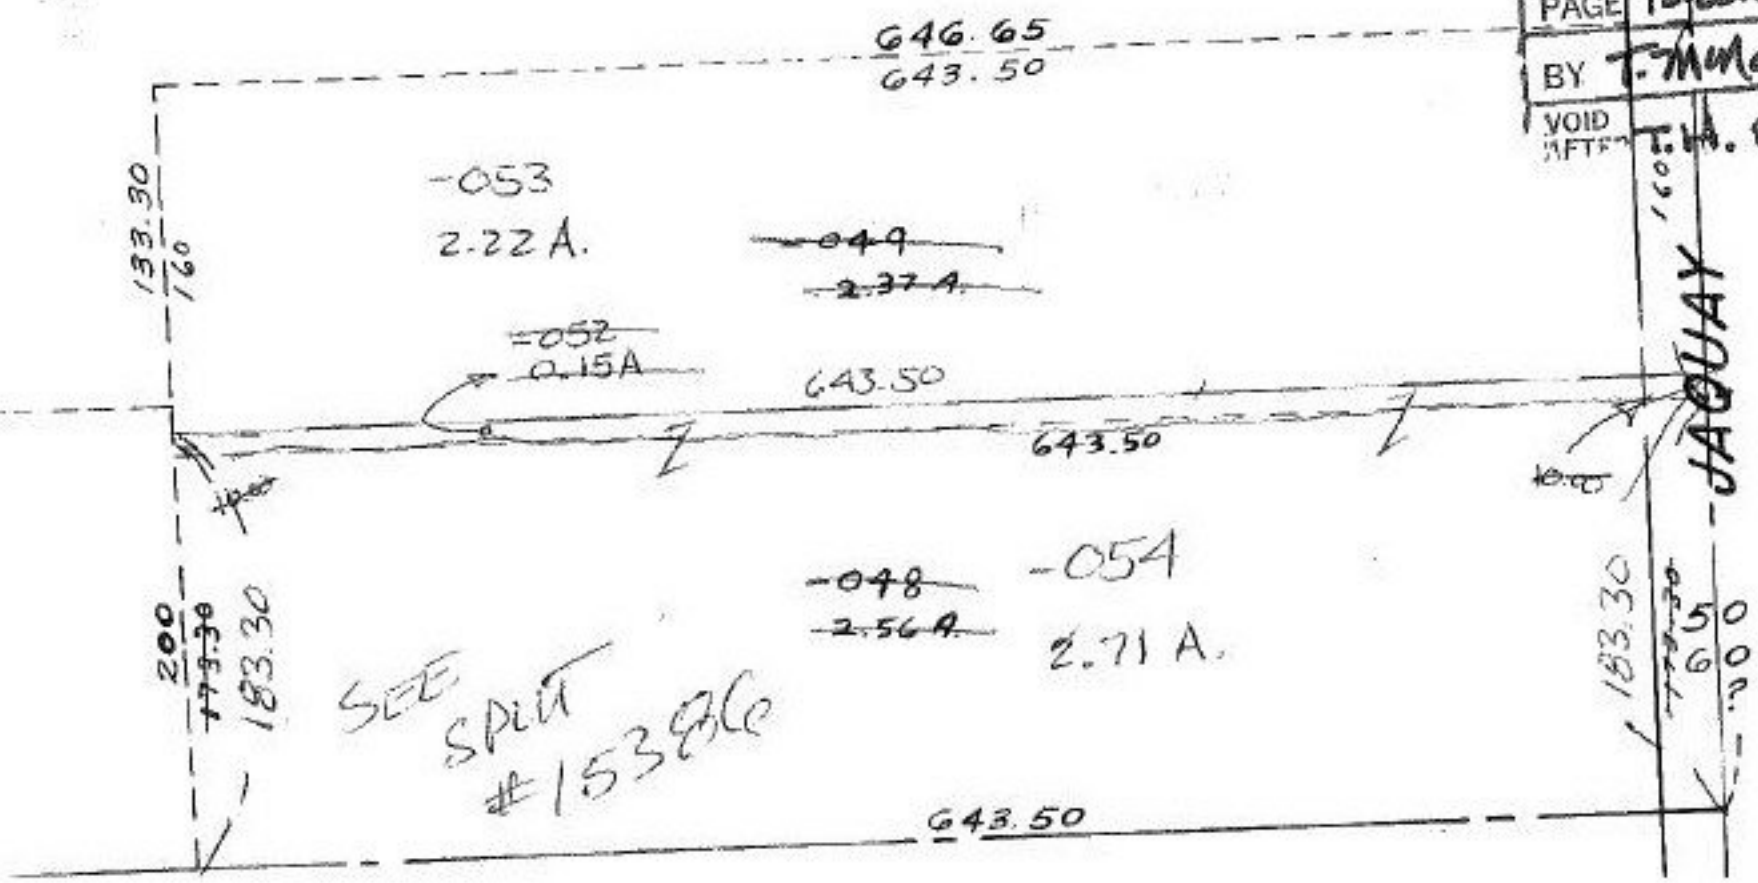

12-00-062-B

ELY. PT. LOT 61