


4-00-028-E

5-29-67  
5-28-67

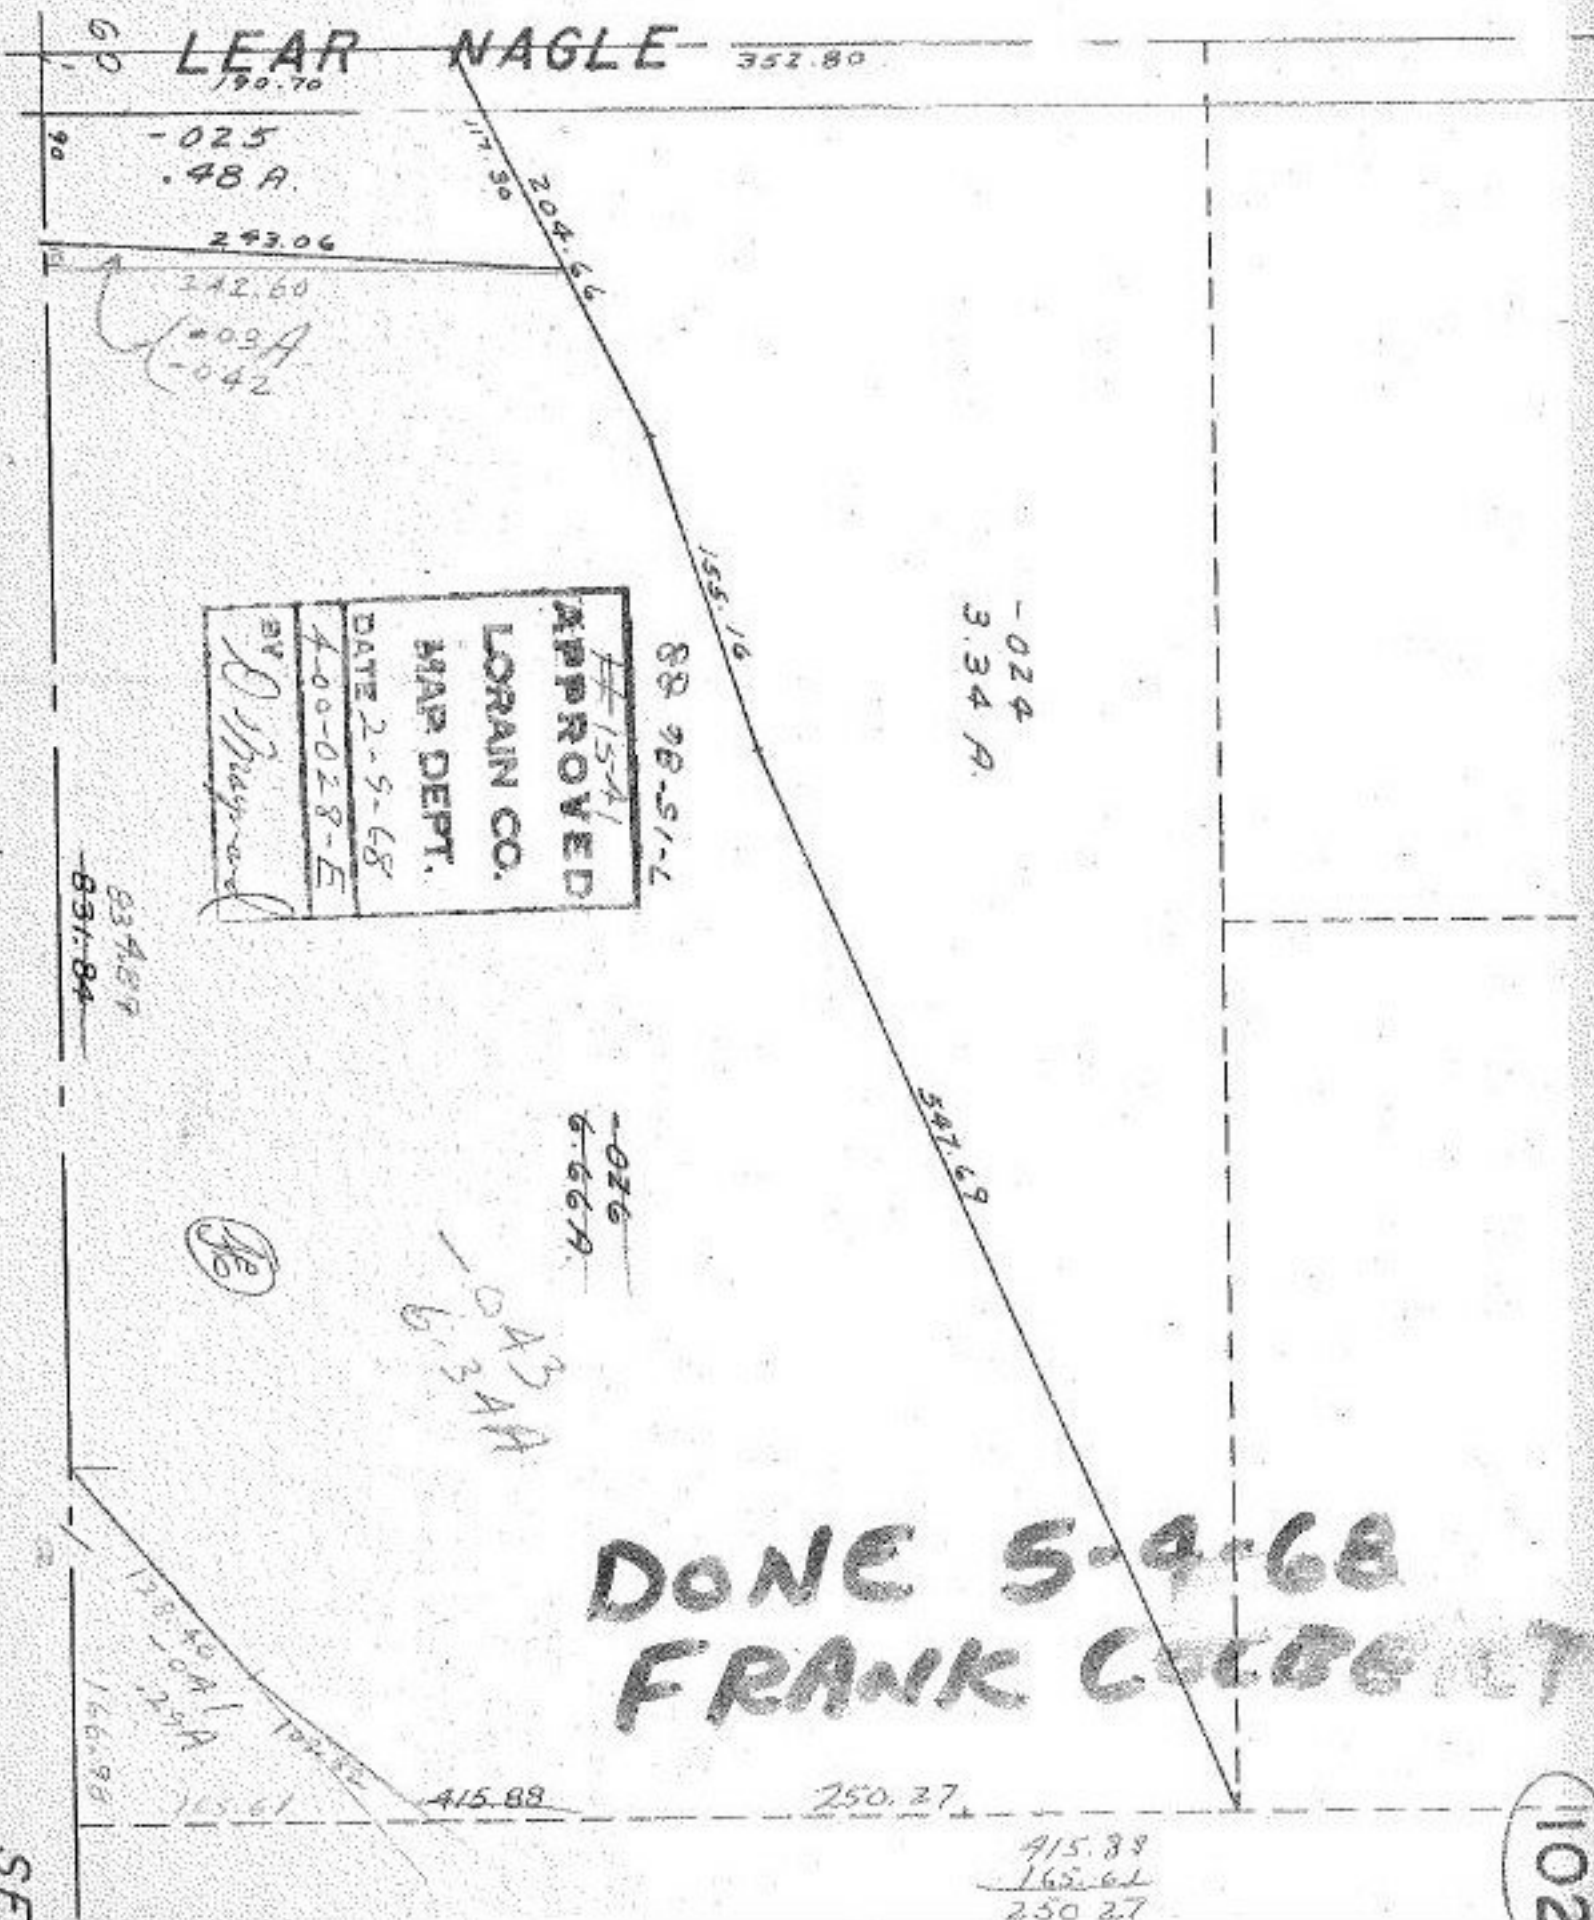

#1541  
 APPROVED  
 LORAIN CO.  
 MAP DEPT.  
 DATE 2-9-68  
 4-00-028-E  
 BY *[Signature]*

DONE 5-9-68  
 FRANK COBBETT

102

SE