


CHANGE PAGE 4-00-024-A.

Pt. -084
~~044~~ Pt. 20.61
 21.99A.

JAY COX

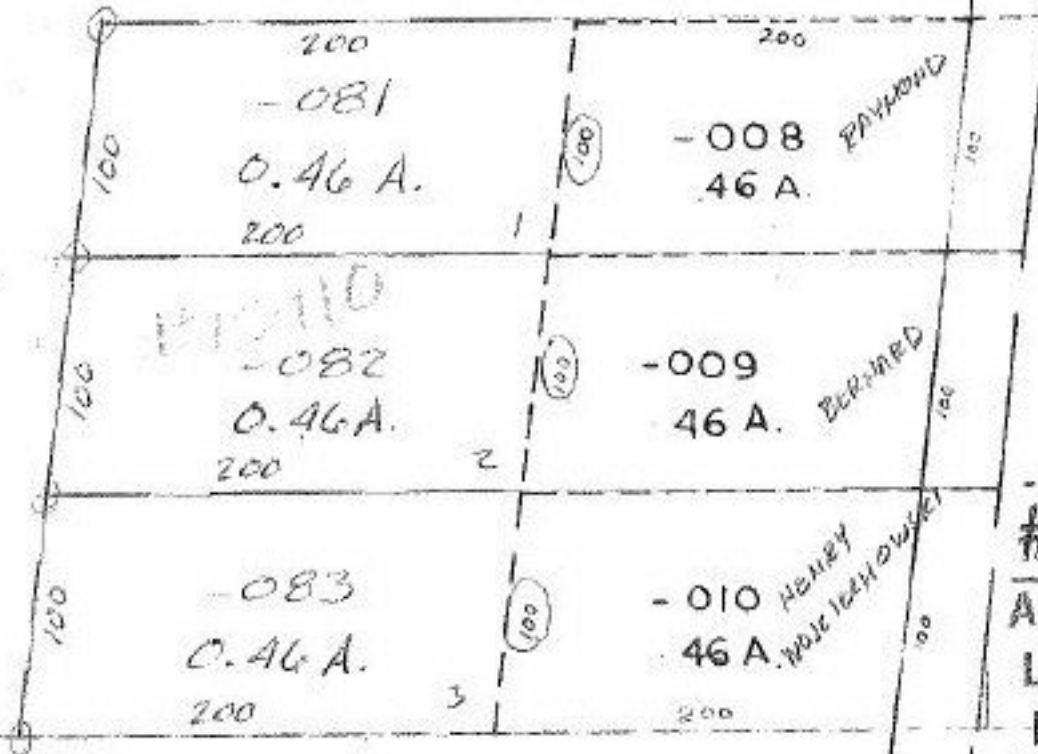

#15410
 APPROVED
 LORAIN CO.
 MAP DEPT.

DATE 12-28-03 SE

PAGE 4-00-024-B

BY T. Mylan

VOID
 AFTER

T.H. 3/14/05

AVC

[Handwritten signature]