


599.33
782.32

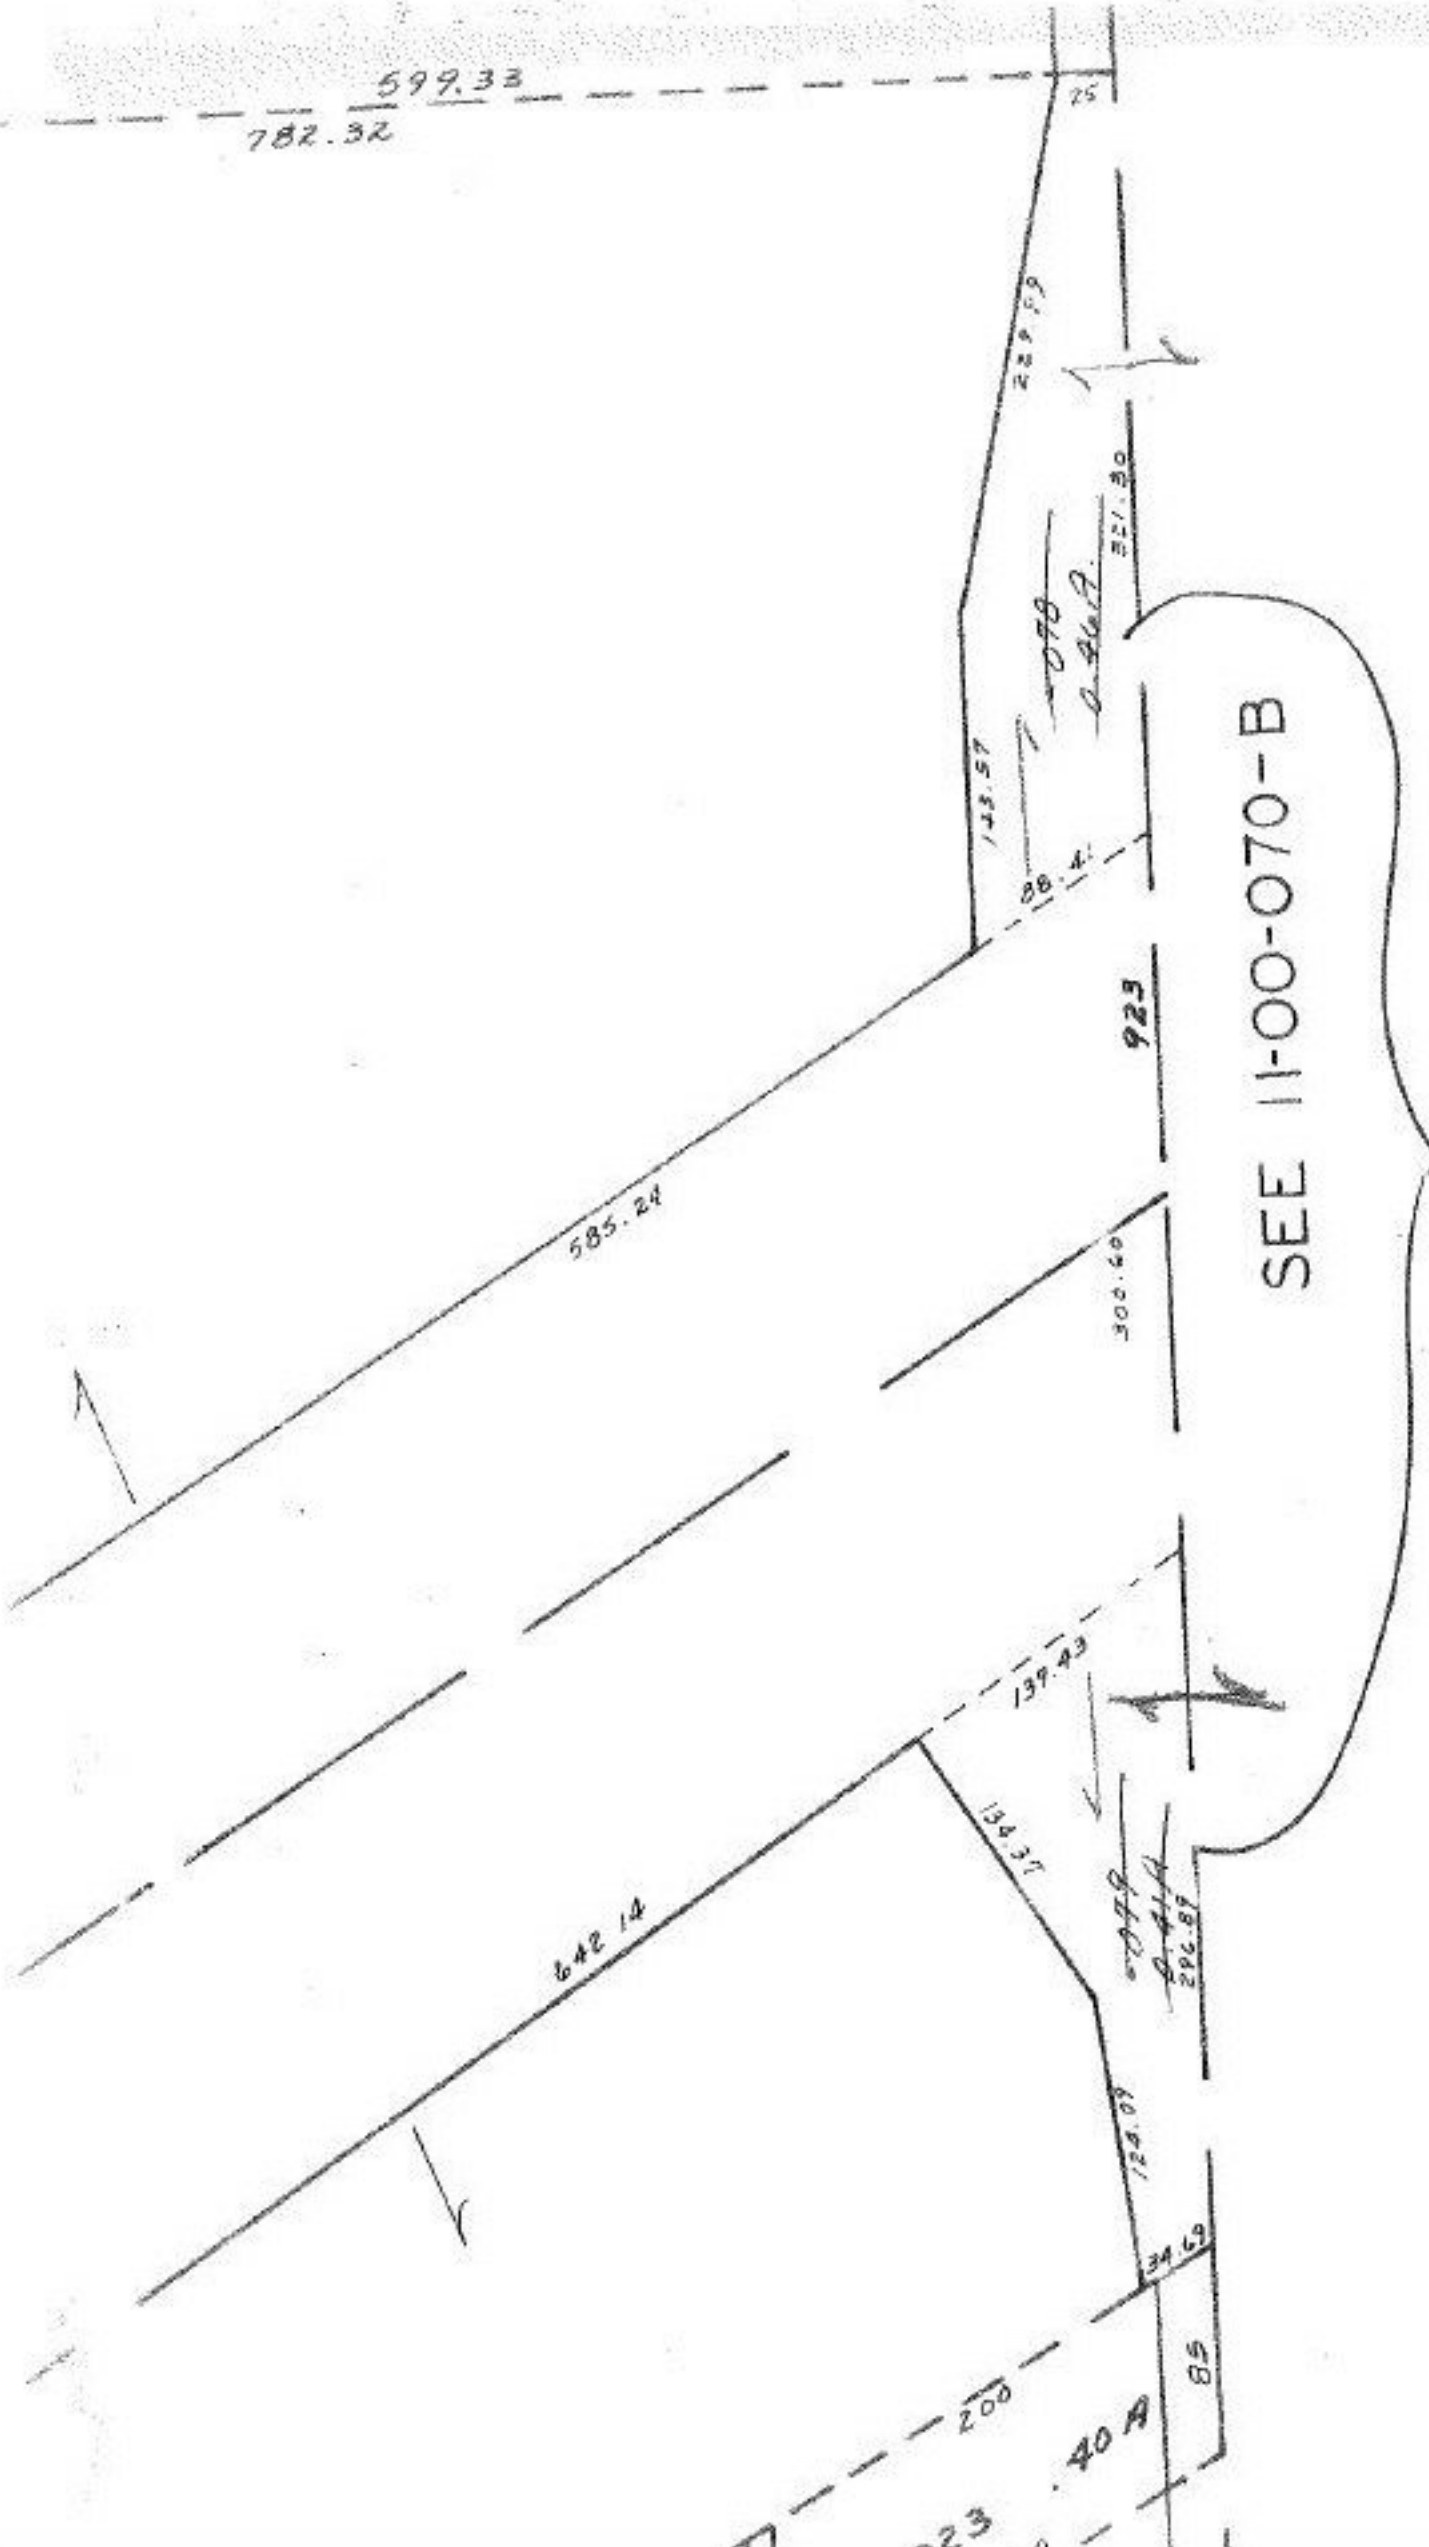

SEE 11-00-070-B

Pt: 11-00-070-900-001

Pt: 1.85 A

COMBINATION

#15432

APPROVED
LORAIN CO.
MAP DEPT.

DATE 1.19.84

PAGE 11-00-070-A

BY T. M. Main

VOID
IF
REPRODUCED

July 7-31-84