


- 0.000838 8016.81'
 - 0.005039
 68.915230 Ac. $\frac{1}{1,000,000}$ 27.58 A. JB

500
 -005
 2.58 A.
 500

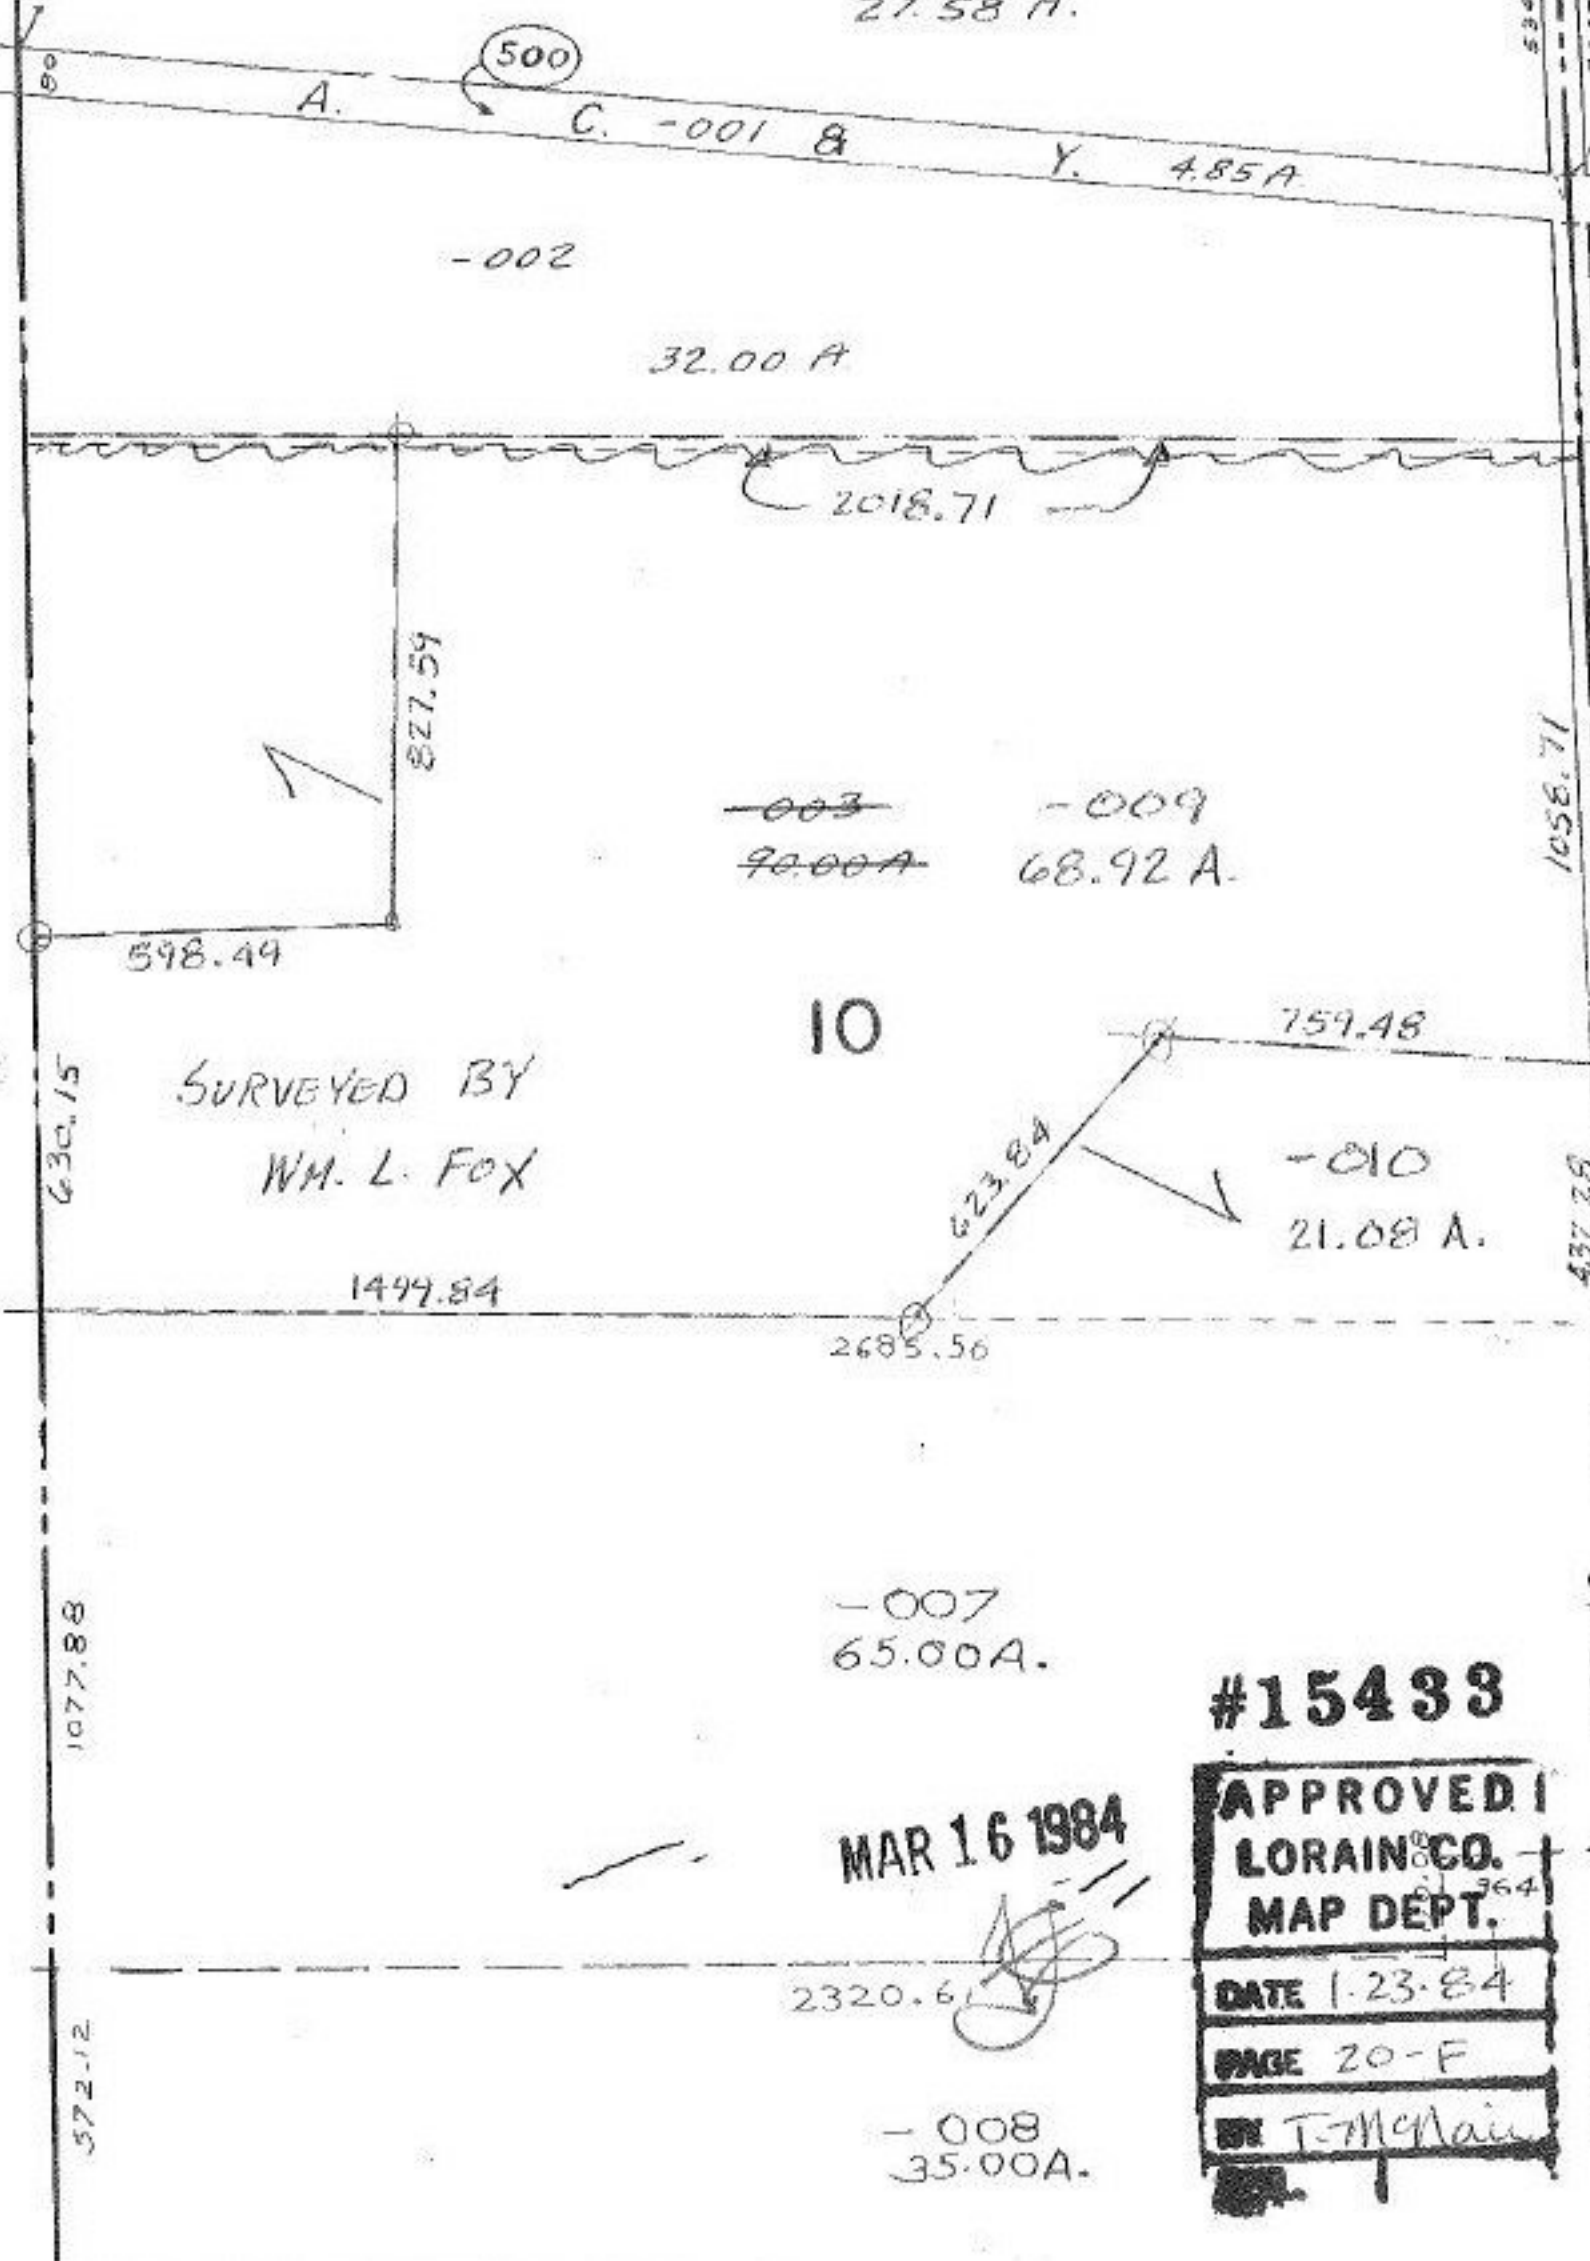

SURVEYED BY
 WM. L. FOX

10

#15438

MAR 16 1984

APPROVED
 LORAIN CO.
 MAP DEPT.
 DATE 1-23-84
 PAGE 20-F
 BY T. McMain

3430 FC 92 OF NEW LONDON ESSEX RD.