


MILLS AVON

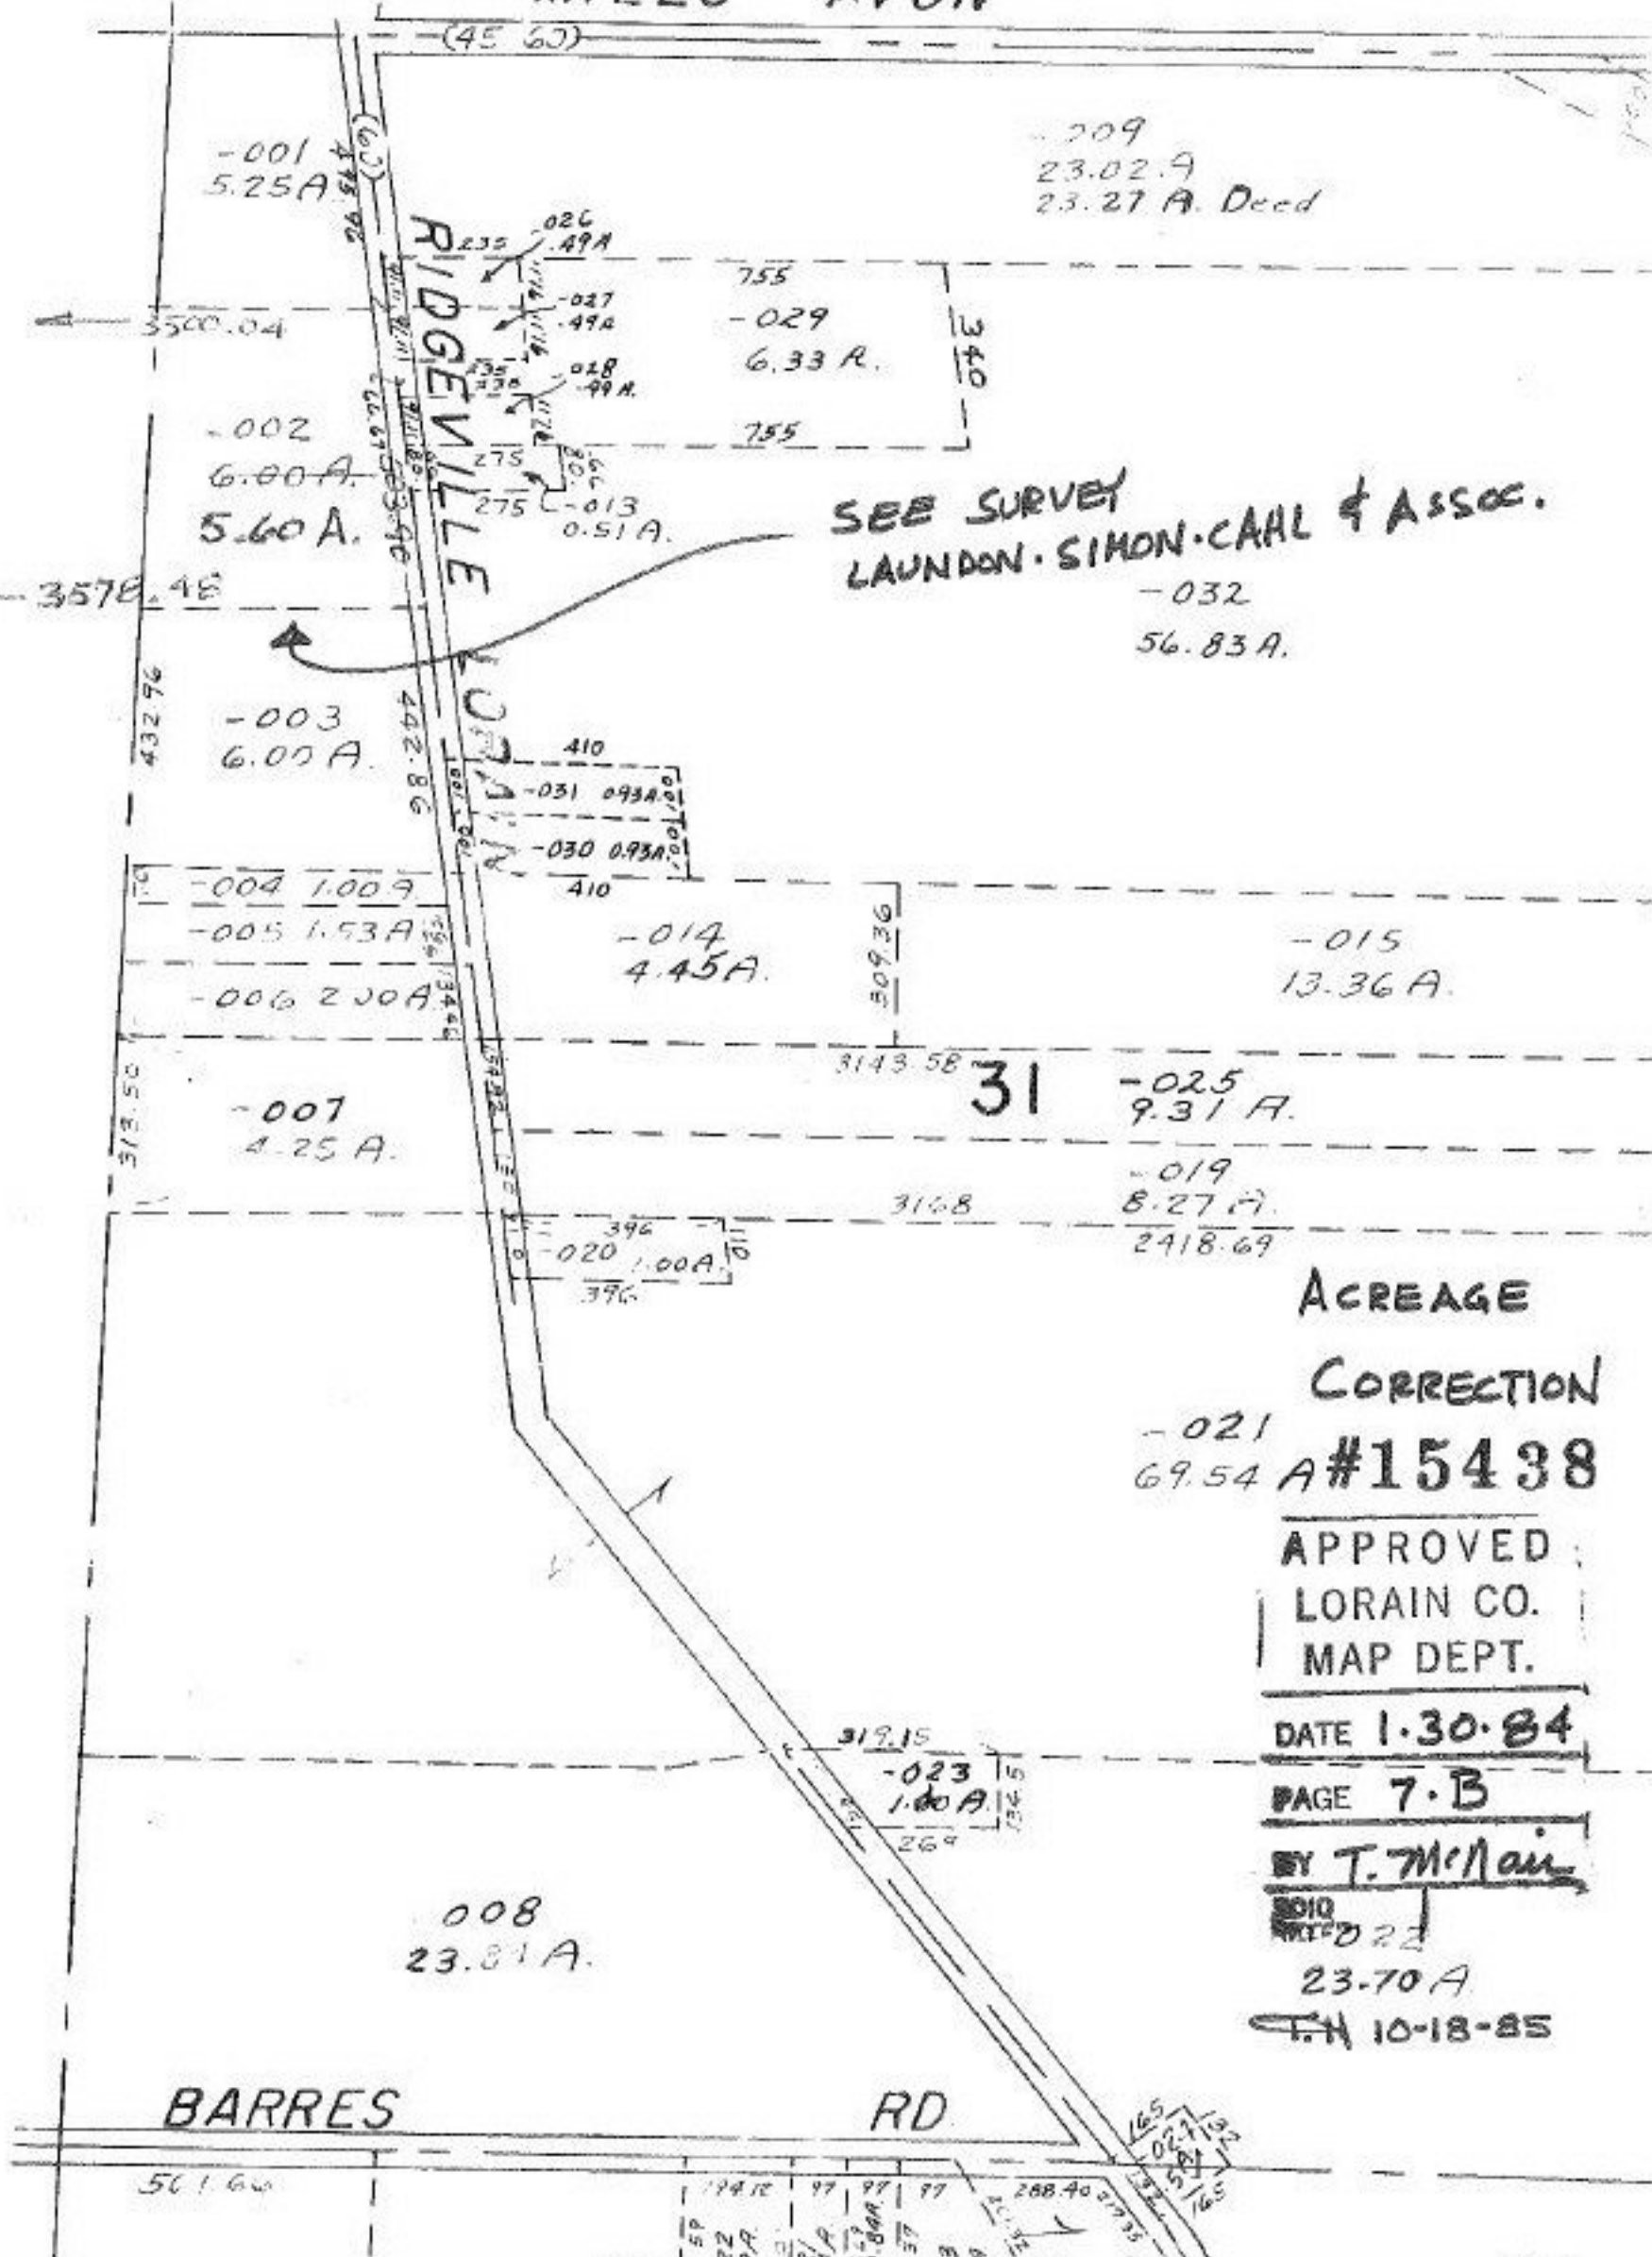

- 209  
23.02 A  
23.27 A. Deed

SEE SURVEY  
LAUNDON. SIMON. CAHL & ASSOC.

- 032  
56.83 A.

ACREAGE  
CORRECTION  
- 021  
69.54 A #15438

APPROVED  
LORAIN CO.  
MAP DEPT.

DATE 1.30.84

PAGE 7.B

BY T. McNeil

23-70 A

10-18-85

BARRES

RD

501.60

22 29 31 32 33 100