


SURVEY BY FOOR & ASSOC.

SEE 10-00-006-D

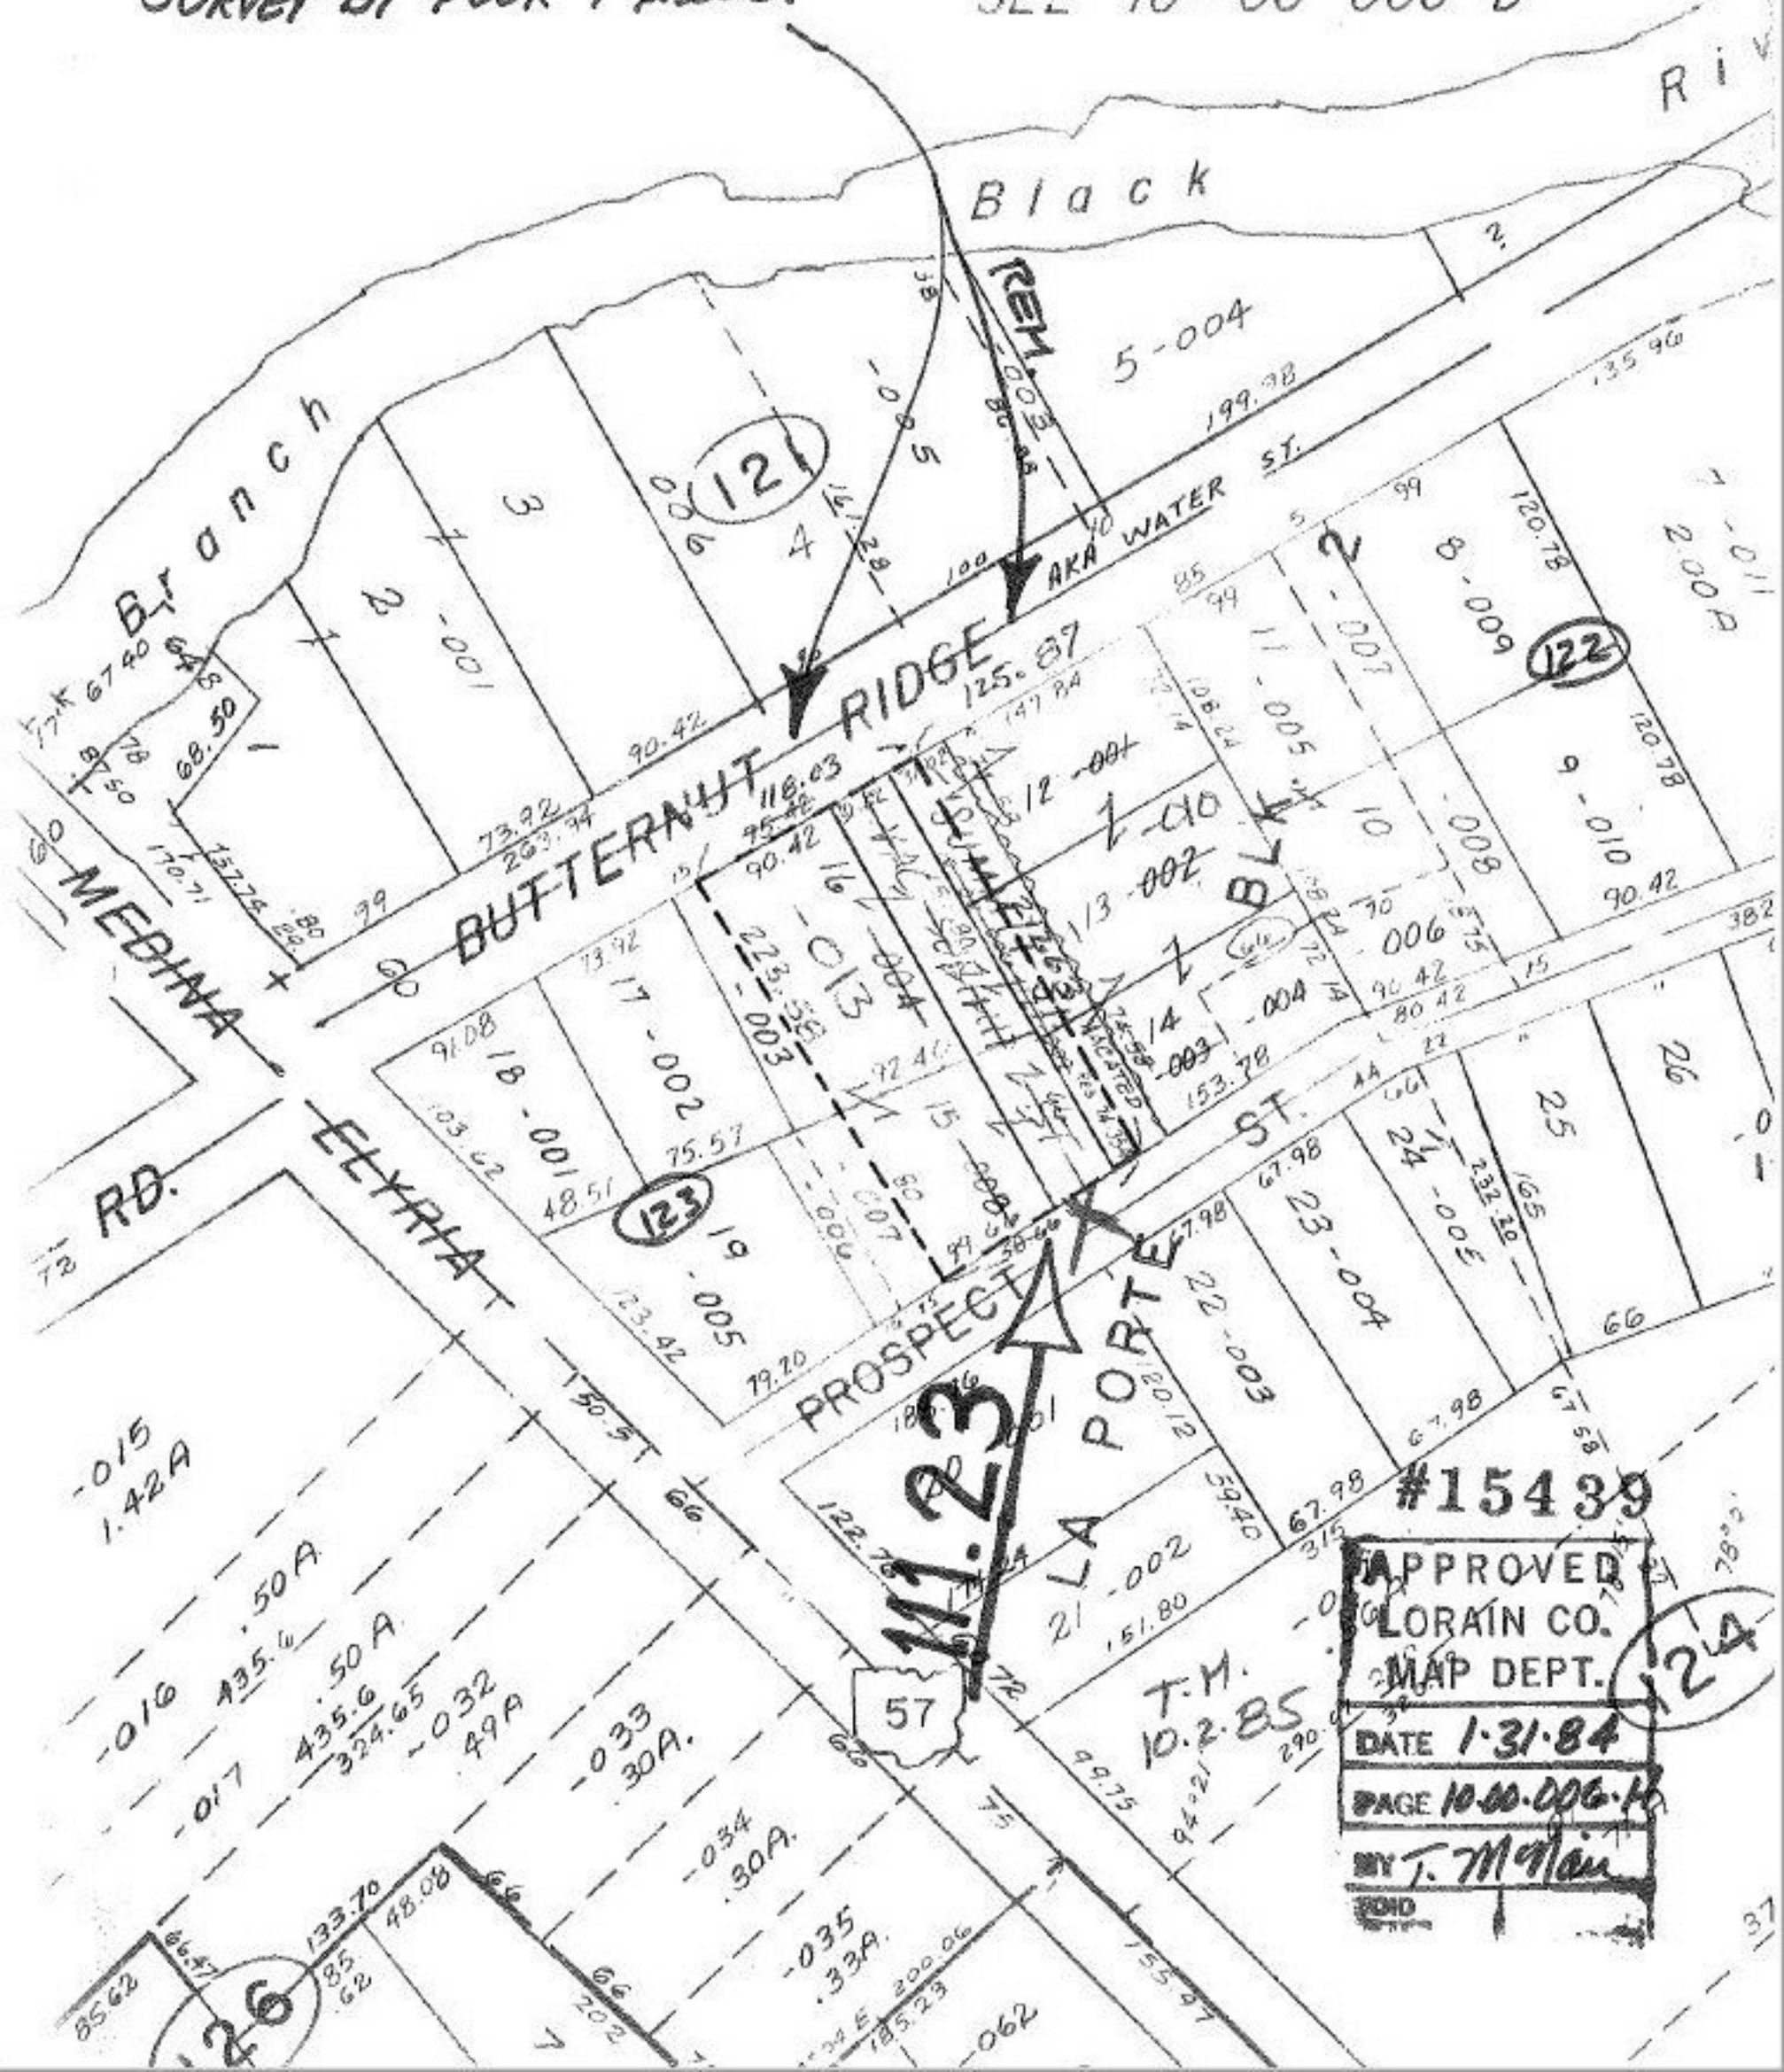

11.23

#15439

APPROVED
 LORAIN CO.
 MAP DEPT.

DATE 1-31-84

PAGE 10-00-006-10

BY T. M. McLean

123

121

122

124

26

57

37