


20.28 SEE 6-117

5.89°48'30"E

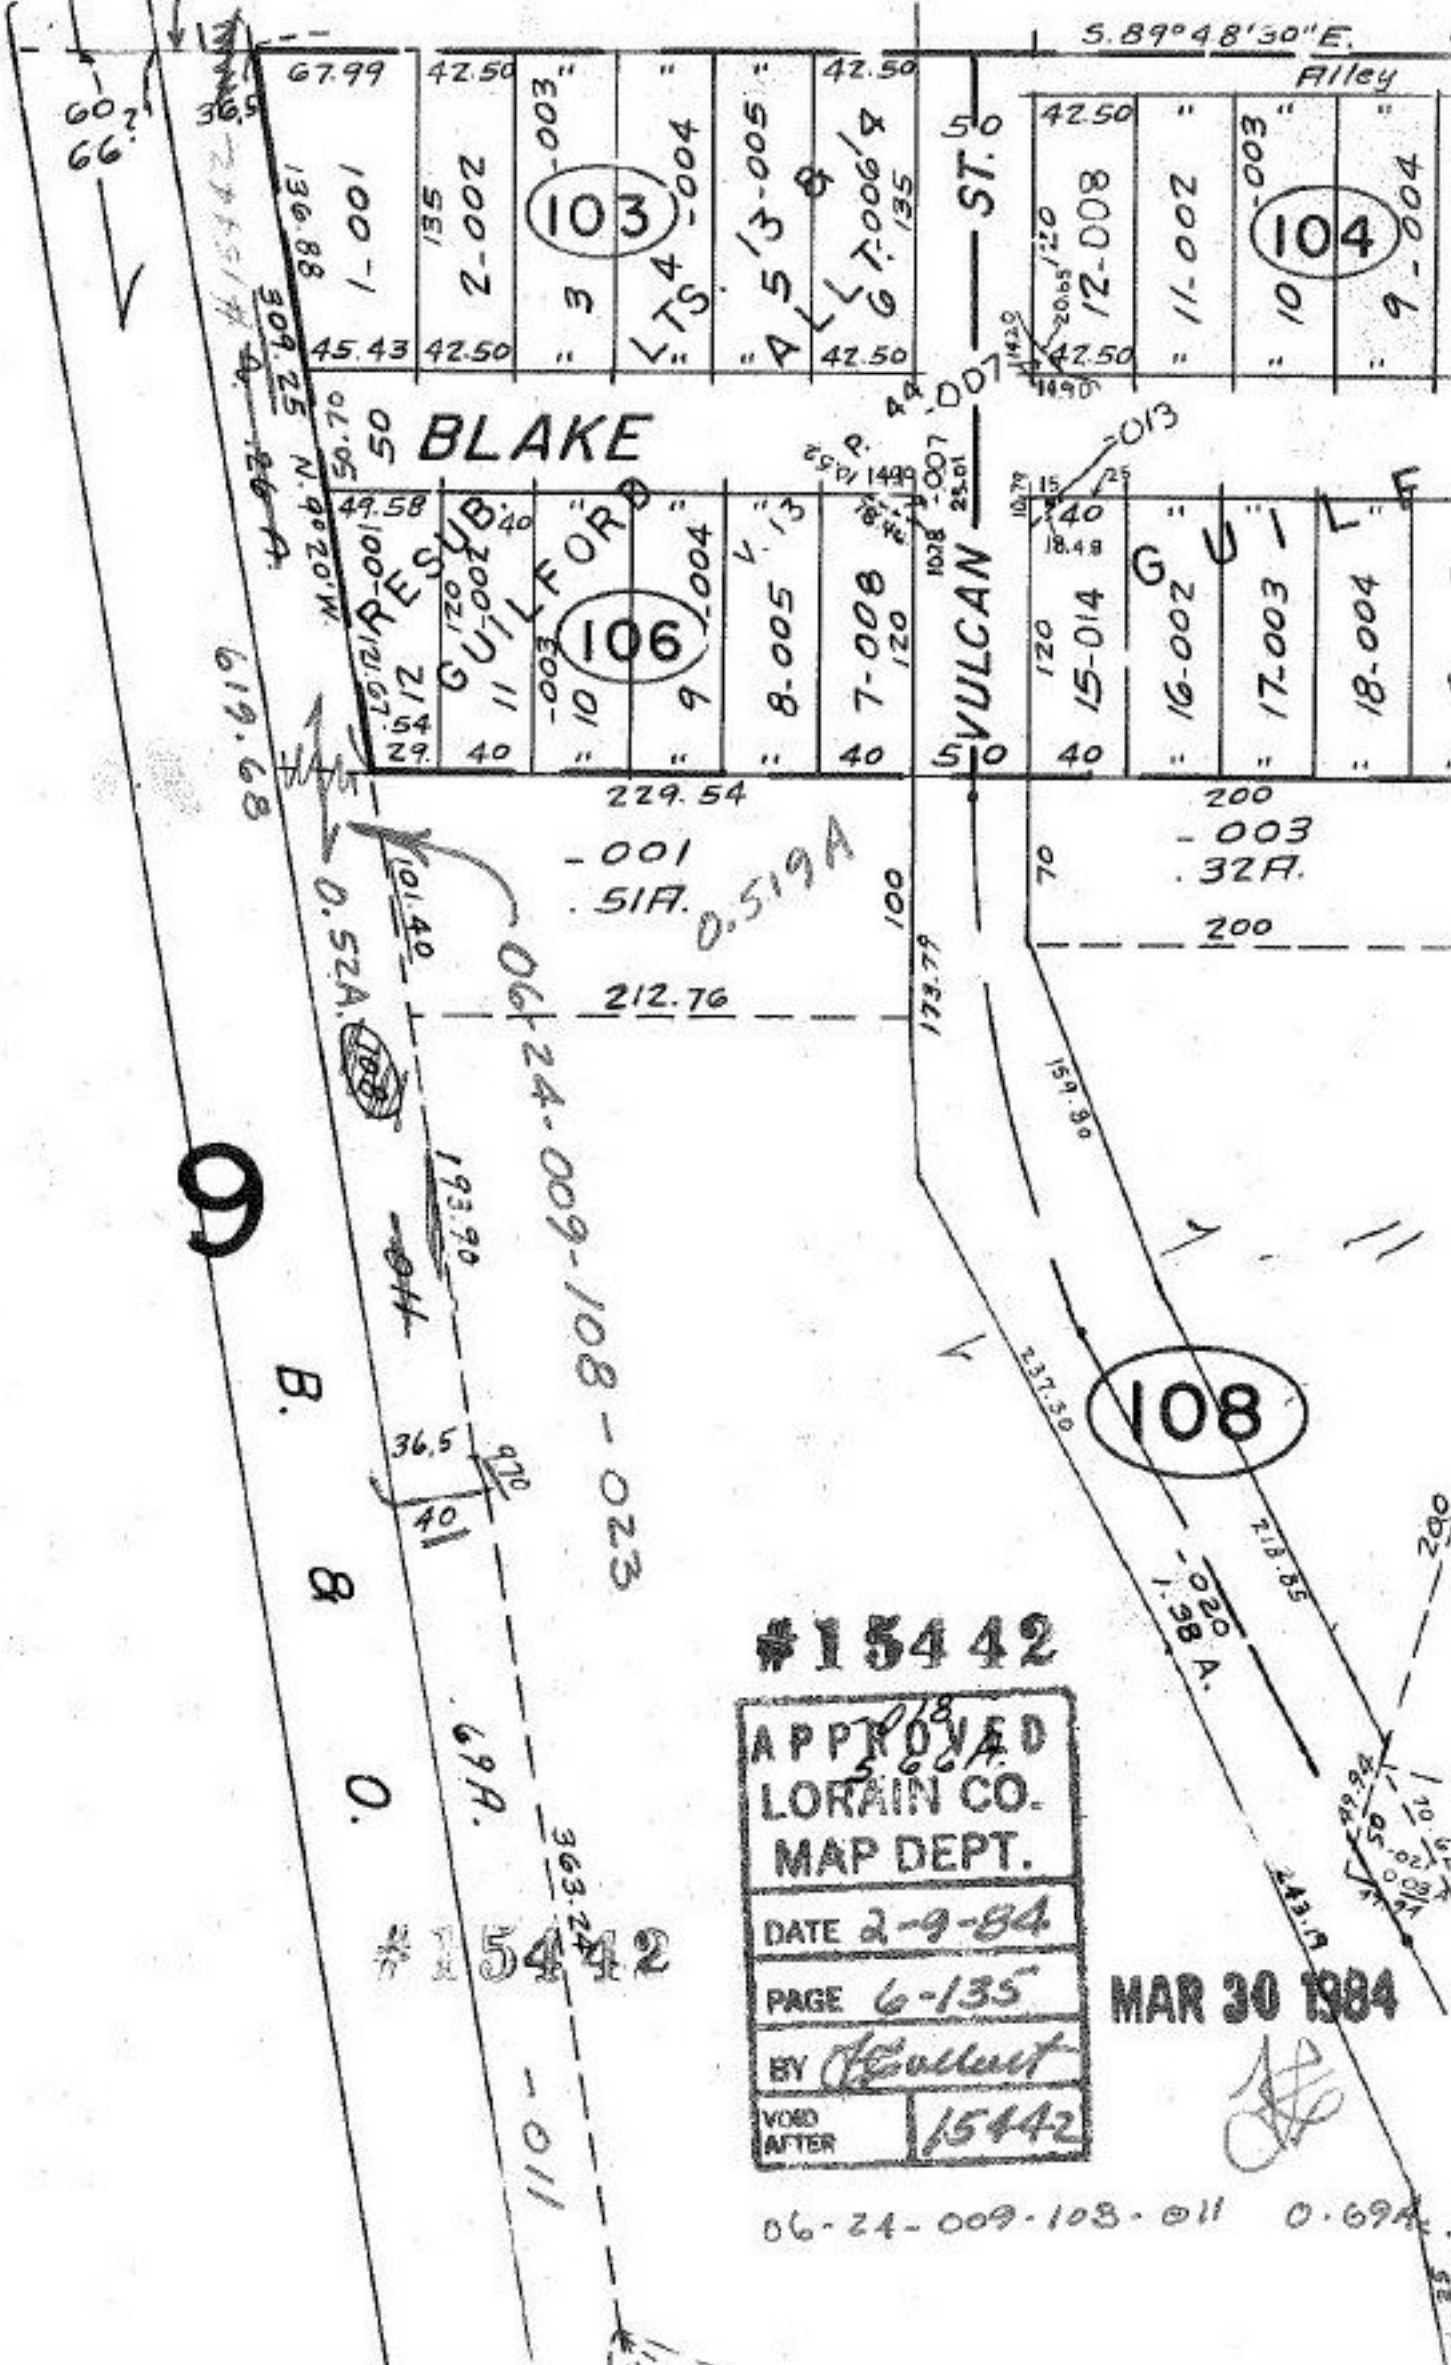

#15442

APPROVED
LORAIN CO.
MAP DEPT.
DATE 2-9-84
PAGE 6-135
BY <i>[Signature]</i>
VOID AFTER 15442

MAR 30 1984

06-24-009-108-011 0.69A