


SEE SURVEY  
A. KOEPP

SEE 9-00-023 B  
FOR REST OF SPIT

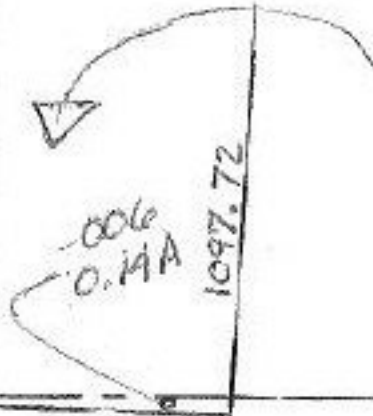

-001  
16.25F.

~~-003~~ -007  
~~10.25F.~~ 16.11A.

1261.92

1529.88

-002  
59.70F.

-004  
63.77F.

-001  
23.00F.

-009  
76.41A.

33

#15448

APPROVED  
LORAIN CO.  
MAP DEPT.

DATE 3-1-84

PAGE 9-A

BY T. McMain

DATE

12-19-85

1230.9

25.92

1833.48

233.48

505.56

13.11

465

1097.72

0.14A

515.46

20

300