


SEE

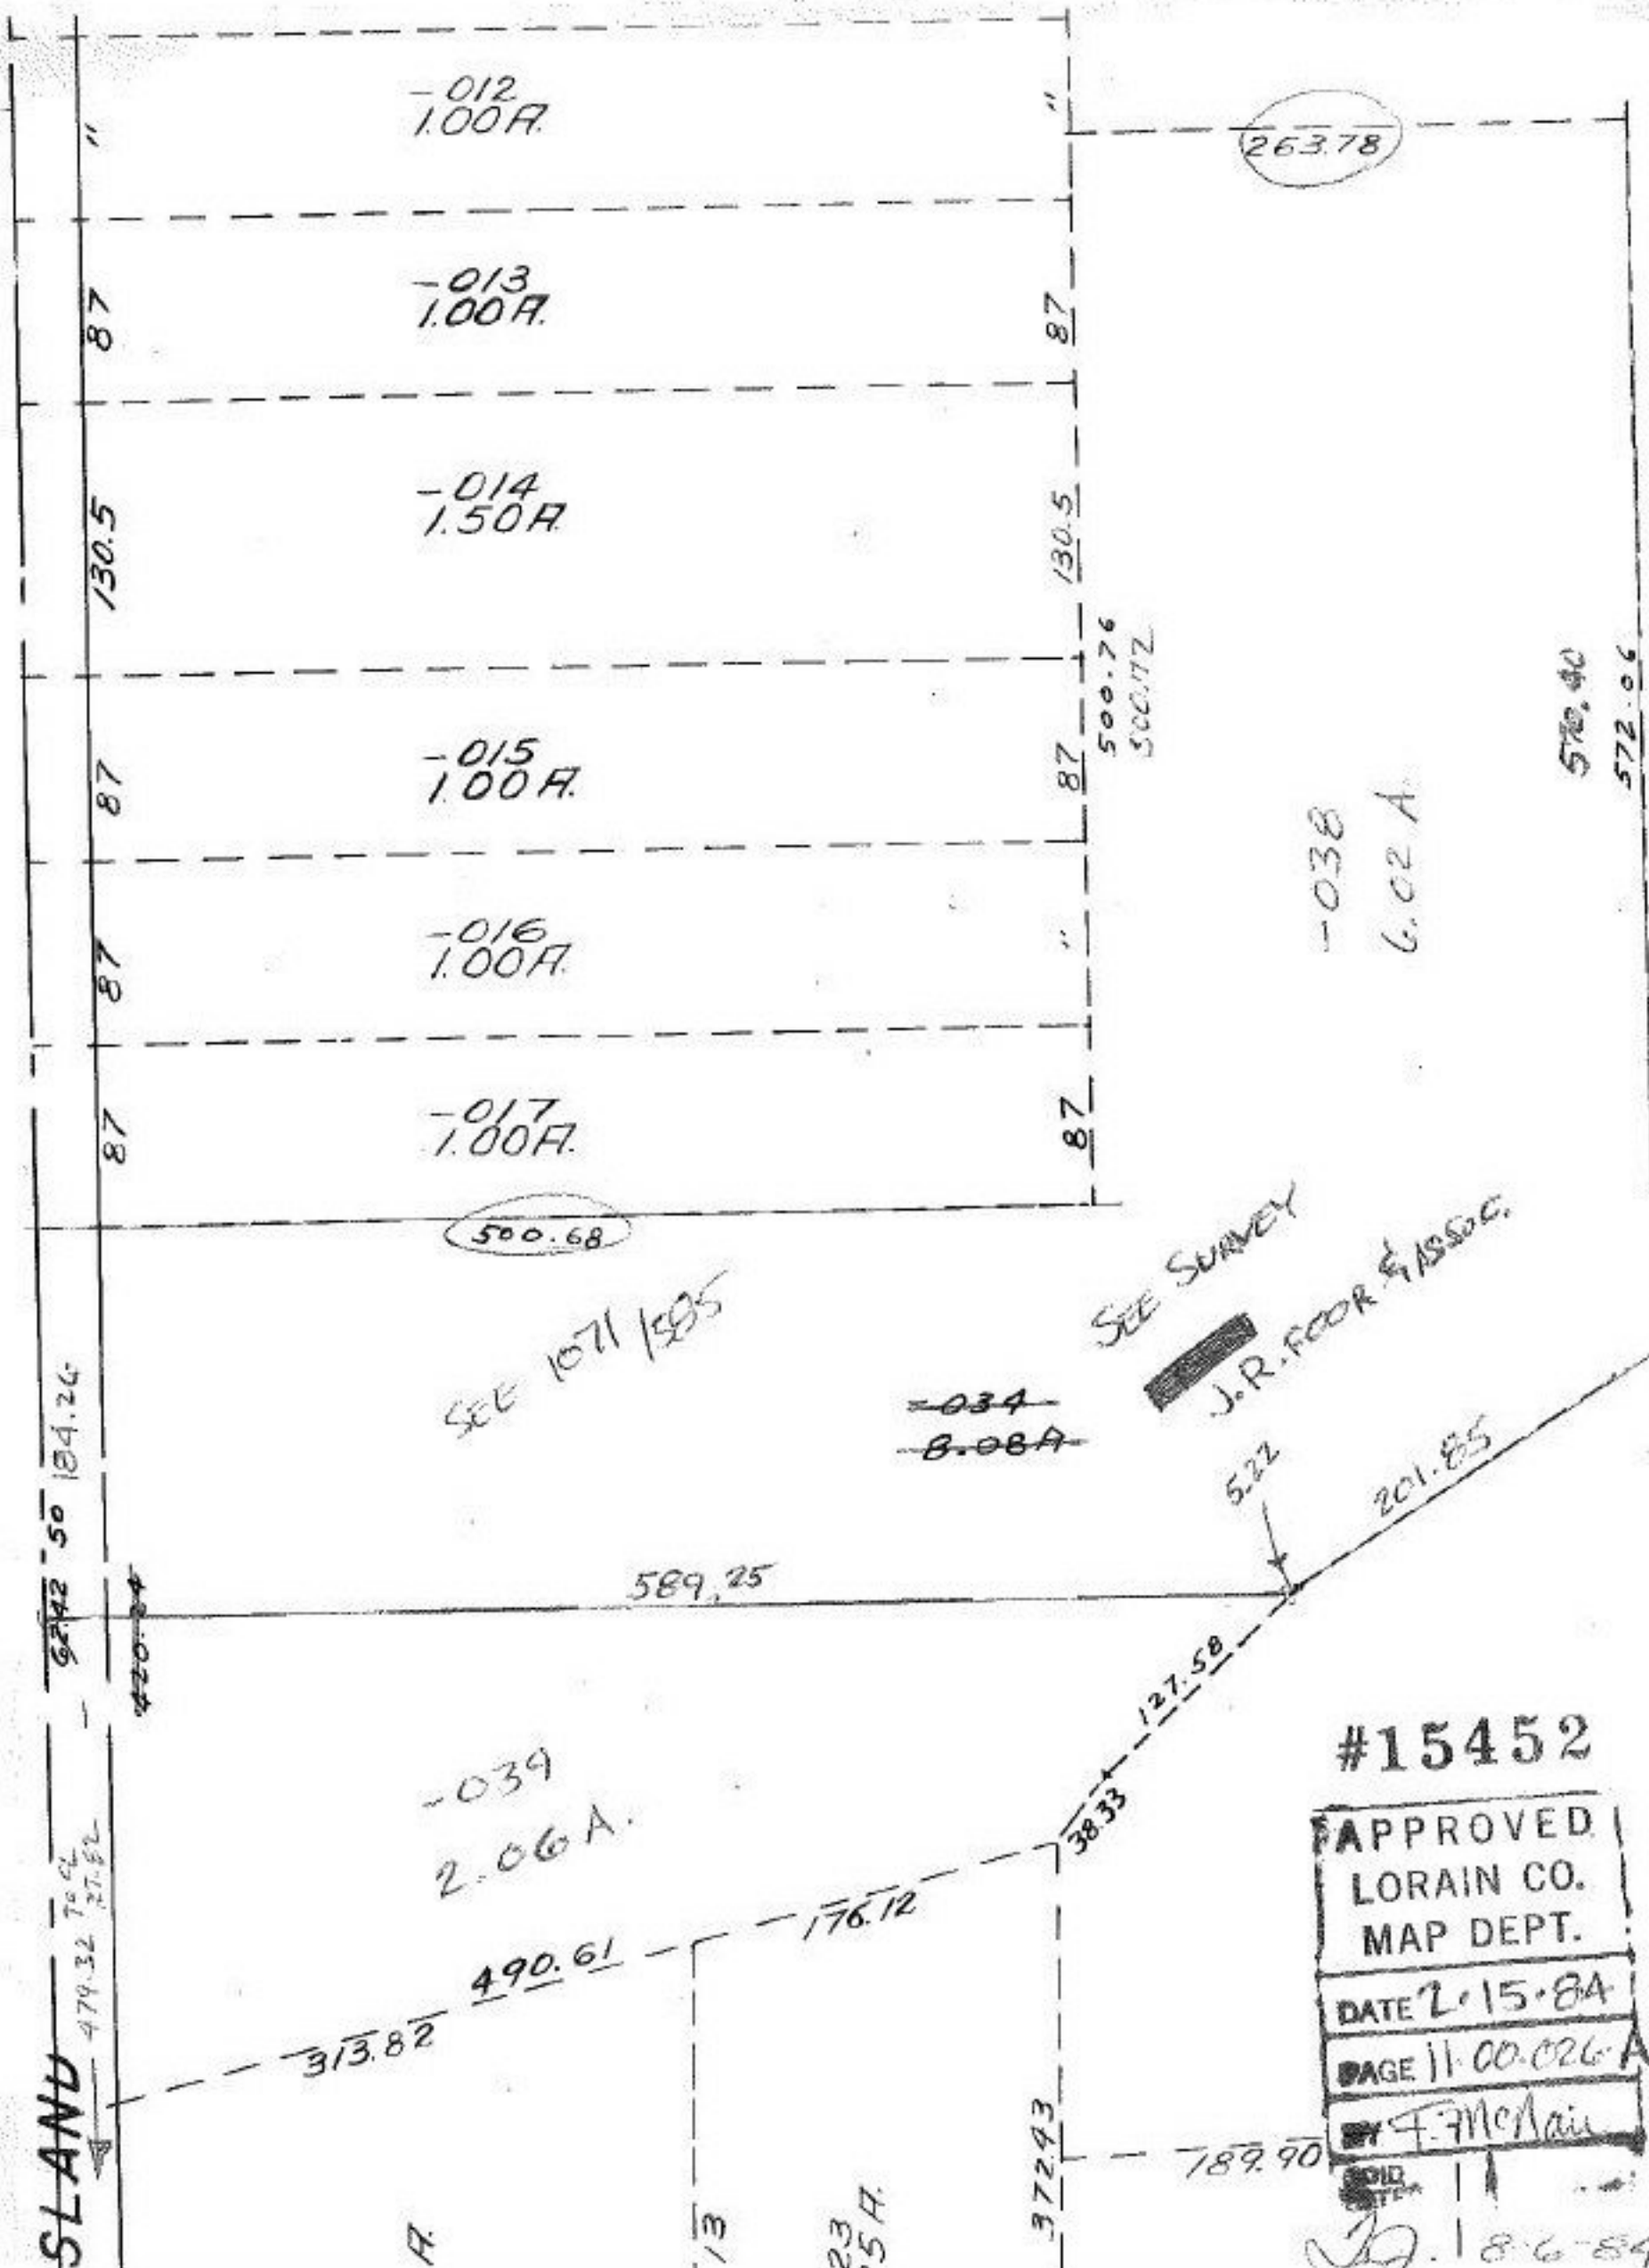

263.78

-012
1.00 A.

-013
1.00 A.

-014
1.50 A.

-015
1.00 A.

-016
1.00 A.

-017
1.00 A.

500.68

SEE 1071/595

~~-034~~
~~8.08A~~

SEE SURVEY
J.R. FLOOR & ASSOC.

-038
6.02 A.

570.40
572.06

589.25

-039
2.06 A.

#15452

APPROVED
LORAIN CO.
MAP DEPT.
DATE 2.15.84
PAGE 11.00.026-A
F. F. McNeil

18.6.84

SLAND
479.32 70 CL
420.84
5242 50 104.26

A

13

23
35 A.

372.93

189.90