


059  
6.02A

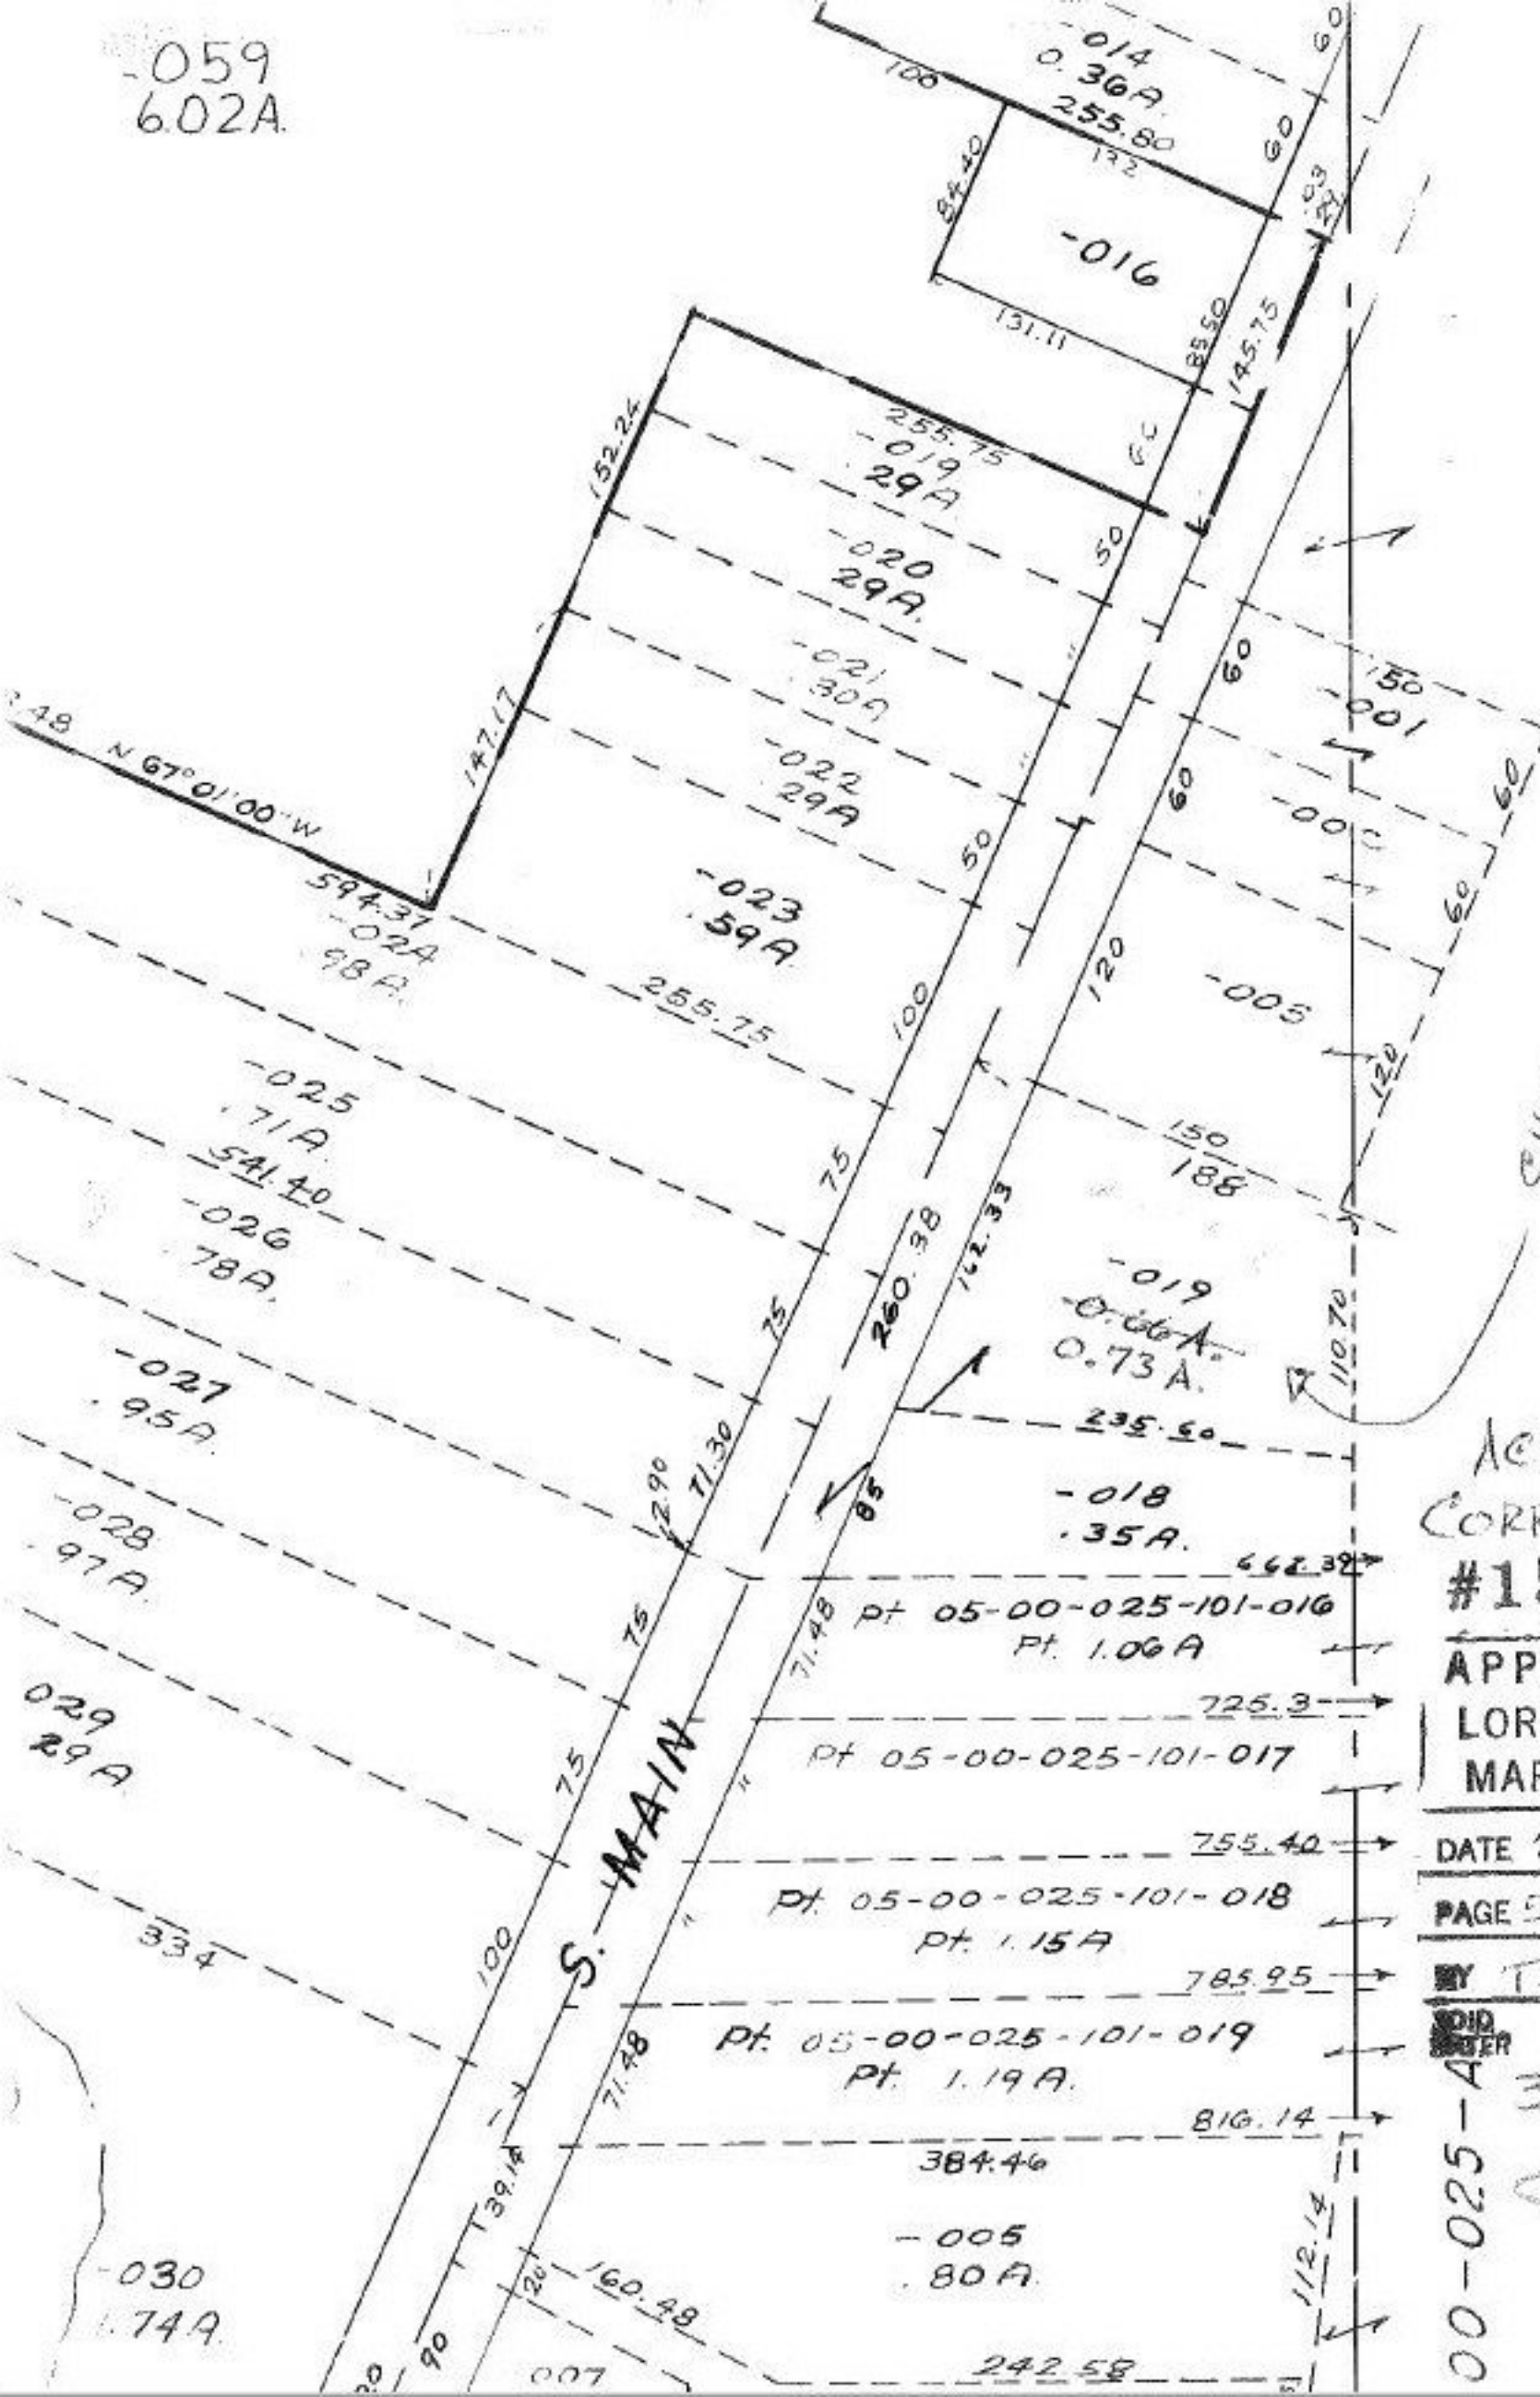

CHANGED PER  
D.V. 1182/1429

ACREAGE  
CORRECTION  
#15456

APPROVED  
LORAIN CO.  
MAP DEPT.

DATE 2-24-84  
PAGE 5-00-016-B  
BY T. McHain

3-1-84  
00-025-A  
*[Signature]*

- Pt. 05-00-025-101-016  
Pt. 1.06A
- Pt. 05-00-025-101-017
- Pt. 05-00-025-101-018  
Pt. 1.15A
- Pt. 05-00-025-101-019  
Pt. 1.19A