


**WOODFORD**

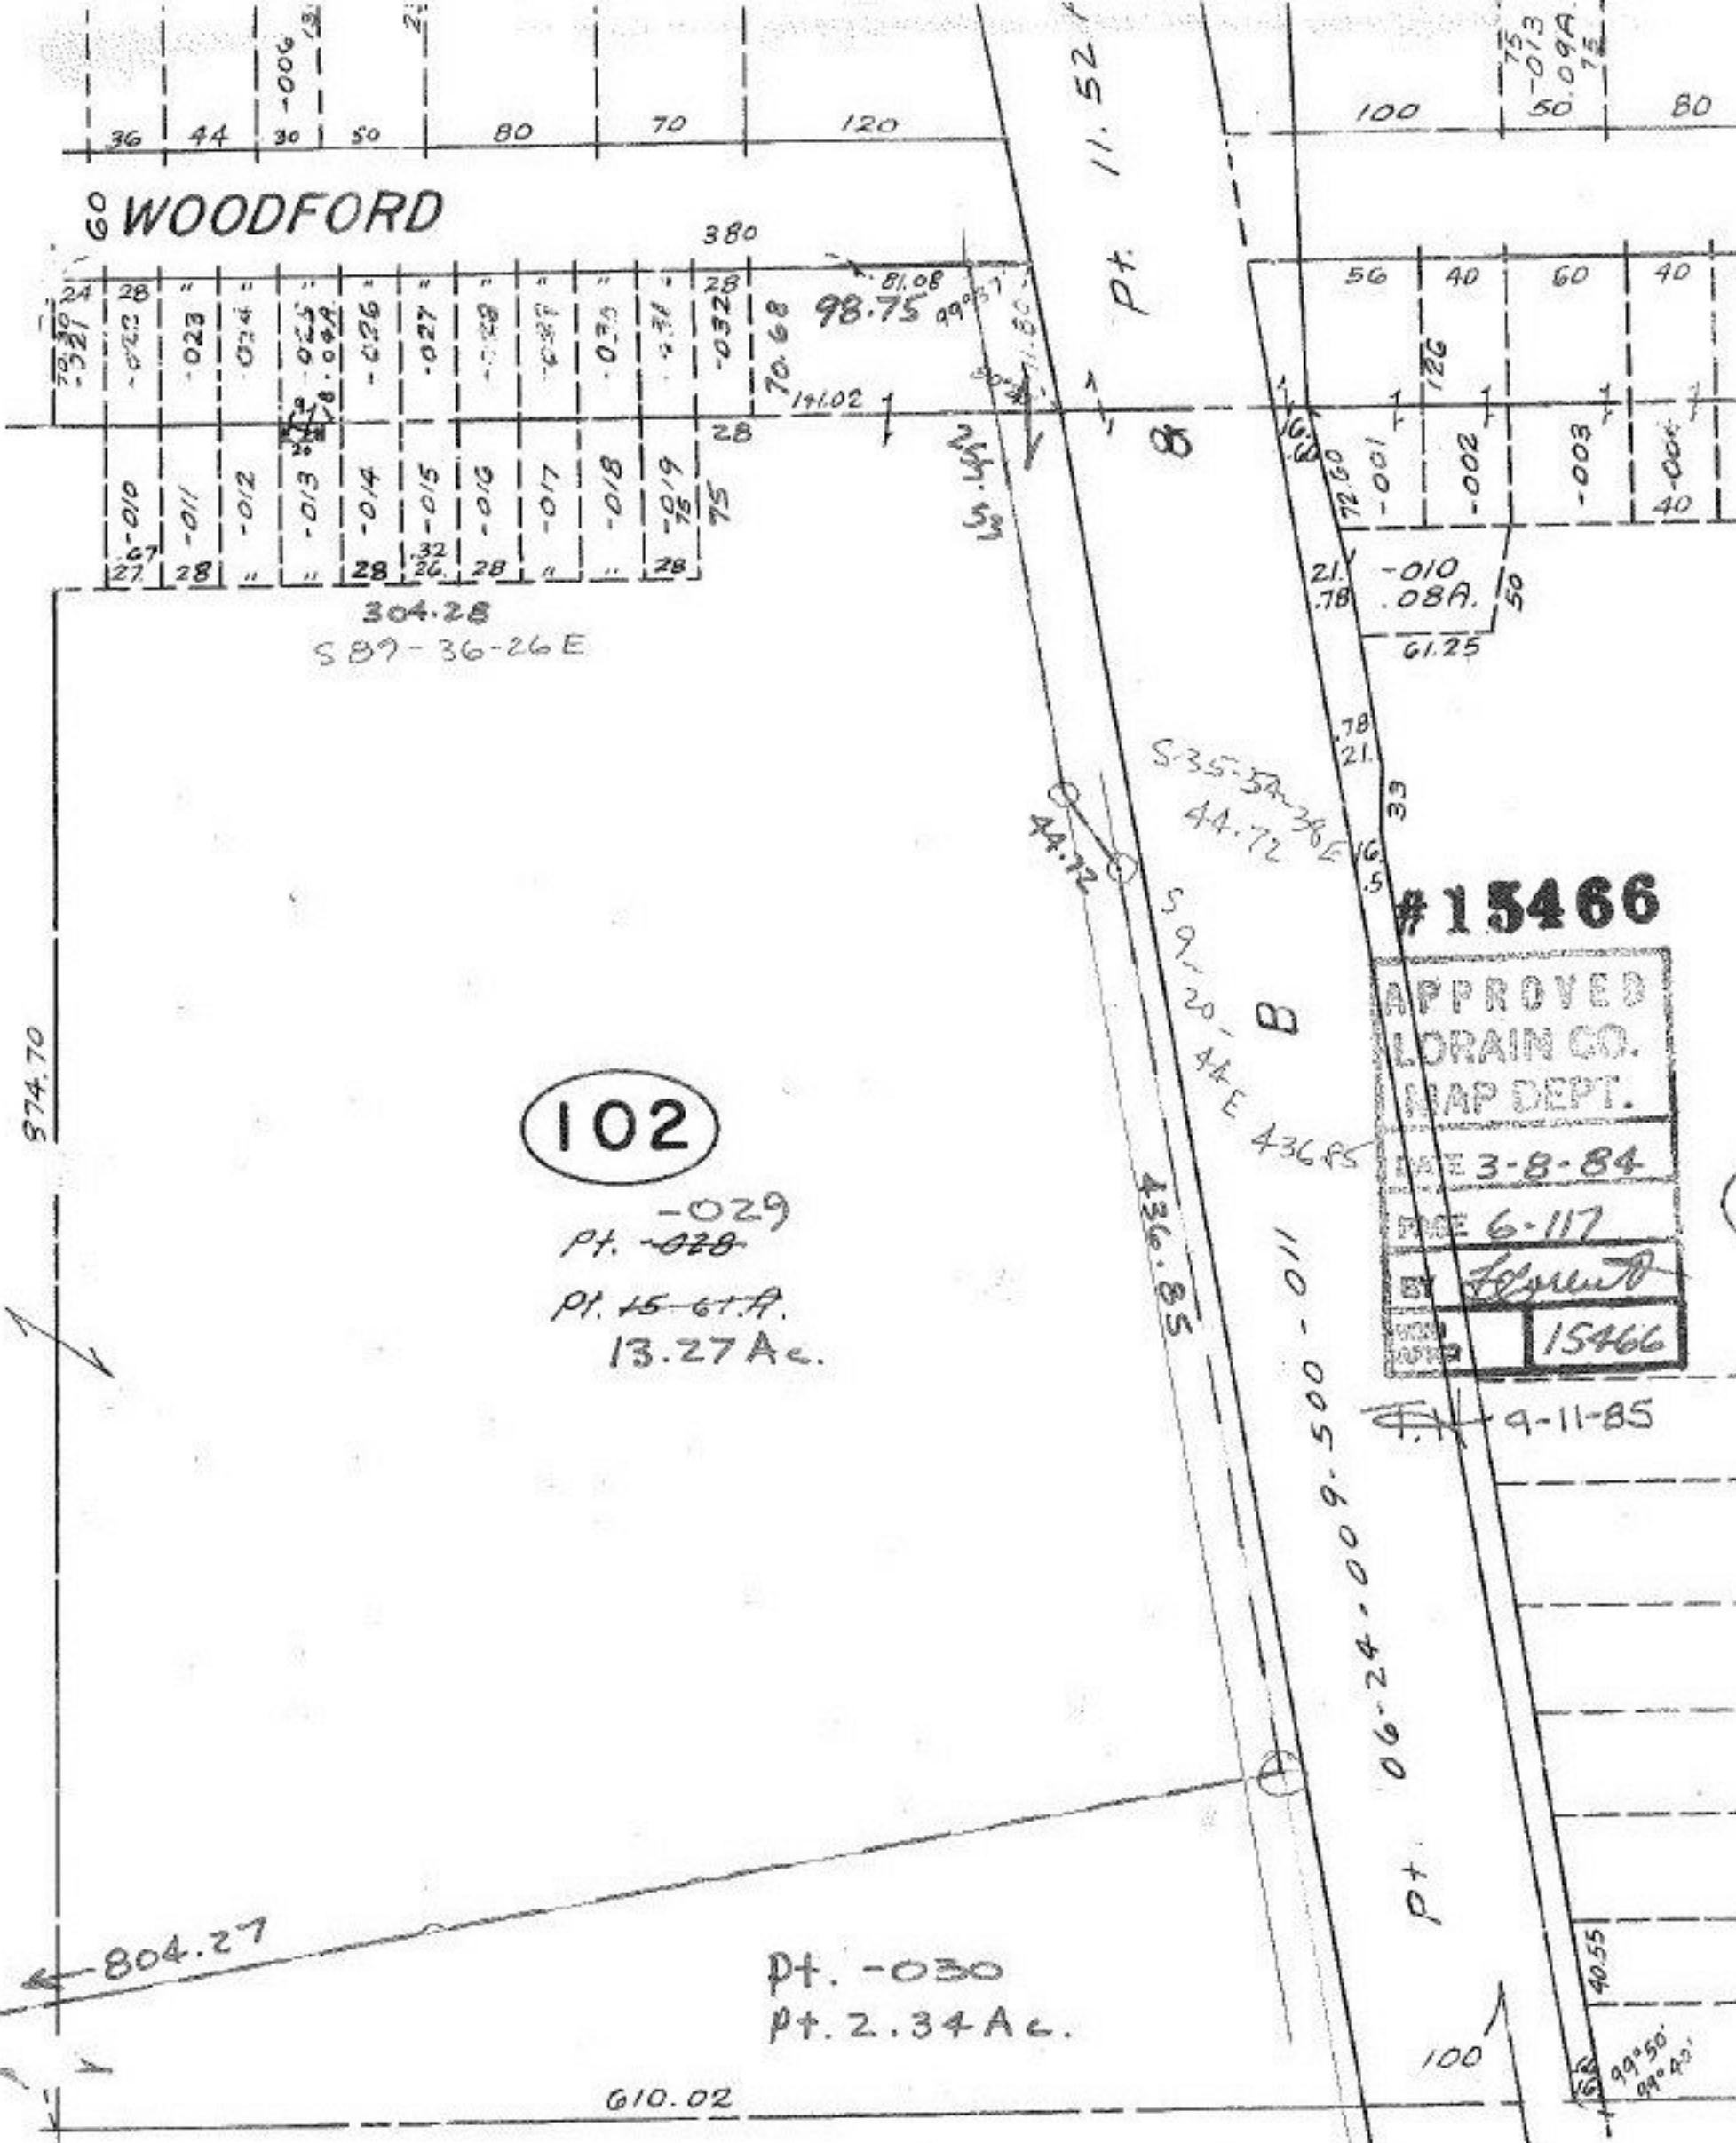

**102**

-029  
Pt. -028  
Pt. 15-61A.  
13.27 Ac.

**#15466**

APPROVED  
LORAIN CO.  
MAP DEPT.  
DATE 3-8-84  
DATE 6-117  
BY *[Signature]*  
15466

9-11-85

579-59W 804.27