

-007

101

-008
1.06 A.


-009
0.55 A.

-010
0.60 A.

-011
0.89 A.

Block. NA
-012

LAKWOOD BEACH
V.10 F.29

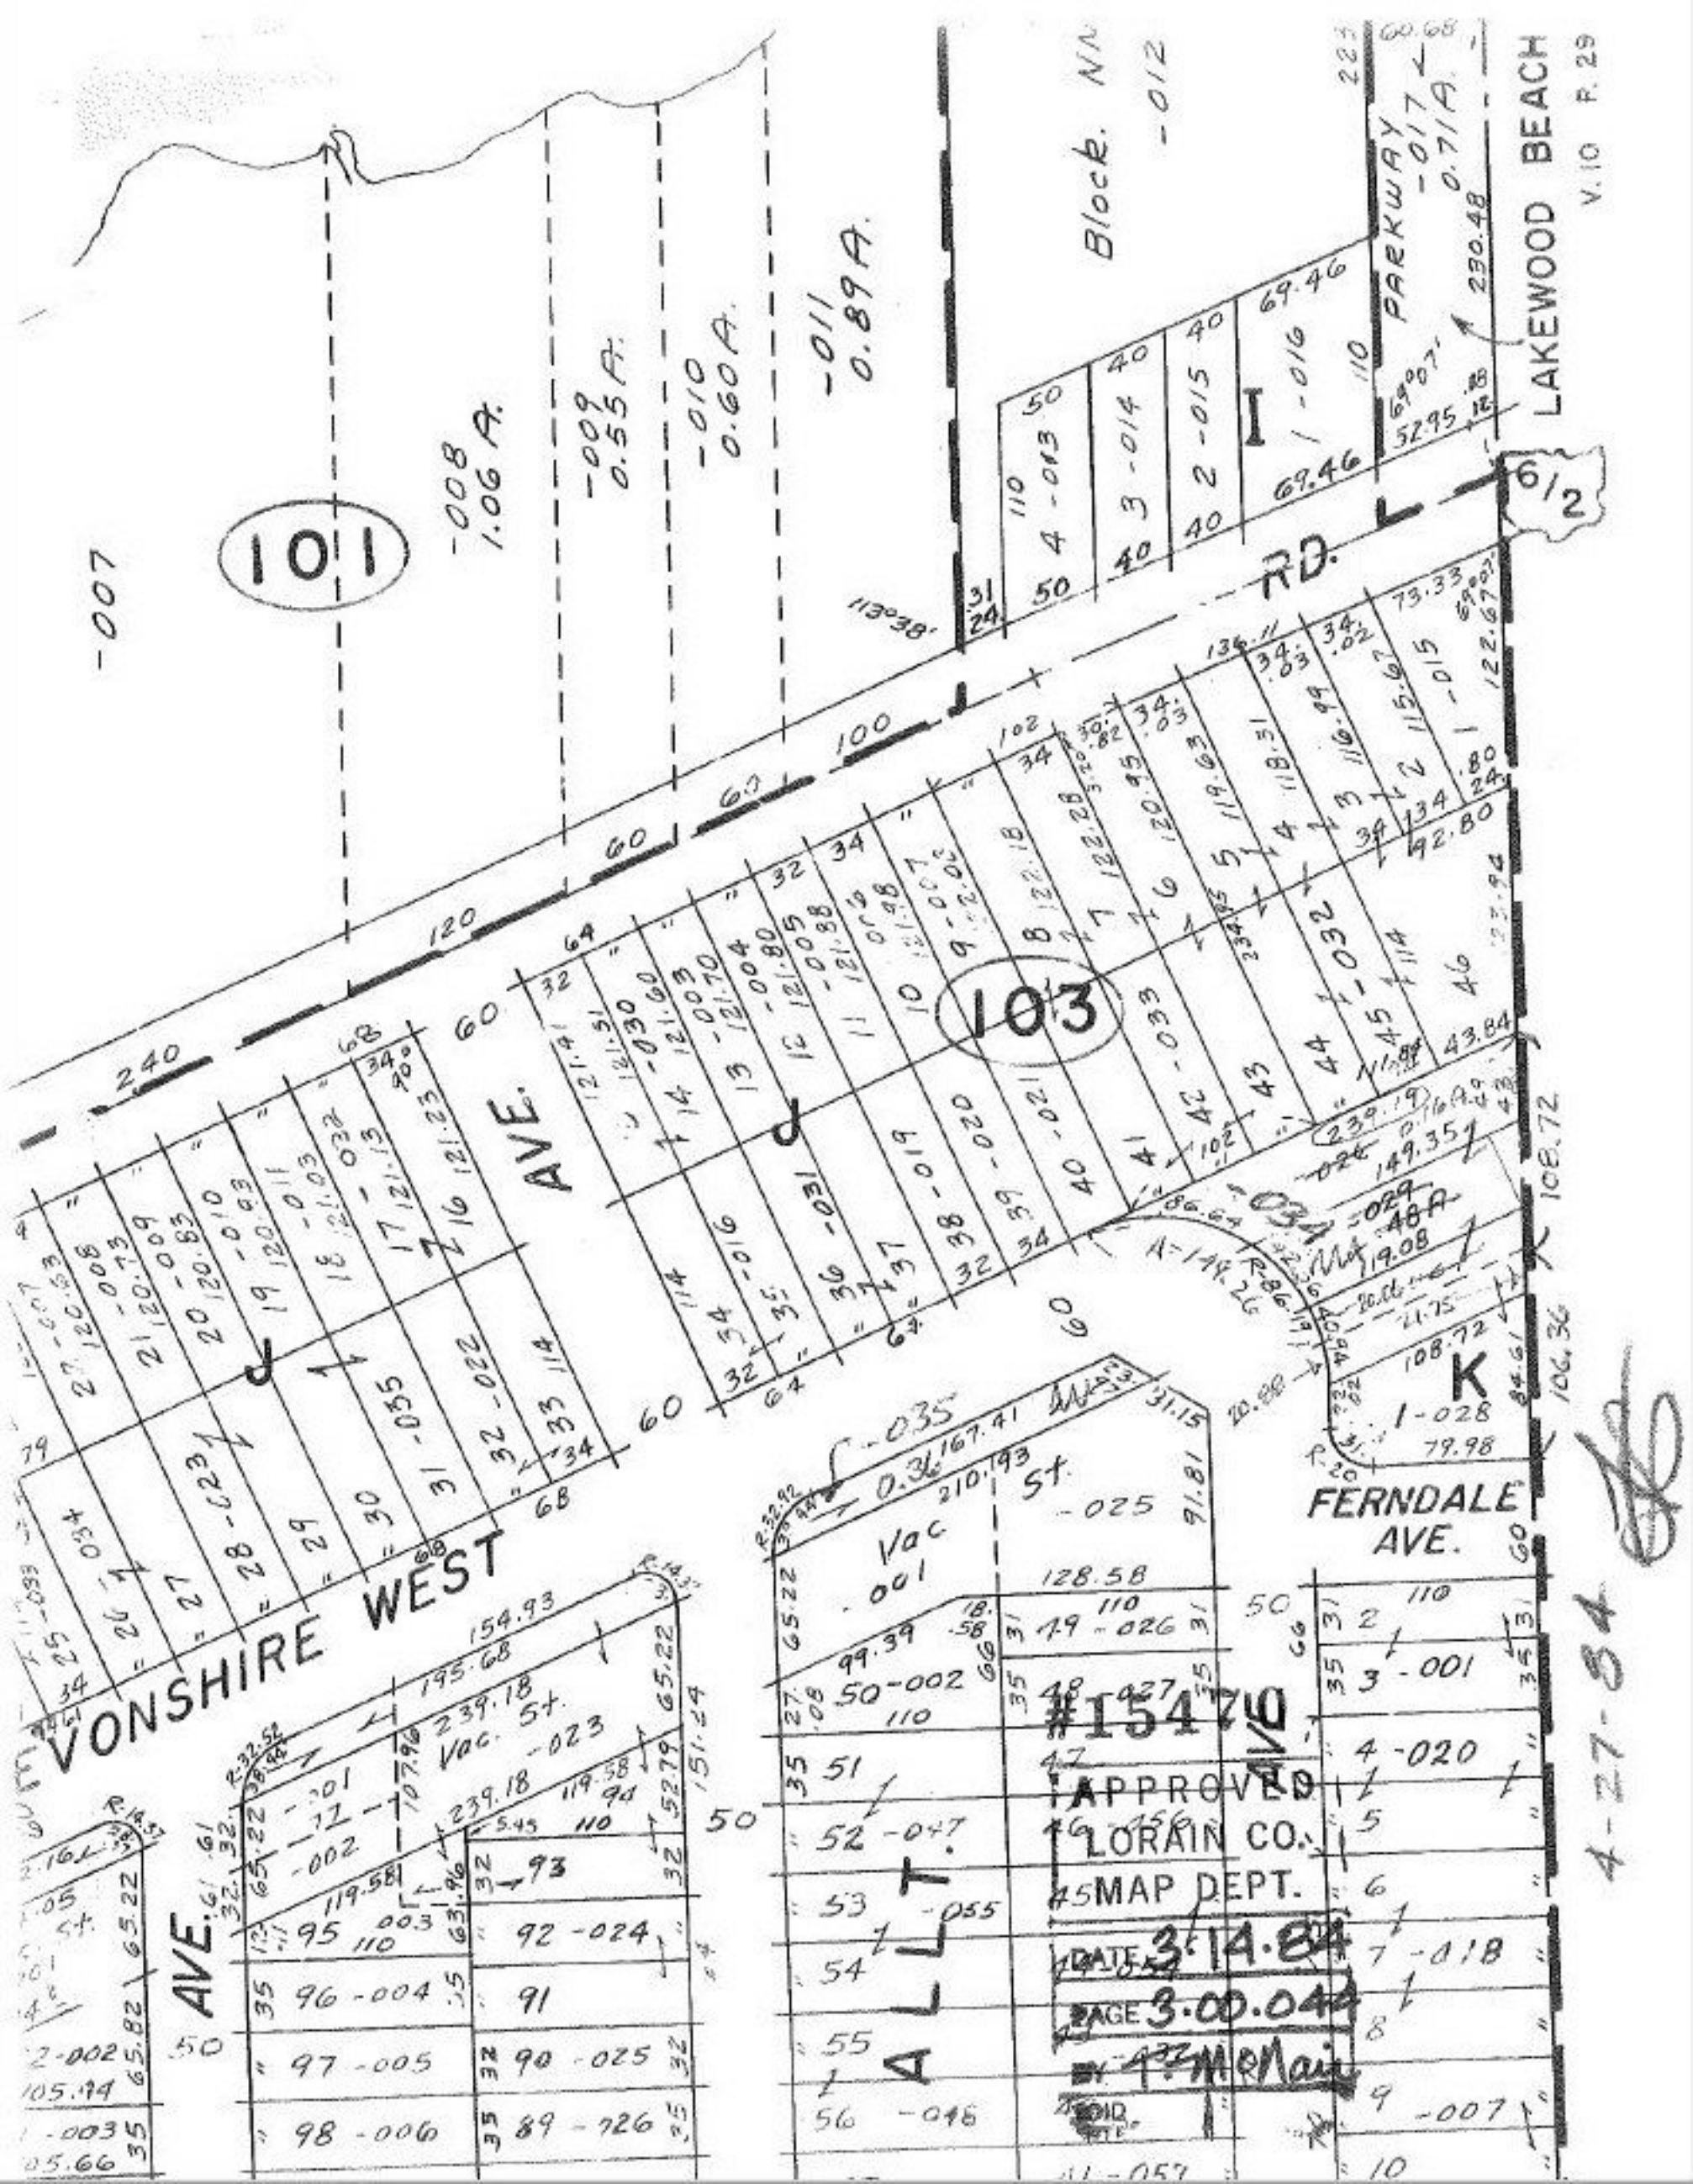

VONSHIRE WEST

AVE.

FERNDALE AVE.

103

#15470

APPROVED
LORAIN CO.
MAP DEPT.

DATE 3-14-84

PAGE 3-00-044

BY J. McNeil

4-27-84

[Signature]